



Memorandum

Foth Infrastructure & Environment, LLC
2121 Innovation Court, Suite 300
P.O. Box 5126 • De Pere, WI 54115-5126
(920) 497-2500 • Fax: (920) 497-8516
www.foth.com

May 9, 2018

TO: Pablo Valentin, U.S. Environmental Protection Agency
Beth Olson, Wisconsin Department of Natural Resources

CC: Jeff Lawson, Lower Fox River Remediation LLC
Sue O'Connell, Lower Fox River Remediation LLC
Bryan Heath, NCR Corporation
George Berken, Boldt Technical Services
Gary Kincaid, Wisconsin Department of Natural Resources
Denis Roznowski, Foth
Troy Gawronski, Foth

FR: Tara Van Hoof, Foth
Steve Lehrke, Foth

RE: Lower Fox River OU4 *COMMP* Cap Integrity Assessment - Year 2

Background

Lower Fox River Remediation LLC (LLC) retained Foth Infrastructure & Environment, LLC (Foth) to document the methodology employed for and the results of the Year 2 hydrographic survey in compliance with requirements of the *Lower Fox River Remedial Design Cap Operations, Maintenance, and Monitoring Plan (COMMP)* for the Lower Fox River Operable Units 2-5 (Anchor QEA and Tetra Tech EC, 2009), which was approved by the Agencies/Oversight Team (A/OT) on April 22, 2009. The *COMMP* describes post-placement cap monitoring activities that will be performed to provide a high level of assurance that the engineered caps retain their physical integrity and protectiveness over time. The *COMMP* also outlines contingency response actions that will be implemented if the engineered caps do not meet performance standards.

On June 29, 2011, the LLC met with representatives of the A/OT to discuss the *COMMP* and gain concurrence on the methods to be employed for monitoring of the engineered caps. Discussions during this meeting refined and clarified several items such as monitoring requirements and schedule. Meeting minutes for this meeting were drafted by Tetra Tech EC (TtEC) and accepted by the A/OT, on August 4, 2011, and were included as Attachment 1 in Foth's June 22, 2015 memorandum regarding "LFR OU4 *COMMP* Hydrographic Survey-Year Zero" (Foth, 2015) (herein referred to as the "Year 0 memo").

As part of the *COMMP* requirements for OU3-5, routine monitoring of all caps by geophysical methods (including sub-bottom profiling and/or hydrographic survey) will be completed at the agreed to frequency. Further, the *COMMP* states the first routine monitoring of completed engineered caps shall be completed 2 years post-construction (denoted as the “Year 2 survey”). This routine monitoring includes the completion of a hydrographic survey to analyze the top of engineered cap elevations and the change in that surface, if any, over time. In order to evaluate the change in top of cap elevation over time, a baseline or reference point needed to be established. Baseline cap elevations were established by completing a hydrographic survey of caps placed in OU4 in 2013-2014 following completion of construction, totaling approximately 52.3 acres. The hydrographic survey documenting the baseline conditions has been termed the “Year 0” survey. The locations of the 52.3 acres of capped areas in OU4 placed in 2013-2014 are illustrated on Figure 1.

To supplement the hydrographic surveys for determining if erosion of the armor layer over more than 5% of a cap certification unit (CCU) has occurred (a requirement of the *COMMP*), the cap areas are assessed using a poling/probing survey each time a routine (or river flow event-triggered) hydrographic survey is completed. The main objectives of the poling/probing survey is to determine if the armor stone layer is intact (i.e., present) and how much, if any, cap settlement and/or sediment deposition has occurred since placement of the caps. If the top of cap elevation has lowered since its original installation, but physical poling/probing confirms the armor stone remains present, it will be concluded that the sediment underlying the cap has consolidated causing the surface of the cap to subside rather than that the cap has eroded.

This memorandum presents the methods utilized and the results of comparing the Year 2 to the Year 0 hydrographic surveys, as well as of the Year 2 poling/probing survey for the 52.3 acres of caps placed in OU4 through 2014. In addition, integrating sediment deposition measurements into hydrographic survey elevation data, this memorandum compares the Year 0 and Year 2 top of cap elevations and assesses if more than 5% of any CCU has experienced erosion or other damage that will not allow it to function as designed.

Finally, this memorandum provides the results of an evaluation of the 20-year and 100-year recurrence-interval flow rates for OU4. The *COMMP* requires: “In addition to the scheduled monitoring of all capped areas in OU3-5, supplemental bathymetric surveys will be performed only in “sentinel” capping areas following major river-flow events...that may have a significant impact on river hydrodynamics...Sentinel cap area monitoring will be performed within 1 year following a river flow (combined flood and seiche discharge) event with a recurrence interval of 20 years or more...Hourly average flows exceeding the 20-year return-interval flow rate (i.e., 21,000 cfs for OU3 and 22,100 cfs for OU4) will be used to trigger the supplemental bathymetric surveys.” Furthermore, the *COMMP* requires: “If cap integrity and performance are verified under a 20-year flow event, follow-on event-based cap monitoring will occur following a

100-year flow event (e.g., 25,500 cfs for OU4).” Sentinel capping areas are described further in the *COMMP*.

In addition to the high flow-event based monitoring, the *COMMP* requires:

“Supplemental bathymetric surveys will also be performed within 1 year following major river construction events (e.g., new bridge construction) and/or within 1 year following the occurrence of low-water elevations (defined as the lowest monthly average within a given water year, April to March) that are more than 1 foot below the low-water elevations used to develop the cap designs (see Section 3.2 of the *COMMP*)...If cap integrity and performance are verified following water level conditions that are more than 1 foot below the design low-water elevation, follow-on event-based cap monitoring will occur following water level conditions that are more than 2 feet below the design low-water elevation (see Section 3.2 of the *COMMP*)... Lake Michigan water levels are currently measured at the National Oceanic and Atmospheric Administration (NOAA) gaging station near the mouth of Green Bay (Station No. 9087079). Annual low-water elevations (defined as the lowest monthly average within a given water year) from the NOAA gaging station will be assessed each April after typical annual low water periods between November and March. If the gage records indicate that the monthly average for any month during the previous water year (April to March) was more than 1 foot below the remedial design (RD) baseline water elevation (576.6 feet NAVD88 outside of the navigation channel and 577.6 feet NAVD88 in the navigation channel in OU 4), supplemental bathymetric surveying will be triggered for the following fall after the spring flood season and summer recreational boating season.”

The LLC has verified that, since April 2014, water levels in OU4 have not met these low level thresholds and therefore are not further discussed in this memorandum (refer to the table and graph provided in Attachment A).

Year 0 (2014) Hydrographic Survey

On November 13 and 14, 2014, J.F. Brennan Company (Brennan) completed hydrographic surveys of approximately 52.3 acres of engineered caps in OU4 in accordance with the *COMMP*. Foth audited Brennan’s surveys. Auditing reports for the completion of these surveys are included as Attachment 2 of Foth’s Year 0 memo (Foth, 2015).

The hydrographic survey data collected for the Year 0 cap monitoring indicated that the cap aggregates in place met the performance standards set forth in the *Lower Fox River Remedial Design 100% Design Report* (Tetra Tech et al., 2009) and the *COMMP*, and with one exception, no irregularities were identified. The exception was the isometric view for CA27AB (Figure 13B of the Year 0 memo). Linear irregularities were evident in the isometric view on the north east end of the cap. Foth investigated the potential causes for these linear irregularities and found that multiple pipelines used for dredging and/or spreading operations were traversing this cap area at the time of the survey data collection. The Year 0 surveys were accepted by A/OT to serve as the baseline for future surveys to assess long-term cap performance, as indicated and discussed in further detail in the Year 0 memo.

To supplement the Year 0 survey information, cap thickness verification data, prepared by TtEC (Attachment 3 of the Year 0 memo), was reviewed. These data indicate that when applying A/OT-approved statistical procedures (i.e., summary statistics), the minimum cap aggregate thicknesses were achieved in all cases when the caps were placed.

Year 2 (2016) Hydrographic Survey

The subsequent routine post-cap monitoring event, required by the *COMMP* (Year 2), was completed on October 18, 19, and 25, 2016 and December 1, 2016 over the 52.3 acres of engineered caps placed in OU4 during 2013 and 2014, following nearly identical protocols summarized for Year 0 above (variations from the Year 0 methods are noted) and as described in more detail in the remainder of this memorandum, as well as in the *COMMP*.

The vast majority of the caps are in areas with water depths of greater than 3 feet; therefore, a multi-beam survey system was utilized to provide a high degree of accuracy and coverage, with the exception of Cap Areas CBD23-27, CAD118, and CB33. Cap Areas CBD23-27, CAD118, and CB33 were surveyed on October 25, 2016 using single-beam survey technology due to the water being too shallow for multi-beam survey equipment. The multi-beam survey work was conducted using a 400 kilohertz (KHz) acoustical system and the single-beam work a 200 KHz system. All survey work was performed by Brennan and audited by Foth. The hydrographic survey audit forms are provided in Attachment B. The survey work, including survey control check-in and check-out procedures and hydrographic survey QC procedures, were carried out in compliance with the OU2-5 *Quality Assurance Project Plan* (TtEC, et al., 2016) and industry standards. The Foth auditor reviewed the results of the performance and patch tests for compliance with hydrographic survey specifications and industry standards. Foth obtained raw survey files and gridded survey files (2 feet x 2 feet) from Brennan in a format consistent with the 2014 Year 0 survey of the same area. The Year 2 survey information was processed and plotted by Foth for visual review to identify failing or damaged cap areas.

Results from the Year 2 hydrographic survey have been compared to the baseline (Year 0) to assess integrity of the caps, which is discussed below in the Cap Integrity Assessment section.

Poling/Probing Evaluation

To better compare elevation changes in the capped surface over time, Foth collected poling/probing measurements to determine if and to what extent sediment deposition occurred between Year 0 and Year 2. When sediment deposition thickness was measured, the presence of the armor layer was also verified by poling through sediment, if present, and “feeling” the armor layer with the poling rod (probing).

Statistical Determination of Poling/probing Locations

The appropriate number of poling/probing locations to be occupied is determined using statistical confidence limits with a lower 95% confidence limit targeted as described in the following paragraph. This methodology was previously presented in the November 1, 2016 memorandum *Lower Fox River OU2-5 - OU4 COMMP Armored Cap Poling/ Probing for Evaluation of Caps Placed 2013-2014* (Foth, 2016) and accepted by the A/OT via email correspondence on November 2, 2016.

As a means of providing statistical confidence in the cap integrity evaluation, a minimum of 60 poling/probing locations were selected. Assuming that the armor layer is observed at all 60 locations, this number of monitoring points provides 95% statistical confidence that a minimum 95% proportion of the cap has maintained integrity (as measured by the armoring layer of the cap being present). Specifically, when all 60 locations (100% proportion) indicate armor integrity, a lower statistical confidence limit (exact binomial) can be calculated on this proportion (Conover, 1999) as follows:

The lower 95% confidence limit on the observed 100% proportion is found by selecting the largest proportion (p_1) such that:

$$P(Y \geq y | p = p_1) = \alpha = \sum_{i=60}^{60} \binom{60}{60} p_1^{60} (1 - p_1)^{60-60} = p_1^{60} \leq 0.05.$$

Solving the above (for p_1) results in a lower confidence limit of $0.951 \approx 0.95$. This implies there is 95% confidence that a minimum 95% proportion of the cap area has maintained integrity.

In addition to the poling/probing's providing confidence that the armored cap is present, the sediment thickness measurements at each of the 60 locations can be used to determine the thickness of sediment across the capped areas and be factored into isopach drawings depicting the change in cap elevation over time.

Using the base number of 60 poling/probing locations, a 170-foot grid was used to locate the 60 poling/probing locations within the cap areas. Based on previous A/OT review comments and experience in OU3 (*Lower Fox River OU3 COMMP Cap Integrity Assessment - Year 3* [Foth, 2015]), poling/probing locations were added to the OU4 Year 2 locations, more specifically in the smaller cap areas, to provide more complete coverage within the cap areas. Some of the poling/probing locations also needed slight adjustment from the exact 170-foot grid coordinates so that they fell within a 10-foot buffer inside the CCU areas. Location additions and slight adjustments were also made to provide coverage of areas with discernible increases (i.e., deposition) or decreases in elevation (i.e., depressions, gullies, etc.). Ninety-nine (99) poling locations were added for the purposes described above; therefore, the total number of proposed poling/probing locations was 159. Poling/probing locations are provided on Figures 2C through 14C (i.e., Figures 3C, 4C, 5C, etc.).

Poling/Probing Survey – Deposition Measurements

On November 3 and 4, 2016, Foth performed deposition measurements within the 52.3-acre capped areas utilizing a Foth vessel equipped with real-time kinematic global positioning system (RTK GPS). At each of the 159 poling/probing locations, while hovering with the sampling vessel, top of sediment elevation was determined with a graduated pole fitted with a 6-inch diameter disc. At the same locations, a probing rod with 1-inch diameter probing tip was advanced until armor stone was encountered, and the elevation of the top of armor stone was determined. Thickness of sediment deposition above the caps was then determined at each location. Field observations were recorded in field activity observation reports, which are included in Attachment B. Table 1, in Attachment B, presents the poling/probing data. Note that the sediment thicknesses shown in the table are the exact measurements recorded in the field; however, the rocky surface should be considered in that the water elevation is measured using a 6-inch diameter disc, which sits on top of the surface, whereas the sediment thickness is measured using 1-inch diameter poling rod, which can fit within cracks and spaces in the rocky surface (particularly apparent in areas of quarry spall placement). Table 1 identifies locations in which the presence of soft sediment deposition was obvious (e.g., P8 and P11), indicated by “sog” or “sor” (i.e., soft over gravel or soft over rock, respectively).

The poling/probing survey indicated that armor stone or quarry spall was present at each of the 159 locations visited. Note that P108 was inadvertently placed within the 10-foot buffer and poling/probing indicated soft material; therefore, poling/probing was performed at two additional locations, offset from the original location outside of the 10-foot buffer within the cap limits, to confirm the presence of armor stone. With the 159 selected locations, all having armor stone present, there is greater than 95% statistical confidence that a minimum 95% proportion of the cap has maintained integrity. In fact, the confidence level approaches 99%. Furthermore, poling/probing measurements indicate that several of the evaluated cap areas have accumulated sediment (depositional areas) over the two year time period evaluated, particularly in the Cap Area of CB39 and surrounding area in CB39-1-1. Deposition in this area is expected due to the decrease in river flow caused by widening of the river channel below the De Pere Dam, creating slack water. Other areas containing deposited sediment, but to a lesser extent, include the following:

- ◆ CB6-1-1: along the shoreline, at the toe of slope along the border of CB6-1-1 and D24-RDMU1, and in a depression along the northern edge of CB6-1-1 (as shown on Figures 3B, 3C, and 3D).
- ◆ CAD118: at the toe of slope near the west edge (as shown on Figures 6B, 6C, and 6D).
- ◆ CB45-1/CA24B-1/CB45-2: at the toe of slope where the border of the three areas meet (as shown on Figures 10B, 10C, and 10D).

Accumulation of sediment is anticipated in these types of environments. The poling/probing information was integrated into the cap integrity assessment, as discussed below.

Cap Integrity Assessment by CCU (Comparison of Year 0 and Year 2 Surveys)

Upon completion of the Year 0 and Year 2 hydrographic surveys, the data were processed and top of cap contours were created. A set of figures were prepared for visual review to identify failing or damaged cap areas. Figure 1 illustrates the 2013-2014 cap placement areas totaling approximately 52.3 acres in OU4. Figures 2 through 14 illustrate the top of cap elevations for the 2016 Year 2 survey and the elevation differences between the 2014 and 2016 surveys. Each figure set includes an “A” figure, which depicts the top of cap elevations; a “B” figure, which depicts the top of cap elevations in a three-dimensional isometric view (as an added visual aid to assess cap integrity); and a “C” figure, which depicts the 2014 and 2016 differences in elevation (isopachs). For some cap areas, “D” series figures were added to offer cross sections to better depict anomalous conditions.

In viewing the approximate 52.3 acres of capped areas placed in OU4 in 2013-2014, there are several areas of interest as described below:

- ◆ General elevation decreases 0.0-0.5’ between the 2014 and 2016 surveys are noted throughout the OU4 cap areas. This decrease in elevation of the top of the caps is likely the result of consolidation of the underlying soft sediment, which is expected given the short duration since completion of capping activities.
- ◆ Two triangular-shaped depression areas are visible in the mudline elevations in CBD23-1 (Figure 2B). No abrupt change in elevation is found, however, when comparing to the isopach difference figure (Figure 2C). Therefore, the depressed areas on Figure 2B are likely a reflection of the river bottom topography. In addition, the poling/probing evaluation confirms the existence of armor stone in these areas.
- ◆ The isopach difference (Figure 2C) indicates that the 2016 survey is higher than the 2014 survey by 1.0-2.0’ in a large portion of CB39 and the surrounding areas in CB39-1-1. Poling/probing measurements confirm that deposition of sediment has occurred in these areas of a similar magnitude as that indicated in the survey, as shown on Figure 2C. The poling/probing evaluation determined soft sediment exists over the cap armor stone.
- ◆ A depression area is visible in the mudline elevations along the northern edge of CB6-1-1 (Figure 3B). No abrupt change in elevation is found, however, with this area when viewing the same areas in the isopach difference figure (Figure 3C). Therefore, the depressed area on Figure 3B is likely a reflection of the river bottom topography. To further confirm the integrity of the cap in this area, a cross-section was cut through the depressed area (Figure 3D). The 2014 and 2016 surveys follow a similar contour confirming that the depressed area on Figure 3B

is a reflection of the river bottom topography. In addition, the poling/probing evaluation confirms the existence of armor stone in these areas.

- ◆ The 2016 top of cap elevations in D24-RDMU1 (Figure 3B) appear highly irregular. No abrupt change in elevation is found, however, when comparing to the isopach difference figure (Figure 3C). To further confirm the integrity of the cap, a cross-section was cut through the area (Figure 3D). The 2014 and 2016 surveys follow a similar contour confirming that the irregularity seen on Figure 3B is a reflection of the river bottom topography. In addition, the poling/probing evaluation confirms the existence of armor stone in these areas.
- ◆ Caps containing small depressed areas in which the 2016 top of cap elevation was 0.5-1.0' lower than the 2014 top of cap elevation were prevalent, and due to the isolated occurrences and locations of the depressed areas within the caps, integrity of these caps is not anticipated to be a concern. However, caps with a large portion of the area lower in elevation by 0.5-1.0', as in CC9, required additional evaluation.

The soft sediment underlying Cap CC9 are expected to consolidate more in response to the additional loading of quarry spall and overall thickness of the C-cap. To confirm the integrity of the cap in this area, a cross-section was cut through CC9 (Figure 3D). The 2014 and 2016 surveys follow a similar contour indicating that the depression is likely due to consolidation of the underlying soft sediment. In addition, the poling/probing evaluation confirms the presence of the armor rock.

- ◆ The top of cap elevations along the southern edge of CBD23-27 (Figure 4B) dips toward the south; however, the isopach difference (Figure 4C) indicates that the 2016 elevations are higher than the 2014 elevations by 0.5-1.5'. Therefore, this area reflects a depositional location. The poling/probing evaluation determined soft sediment exists over the cap armor stone.
- ◆ The isometric view for the top of cap elevations for CAD118 and the portion of CB30 east of CAD118 (Figure 6B) appeared irregular; therefore, a cross-section was cut through these areas (Figure 6D) to confirm cap integrity. The isopach difference (Figure 6C) did not show similar irregularities and the 2014 and 2016 surveys follow similar and parallel contours indicating that the irregularity is likely a reflection of the river bottom topography and consolidation of the underlying soft sediment. In addition, the poling/probing evaluation confirms the existence of armor stone in these areas.
- ◆ The isometric view for the top of cap elevations for CB33 (Figure 9B) appeared irregular and several depressed areas 0.5-1.5' were apparent in the isopach difference (Figure 9C); therefore, a cross-section was cut through the area (Figure 9D) to confirm cap integrity. The 2014 and 2016 surveys follow similar and parallel contours indicating that the irregularity is likely a reflection of the

river bottom topography and consolidation of the underlying soft sediment. In addition, the poling/probing evaluation confirms the existence of armor stone in these areas.

- ◆ Similar to CC9, contiguous cap areas CB45-1, CB45-2, and CA23A-1 (Figure 10C), as well as CB45-3 and the eastern portion of CA24B-2 (Figure 11C), contained relatively large areas in which the 2016 survey was lower than the 2014 survey by 0.5-1.0'. To confirm cap integrity, a cross-section was cut through CB45-1 as a representative section for these areas (Figure 10D). The 2014 and 2016 surveys follow a similar contour, though the 2016 survey is lower throughout CB45-1, indicating that the depressed areas are likely due to consolidation of underlying soft sediment. In addition, the poling/probing evaluation confirms the presence of the armor stone in these areas.

An accounting of evaluations and recommendations made during each post-cap monitoring event for each cap area is provided in Table 1.

The following section further addresses measured decreases in the elevation of the tops of caps and a statistical evaluation of cap elevation changes over time.

Statistical Evaluation of Survey Differences by CCU

In order to further quantify the observed differences between the 2014 and 2016 survey elevations, data sets of elevation differences, along a 5-foot by 5-foot grid, were generated and evaluated through statistical box plots for each CCU. These distributions are illustrated on Figures 15A, 15B and 15C. The data were generated by subtracting the 2014 elevation from the 2016 elevation at each 5-foot by 5-foot grid node. Positive values reflect elevations which are higher in 2016 than 2014, while negative values reflect elevations which are lower in 2016 than in 2014.

The boxplots on Figures 15A through 15C for each cap area are shown in order from upstream to downstream. In the boxplots, the grey box represents the 25th to 75th percentiles (quartiles), with the whiskers reaching to the minimum and maximum data points, or to the quartiles plus/minus 1.5 times the inner quartile range (IQR), whichever is first. Asterisks denote outliers past 1.5 times the IQR, and circles denote outliers past 3 times the IQR. The mean of the data is represented by a blue diamond and the median by a solid black line.

The majority of CCUs are seen on Figures 15A through 15C to have survey differences which are lower on average by 0 to 0.5 feet in 2016 than in 2014. This matches the general observations made above for the cap integrity assessment. The only area which has an average decrease of over 0.5 feet is for CC9 (Cap Type C with quarry spall) with an average decrease in cap elevation of 0.51 feet, likely due to the increased weight of the capping materials).

Of interest in the data sets are the 5th percentiles for each CCU, since this is the value that will be exceeded by 95% of the data. If 95% of the data fall above a desired threshold

value, further evidence is provided that cap integrity is maintained for 95% of the CCU area.

The 5th percentile for each CCU on Figures 15A through 15C is indicated by a solid gold line. For comparison, the solid blue line indicates the combined vertical error estimate of the 2016 and 2014 surveys based on equipment manufacturer information. The vertical accuracy for the 400 kHz multi-beam sonar is ± 0.2 to 0.3 feet, and the vertical accuracy of the 200 kHz single beam sonar is ± 0.1 to 0.2 feet. Assuming a 0.25 foot accuracy for the multi-beam survey, the propagation of errors formula $\sqrt{(\text{Error}_{\text{Survey1}}^2 + \text{Error}_{\text{Survey2}}^2)}$ would predict the differential accuracy to be approximately 0.35 feet.

The 5th percentile of the data (Figures 15A through 15C gold line) extends past the combined vertical survey accuracy (blue line) for CBD23-1, CB6-1-1, CC9, CB30, CAD118, CA80A-1, CA80B-1, CB43, CB33, CB45-1, CA23A-1, CB45-2, CB45-3, CA24B-2, CA24C, CA27AB, CB89A and CA89B. Therefore, potentially more than 5% of the area for these CCUs has experienced an elevation decrease from 2014 to 2016 which exceeds the combined survey vertical accuracy. As noted above, however, physical poling/probing confirmed in 2016 that armor stone remains intact at all locations visited, and therefore, it is assumed that the underlying soft sediment has consolidated resulting in settlement of the surface of the cap rather than the cap having been eroded.

As a note, several areas depicted increases in average elevation from 2014 to 2016. These are CB39, CB39-1-1, CBD23-27, CB11A-1 and CA24D. Of these, the largest elevation increase clearly occurred in CB39 and the surrounding area in CB39-1-1, with a median increase of 1.22 feet in CB39. The poling/probing survey confirmed that the increase in elevation in CB39 and CB39-1-1 is due to sediment deposition. As stated above, deposition in this area is expected due to the decrease in river flow caused by widening of the river channel downstream of the De Pere Dam. The average elevation increase for CBD23-27, CB11A-1 and CA24D was much less (0.15 feet or less) with the existence of sediment not confirmed with the discrete poling/probing locations.

20- and 100-Year Flow Rate Evaluation

Foth performed an evaluation of the 20-year recurrence-interval flow rate for the period between the Year 0 and Year 2 surveys. The *COMMP* requires: “In addition to the scheduled monitoring of all capped areas in OU3-5, supplemental bathymetric surveys will be performed only in “sentinel” capping areas following major river-flow events...that may have a significant impact on river hydrodynamics...Sentinel cap area monitoring will be performed within 1 year following a river flow (combined flood and seiche discharge) event with a recurrence interval of 20 years or more...Hourly average flows exceeding the 20-year return-interval flow rate (i.e., 21,000 cfs for OU3 and 22,100 cfs for OU4) will be used to trigger the supplemental bathymetric surveys. If cap integrity and performance are verified under a 20-year flow event, follow-on event-based cap monitoring will occur following a 100-year flow event (e.g., 24,200 cfs for OU3 and 25,500 cfs for OU4; subject to future updates).” (Refer to the *COMMP* for more details regarding the calculation of the recurrence interval flow values.)

Flows near the mouth of the Fox River (including the combined effects of upstream floods and seiches) are measured approximately every 5 minutes at the U.S. Oil Tank Depot (USGS Station 040851385) (<http://waterdata.usgs.gov/nwis/>), which is the gauging station used for comparison of flow data to the appropriate recurrence intervals for OU4. Figure 1, in Attachment C, presents the 2014-2016 hourly moving averages as compared to the OU4 20-year and 100-year recurrence intervals. Using the hourly data for comparison (as required by the *COMMP*), the 20-year and the 100-year recurrence intervals were exceeded for OU4 during several time frames, as shown in the table and on the figure in Attachment C. The 20-year recurrence interval was first exceeded on April 18, 2015, and the 100-year recurrence interval was first exceeded on June 8, 2015. To further evaluate if at a minimum a 20-year flow event had occurred, the USGS mean daily discharge data were also reviewed, which showed a value of 21,700 cfs on December 14, 2015. This mean daily discharge further substantiates that a 20-year flow event likely occurred between the Year 0 and Year 2 surveys (data shown on the USGS figure in Attachment C).

Based on the requirements described above, sentinel cap area monitoring would have been required in OU4 in 2016. Because the routine Year 2 evaluation was also required in 2016, the LLC is proposing that this routine Year 2 evaluation also be used as the event-based monitoring for 20-year and 100-year flow events, noting that the evaluation is more comprehensive than required given that the evaluation covers all 52.3 acres, rather than just sentinel cap areas. Sentinel caps have not yet been identified for OU3 or OU4, but that effort is underway by the LLC and will be proposed to A/OT during the first quarter of 2017.

As a point of reference, due to the close proximity of the events, the A/OT also allowed use of the OU1 2011 5-year flow-event cap assessment to address the OU1 2012 routine cap monitoring event; for further detail refer to the April 19, 2013 memorandum *Lower Fox River OU1 Cap Monitoring Maintenance Plan 5-Year Flow Hydrographic Survey Comparison* (Foth, 2013).

Conclusions

Based upon the results of the Year 0 to Year 2 hydrographic survey comparison, the following conclusions can be made:

1. Results of the comparison of the Year 0 and Year 2 hydrographic surveys showed general cap settling, which resulted from consolidation of the underlying soft sediment, particularly in areas CC9, CB6-1-1, CB30, CB43, CB-33, CB45-1, CA23A-1, CA27AB, and CB89A. The poling/probing survey completed in all of these areas confirmed that the armor stone (quarry spall in the case off CC9) is present at all locations measured. The results of this survey provide high confidence (exceeding 95%) that the placed armored caps are present and performing as designed. Further, the identified settlement resulting from the consolidation of the underlying soft sediment for the OU4 caps is similar to the observed consolidation at the OU3 site.

2. Deposition (identified as an increase in top of cap elevation in 2016 over 2014) was noted in scattered areas throughout the cap regions, particularly in Cap Area CB39 and surrounding area in CB39-1-1. Deposition in this area is expected due to the decrease in river flow caused by the widening of the river channel downstream of the De Pere Dam. Less substantial deposition occurred in areas in which deposition would be expected, including along the shoreline, at the toe of slope, and in depressions.
3. A direct comparison of the 2014 and 2016 hydrographic surveys indicates there are several CCUs for which greater than 5% of the area has decreased in elevation, beyond the range of the combined survey vertical uncertainty level. This is the case for CBD23-1, CB6-1-1, CC9, CB30, CAD118, CA80A-1, CA80B-1, CB43, CB33, CB45-1, CA23A-1, CB45-2, CB45-3, CA24B-2, CA24C, CA27AB, CB89A and CA89B. Physical poling/probing confirmed the armor stone remains present. Settling of the top elevation of these caps is therefore attributed to consolidation of the underlying soft sediment.
4. Implementation of the Year 0 to Year 2 cap monitoring in OU4 indicates that the 52.3 areas of OU4 caps have remained in place, consistent with their design. Following completion of the 2016 cap monitoring, there is no indication of need for additional investigation of the integrity of the caps or for repair.
5. Based on the available flow data from the USGS for the Fox River, OU4, we conclude that both the 20-year and 100-year flow values occurred in 2015, triggering a flow-event assessment of caps in OU4. The Year 2 evaluation confirmed that caps placed during 2013-2014 in OU4 remained intact and are functioning as designed following these events.

As stated in the COMMP, “If cap integrity and performance are verified under a 20-year flow event, follow-on event-based cap monitoring will occur following a 100-year flow event (e.g., 25,500 cfs for OU4).”

6. The LLC anticipates working collaboratively with the A/OT during the first quarter of 2017 to establish sentinel cap areas to be monitored during flow-induced *COMMP* events.

Since the caps placed in OU4 during 2013-2014 have remained in place, consistent with their design, following occurrences of both 20 and 100-year flow events, the LLC will only perform future flow-event based monitoring of sentinel caps following 100-year flow events, consistent with *COMMP* requirements.

7. Based on the *COMMP* schedule established by the A/OT, the next routine cap monitoring survey for caps placed in 2013-2014 in OU4 (Year 4) will occur in 2018.

8. Based on the *COMMP* schedule established by the A/OT, the next routine cap monitoring survey for caps placed in 2015-2017 in OU4 (Year 0) will occur in 2017.
9. Based on the *COMMP* schedule established by the A/OT, the next routine cap monitoring survey for caps placed in OU3 (Year 7) will occur in 2018.

References

- Anchor QEA, LLC and Tetra Tech EC, Inc., 2009. *Lower Fox River Remedial Design Cap Operations, Maintenance, and Monitoring Plan*. Prepared for Appleton Papers Inc., Georgia-Pacific Consumer Products LP, and NCR Corporation. April 2009.
- Conover, W.J, 1999. *Practical Nonparametric Statistics, Third Edition*. John Wiley & Sons, Inc., New York.
- Foth Infrastructure & Environment, LLC, 2010. *Lower Fox River OUI Cap Monitoring Maintenance Plan - Hydrographic Survey Comparison - 455 kHz vs. 200 kHz Multi-Beam Bias* (Nov. 2010). Foth technical memorandum dated November 2010.
- Foth Infrastructure & Environment, LLC, 2013. *Lower Fox River OUI Cap Monitoring Maintenance Plan 5-Year Flow Hydrographic Survey Comparison*. Foth memorandum dated April 19, 2013.
- Foth Infrastructure & Environment, LLC, 2015. *Lower Fox River OU3 COMMP Cap Integrity Assessment - Year 3*. Foth memorandum dated April 1, 2015.
- Foth Infrastructure & Environment, LLC, 2015. *LFR OU4 COMMP Hydrographic Survey-Year Zero*. Foth memorandum dated June 22, 2015.
- Tetra Tech EC, Inc.; Anchor Environmental, L.L.C.; J.F. Brennan Company, Inc.; and Boskalis Dolman, 2009. *Lower Fox River Remedial Design 100 Percent Design Report*, Volume 1. Prepared for Appleton Papers Inc., Georgia-Pacific Consumer products LP, and NCR Corporation. April 2009.
- Tetra Tech EC, Inc.; Anchor Environmental, L.L.C.; J.F. Brennan Company, Inc.; and Stuyvesant Projects Realization Inc. (formerly Stuyvesant Dredging Inc., a subsidiary of Boskalis Dolman bv), 2016. *Quality Assurance Project Plan for Remedial Action of Operable Units 2, 3, 4, and 5 Lower Fox River and Green Bay Site, Revision 2*. July 2016.
- National Oceanic and Atmospheric Administration (NOAA), 2016. NOAA/NOS/CO-OPS Observed Water Levels at 9087079, Green Bay, WI. Retrieved December 19, 2016, from <https://www.co-ops.nos.noaa.gov/waterlevels.html?id=9087079>
- U.S. Geological Survey, 2016. USGS Surface-Water Historical Instantaneous Data for the Nation. Retrieved November 30, 2016, from <http://waterdata.usgs.gov/nwis/>

Table

**Table 1
Upper OU4 COMMP Cap Integrity Assessment History**

Location	Area (Acres)	Year Cap Completed	Routine Monitoring Event	Evaluation	Recommendation	Follow-up Action
CBD23-1047	0.47	2013	Year 0 (2014)	No irregularities noted.	Cap maintenance not required.	N/A
			Year 2 (2016)	No irregularities noted.	Cap maintenance not required.	N/A
CB023-1	0.49	2014	Year 0 (2014)	No irregularities noted.	Cap maintenance not required.	N/A
			Year 2 (2016)	Two triangular-shaped depression areas are visible in the mudline elevations in CB023-1 (Figure 2B). No abrupt change in elevation is found, however, when comparing to the isopach difference figure (Figure 2C). Therefore, the depressed areas on Figure 2B are likely a reflection of the river bottom topography. In addition, the piling/probing evaluation confirms the existence of armor stone in these areas.	Cap maintenance not required.	N/A
CB39-1-1/CB39	5.65	2013	Year 0 (2014)	No irregularities noted.	Cap maintenance not required.	N/A
			Year 2 (2016)	The isopach difference (Figure 2C) indicates that the 2016 survey is higher than the 2014 survey by 1.0-2.0' in a large portion of CB39 and the surrounding areas in CB39-1-1. Piling/probing measurements confirm that deposition of sediment has occurred in these areas of a similar magnitude as that indicated in the survey, as shown on Figure 2C. The piling/probing evaluation determined soft sediment exists over the cap armor stone.	Cap maintenance not required.	N/A
D24-RDMU1	2.06	2013	Year 0 (2014)	No irregularities noted.	Cap maintenance not required.	N/A
			Year 2 (2016)	The 2016 top of cap elevations in D24-RDMU1 (Figure 3B) appear highly irregular. No abrupt change in elevation is found, however, when comparing to the isopach difference figure (Figure 3C). To further confirm the integrity of the cap, a cross-section was cut through the area (Figure 3D). The 2014 and 2016 surveys follow a similar contour confirming that the irregularity seen on Figure 3B is a reflection of the river bottom topography. In addition, the piling/probing evaluation confirms the existence of armor stone in these areas.	Cap maintenance not required.	N/A
D24-RCMU3	0.39	2013	Year 0 (2014)	No irregularities noted.	Cap maintenance not required.	N/A
			Year 2 (2016)	No irregularities noted.	Cap maintenance not required.	N/A
CC9	0.48	2014	Year 0 (2014)	No irregularities noted.	Cap maintenance not required.	N/A
			Year 2 (2016)	Caps containing small depressed areas in which the 2016 top of cap elevation was 0.5-1.0' lower than the 2014 top of cap elevation were prevalent, and due to the isolated occurrences and locations of the depressed areas within the caps, integrity of these caps is not anticipated to be a concern. However, caps with a large portion of the area lower in elevation by 0.5-1.0', as in CC9, required additional evaluation. The soft sediment underlying Cap CC9 are expected to consolidate more in response to the additional loading of quarry spall and overall thickness of the C-cap. To confirm the integrity of the cap in this area, a cross-section was cut through CC9 (Figure 3D). The 2014 and 2016 surveys follow a similar contour indicating that the depression is likely due to consolidation of the underlying soft sediment. In addition, the piling/probing evaluation confirms the presence of the armor rock.	Cap maintenance not required.	N/A
CFIK-007	0.08	2013	Year 0 (2014)	No irregularities noted.	Cap maintenance not required.	N/A
			Year 2 (2016)	No irregularities noted.	Cap maintenance not required.	N/A
CB6-1-1	4.28	2013	Year 0 (2014)	No irregularities noted.	Cap maintenance not required.	N/A
			Year 2 (2016)	A depression area is visible in the mudline elevations along the northern edge of CB6-1-1 (Figure 3B). No abrupt change in elevation is found, however, with this area when viewing the same areas in the isopach difference figure (Figure 3C). Therefore, the depressed area on Figure 3B is likely a reflection of the river bottom topography. To further confirm the integrity of the cap in this area, a cross-section was cut through the depressed area (Figure 3D). The 2014 and 2016 surveys follow a similar contour confirming that the depression area on Figure 3B is a reflection of the river bottom topography. In addition, the piling/probing evaluation confirms the existence of armor stone in these areas.	Cap maintenance not required.	N/A
CB023-27	0.46	2014	Year 0 (2014)	No irregularities noted.	Cap maintenance not required.	N/A
			Year 2 (2016)	The top of cap elevations along the southern edge of CB023-27 (Figure 4B) dips toward the south; however, the isopach difference (Figure 4C) indicates that the 2016 elevations are higher than the 2014 elevations by 0.5-1.5'. Therefore, this area reflects a depositional location. The piling/probing evaluation determined soft sediment exists over the cap armor stone.	Cap maintenance not required.	N/A

**Table 1
Upper OU4 COMMP Cap Integrity Assessment History**

Location	Area (Acres)	Year Cap Completed	Routine Monitoring Event	Evaluation	Recommendation	Follow-up Action
CB023-34	0.71	2014	Year 0 (2014)	No irregularities noted.	Cap maintenance not required.	N/A
			Year 2 (2016)	No irregularities noted.	Cap maintenance not required.	N/A
CB40-1	0.14	2014	Year 0 (2014)	No irregularities noted.	Cap maintenance not required.	N/A
			Year 2 (2016)	No irregularities noted.	Cap maintenance not required.	N/A
CA61A-1	0.33	2014	Year 0 (2014)	No irregularities noted.	Cap maintenance not required.	N/A
			Year 2 (2016)	No irregularities noted.	Cap maintenance not required.	N/A
CA61C-1	0.12	2014	Year 0 (2014)	No irregularities noted.	Cap maintenance not required.	N/A
			Year 2 (2016)	No irregularities noted.	Cap maintenance not required.	N/A
CA61D-1	0.08	2014	Year 0 (2014)	No irregularities noted.	Cap maintenance not required.	N/A
			Year 2 (2016)	No irregularities noted.	Cap maintenance not required.	N/A
CB30	5.88	2014	Year 0 (2014)	No irregularities noted.	Cap maintenance not required.	N/A
			Year 2 (2016)	No irregularities noted.	Cap maintenance not required.	N/A
CA87	0.23	2014	Year 0 (2014)	No irregularities noted.	Cap maintenance not required.	N/A
			Year 2 (2016)	No irregularities noted.	Cap maintenance not required.	N/A
CAD118	0.41	2014	Year 0 (2014)	No irregularities noted.	Cap maintenance not required.	N/A
			Year 2 (2016)	The isometric view for the top of cap elevations for CAD118 and the portion of CB30 east of CAD118 (Figure 6B) appeared irregular; therefore, a cross-section was cut through these areas (Figure 6D) to confirm cap integrity. The isopach difference (Figure 6C) did not show similar irregularities and the 2014 and 2016 surveys follow similar and parallel contours indicating that the irregularity is likely a reflection of the river bottom topography and consolidation of the underlying soft sediment. In addition, the piling/probing evaluation confirms the existence of armor stone in these areas.	Cap maintenance not required.	N/A
CA80A-1	0.15	2014	Year 0 (2014)	No irregularities noted.	Cap maintenance not required.	N/A
			Year 2 (2016)	No irregularities noted.	Cap maintenance not required.	N/A
CA80B-1	0.30	2014	Year 0 (2014)	No irregularities noted.	Cap maintenance not required.	N/A
			Year 2 (2016)	No irregularities noted.	Cap maintenance not required.	N/A
CA77B-1	0.14	2014	Year 0 (2014)	No irregularities noted.	Cap maintenance not required.	N/A
			Year 2 (2016)	No irregularities noted.	Cap maintenance not required.	N/A
CB9A-1	0.15	2014	Year 0 (2014)	No irregularities noted.	Cap maintenance not required.	N/A
			Year 2 (2016)	No irregularities noted.	Cap maintenance not required.	N/A
CB43	4.54	2014	Year 0 (2014)	No irregularities noted.	Cap maintenance not required.	N/A
			Year 2 (2016)	No irregularities noted.	Cap maintenance not required.	N/A
CB027A-1	0.63	2014	Year 0 (2014)	No irregularities noted.	Cap maintenance not required.	N/A
			Year 2 (2016)	No irregularities noted.	Cap maintenance not required.	N/A
CB027A-2	0.13	2014	Year 0 (2014)	No irregularities noted.	Cap maintenance not required.	N/A
			Year 2 (2016)	No irregularities noted.	Cap maintenance not required.	N/A

Table 1
Upper OU4 COMMP Cap Integrity Assessment History

Location	Area (Acres)	Year Cap Completed	Routine Monitoring Event	Evaluation	Recommendation	Follow-up Action
CA63D	0.16	2014	Year 0 (2014)	No irregularities noted.	Cap maintenance not required.	N/A
			Year 2 (2016)	No irregularities noted.	Cap maintenance not required.	N/A
CAD27A-3	0.09	2014	Year 0 (2014)	No irregularities noted.	Cap maintenance not required.	N/A
			Year 2 (2016)	No irregularities noted.	Cap maintenance not required.	N/A
CA63C	0.43	2014	Year 0 (2014)	No irregularities noted.	Cap maintenance not required.	N/A
			Year 2 (2016)	No irregularities noted.	Cap maintenance not required.	N/A
CA67	0.60	2014	Year 0 (2014)	No irregularities noted.	Cap maintenance not required.	N/A
			Year 2 (2016)	No irregularities noted.	Cap maintenance not required.	N/A
CB33	2.72	2014	Year 0 (2014)	No irregularities noted.	Cap maintenance not required.	N/A
			Year 2 (2016)	The isometric view for the top of cap elevations for CB33 (Figure 98) appeared irregular and several depressed areas 0.5-1.5' were apparent in the isopach difference (Figure 9C); therefore, a cross-section was cut through the area (Figure 9D) to confirm cap integrity. The 2014 and 2016 surveys follow similar and parallel contours indicating that the irregularity is likely a reflection of the river bottom topography and consolidation of the underlying soft sediment. In addition, the piling/probing evaluation confirms the existence of armor stone in these areas.	Cap maintenance not required.	N/A
CB11A-1	0.76	2014	Year 0 (2014)	No irregularities noted.	Cap maintenance not required.	N/A
			Year 2 (2016)	No irregularities noted.	Cap maintenance not required.	N/A
CB45-1	3.47	2014	Year 0 (2014)	No irregularities noted.	Cap maintenance not required.	N/A
			Year 2 (2016)	Similar to CC3, contiguous cap areas CB45-1, CB45-2, and CA23A-1 (Figure 10C), as well as CB45-3 and the eastern portion of CA24B-2 (Figure 11C), contained relatively large areas in which the 2016 survey was lower than the 2014 survey by 0.5-1.0'. To confirm cap integrity, a cross-section was cut through CB45-1 as a representative section for these areas (Figure 10D). The 2014 and 2016 surveys follow a similar contour, though the 2016 survey is lower throughout CB45-1, indicating that the depressed areas are likely due to consolidation of underlying soft sediment. In addition, the piling/probing evaluation confirms the presence of the armor stone in these areas.	Cap maintenance not required.	N/A
CA23A-1	0.30	2014	Year 0 (2014)	No irregularities noted.	Cap maintenance not required.	N/A
			Year 2 (2016)	Similar to CC3, contiguous cap areas CB45-1, CB45-2, and CA23A-1 (Figure 10C), as well as CB45-3 and the eastern portion of CA24B-2 (Figure 11C), contained relatively large areas in which the 2016 survey was lower than the 2014 survey by 0.5-1.0'. To confirm cap integrity, a cross-section was cut through CB45-1 as a representative section for these areas (Figure 10D). The 2014 and 2016 surveys follow a similar contour, though the 2016 survey is lower throughout CB45-1, indicating that the depressed areas are likely due to consolidation of underlying soft sediment. In addition, the piling/probing evaluation confirms the presence of the armor stone in these areas.	Cap maintenance not required.	N/A
CA24B-1	1.37	2014	Year 0 (2014)	No irregularities noted.	Cap maintenance not required.	N/A
			Year 2 (2016)	No irregularities noted.	Cap maintenance not required.	N/A
CA24B-2	1.59	2014	Year 0 (2014)	No irregularities noted.	Cap maintenance not required.	N/A
			Year 2 (2016)	Similar to CC3, contiguous cap areas CB45-1, CB45-2, and CA23A-1 (Figure 10C), as well as CB45-3 and the eastern portion of CA24B-2 (Figure 11C), contained relatively large areas in which the 2016 survey was lower than the 2014 survey by 0.5-1.0'. To confirm cap integrity, a cross-section was cut through CB45-1 as a representative section for these areas (Figure 10D). The 2014 and 2016 surveys follow a similar contour, though the 2016 survey is lower throughout CB45-1, indicating that the depressed areas are likely due to consolidation of underlying soft sediment. In addition, the piling/probing evaluation confirms the presence of the armor stone in these areas.	Cap maintenance not required.	N/A


**Table 1
Upper OU4 COMMP Cap Integrity Assessment History**

Location	Area (Acres)	Year Cap Completed	Routine Monitoring Event	Evaluation	Recommendation	Follow-up Action
CB45-2	2.39	2014	Year 0 (2014)	No irregularities noted.	Cap maintenance not required.	N/A
			Year 2 (2016)	Similar to C03, contiguous cap areas CB45-1, CB45-2, and CA23A-1 (Figure 10C), as well as CB45-3 and the eastern portion of CA24B-2 (Figure 11C), contained relatively large areas in which the 2016 survey was lower than the 2014 survey by 0.5-1.0'. To confirm cap integrity, a cross-section was cut through CB45-1 as a representative section for these areas (Figure 10D). The 2014 and 2016 surveys follow a similar contour, though the 2016 survey is lower throughout CB45-1, indicating that the depressed areas are likely due to consolidation of underlying soft sediment. In addition, the polling/probing evaluation confirms the presence of the armor stone in these areas.	Cap maintenance not required.	N/A
CB45-3	3.23	2014	Year 0 (2014)	No irregularities noted.	Cap maintenance not required.	N/A
			Year 2 (2016)	Similar to C03, contiguous cap areas CB45-1, CB45-2, and CA23A-1 (Figure 10C), as well as CB45-3 and the eastern portion of CA24B-2 (Figure 11C), contained relatively large areas in which the 2016 survey was lower than the 2014 survey by 0.5-1.0'. To confirm cap integrity, a cross-section was cut through CB45-1 as a representative section for these areas (Figure 10D). The 2014 and 2016 surveys follow a similar contour, though the 2016 survey is lower throughout CB45-1, indicating that the depressed areas are likely due to consolidation of underlying soft sediment. In addition, the polling/probing evaluation confirms the presence of the armor stone in these areas.	Cap maintenance not required.	N/A
CB45-4	2.70	2014	Year 0 (2014) Year 2 (2016)	No irregularities noted. No irregularities noted.	Cap maintenance not required. Cap maintenance not required.	N/A N/A
CB027G-1	0.27	2014	Year 0 (2014)	No irregularities noted.	Cap maintenance not required.	N/A
			Year 2 (2016)	No irregularities noted.	Cap maintenance not required.	N/A
CA24C	0.74	2014	Year 0 (2014) Year 2 (2016)	No irregularities noted. No irregularities noted.	Cap maintenance not required. Cap maintenance not required.	N/A N/A
CA24D	0.56	2014	Year 0 (2014) Year 2 (2016)	No irregularities noted. No irregularities noted.	Cap maintenance not required. Cap maintenance not required.	N/A N/A
CA27AB	1.11	2014	Year 0 (2014) Year 2 (2016)	Linear irregularities are evident in the isometric view on the north east end of the cap. Foth investigated the potential causes for these linear irregularities and found that multiple dredging and/or capping/covering pipelines were traversing this cap area at the time of the survey data collection. No irregularities noted.	Cap maintenance not required. Cap maintenance not required.	N/A N/A
CB53	0.09	2014	Year 0 (2014)	No irregularities noted.	Cap maintenance not required.	N/A
			Year 2 (2016)	No irregularities noted.	Cap maintenance not required.	N/A
CB89A	0.26	2014	Year 0 (2014) Year 2 (2016)	No irregularities noted. No irregularities noted.	Cap maintenance not required. Cap maintenance not required.	N/A N/A
CA89B	0.33	2014	Year 0 (2014) Year 2 (2016)	No irregularities noted. No irregularities noted.	Cap maintenance not required. Cap maintenance not required.	N/A N/A
OU4 COMMP Total 2013-2014	51.47					





N/A - Not Applicable

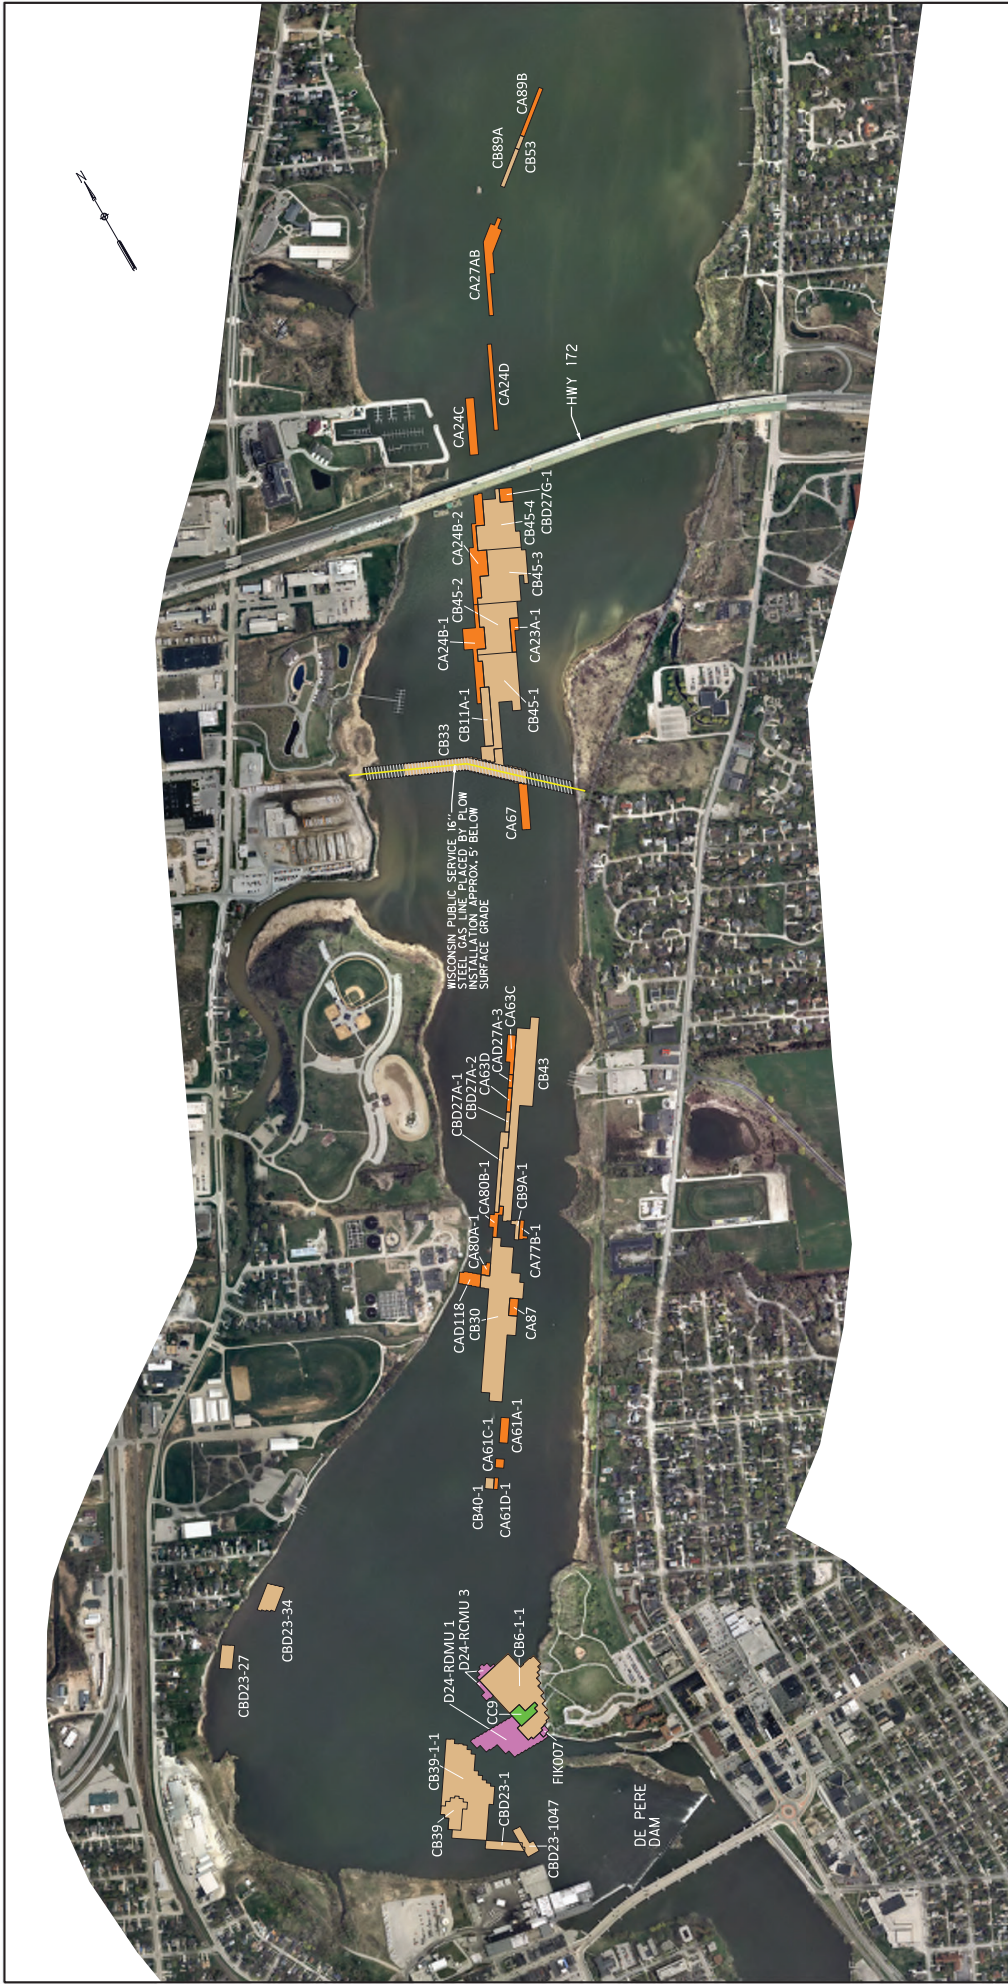Prepared by: TMK1
Checked by: KMO


Figures



LEGEND


-  "A" CAP DESIGN PLACEMENT LOCATION AND IDENTIFICATION
-  "B" CAP DESIGN PLACEMENT LOCATION AND IDENTIFICATION
-  "C" CAP DESIGN PLACEMENT LOCATION AND IDENTIFICATION
-  RESIDUAL CAP DESIGN PLACEMENT LOCATION AND IDENTIFICATION

- NOTES:**
1. THE HORIZONTAL CONTROL IS REFERENCED TO THE NAD83 WISCONSIN STATE PLANE COORDINATE SYSTEM (WISCONSIN CENTRAL ZONE). THE VERTICAL CONTROL IS REFERENCED TO NAVD 88.
 2. ORTHO PHOTO SUPPLIED BY BROWN COUNTY LAND INFORMATION OFFICE COMPILED IN NOVEMBER 2010.
 3. DESIGN CAP PLACEMENT LIMITS AND UTILITY LOCATIONS DERIVED FROM DESIGN FILES PROVIDED BY TETRA TECH EC, INC.



0 500' 1000'
BAR SCALE

LOWER FOX RIVER REMEDIATION LLC.	
FIGURE 1	
LOWER FOX RIVER - OUA	
2014 CAP PLACEMENT LOCATIONS	
Date: DECEMBER, 2016	Revision Date:
Drawn By: JRB2	Checked By: TMT1
Scope:	16L029

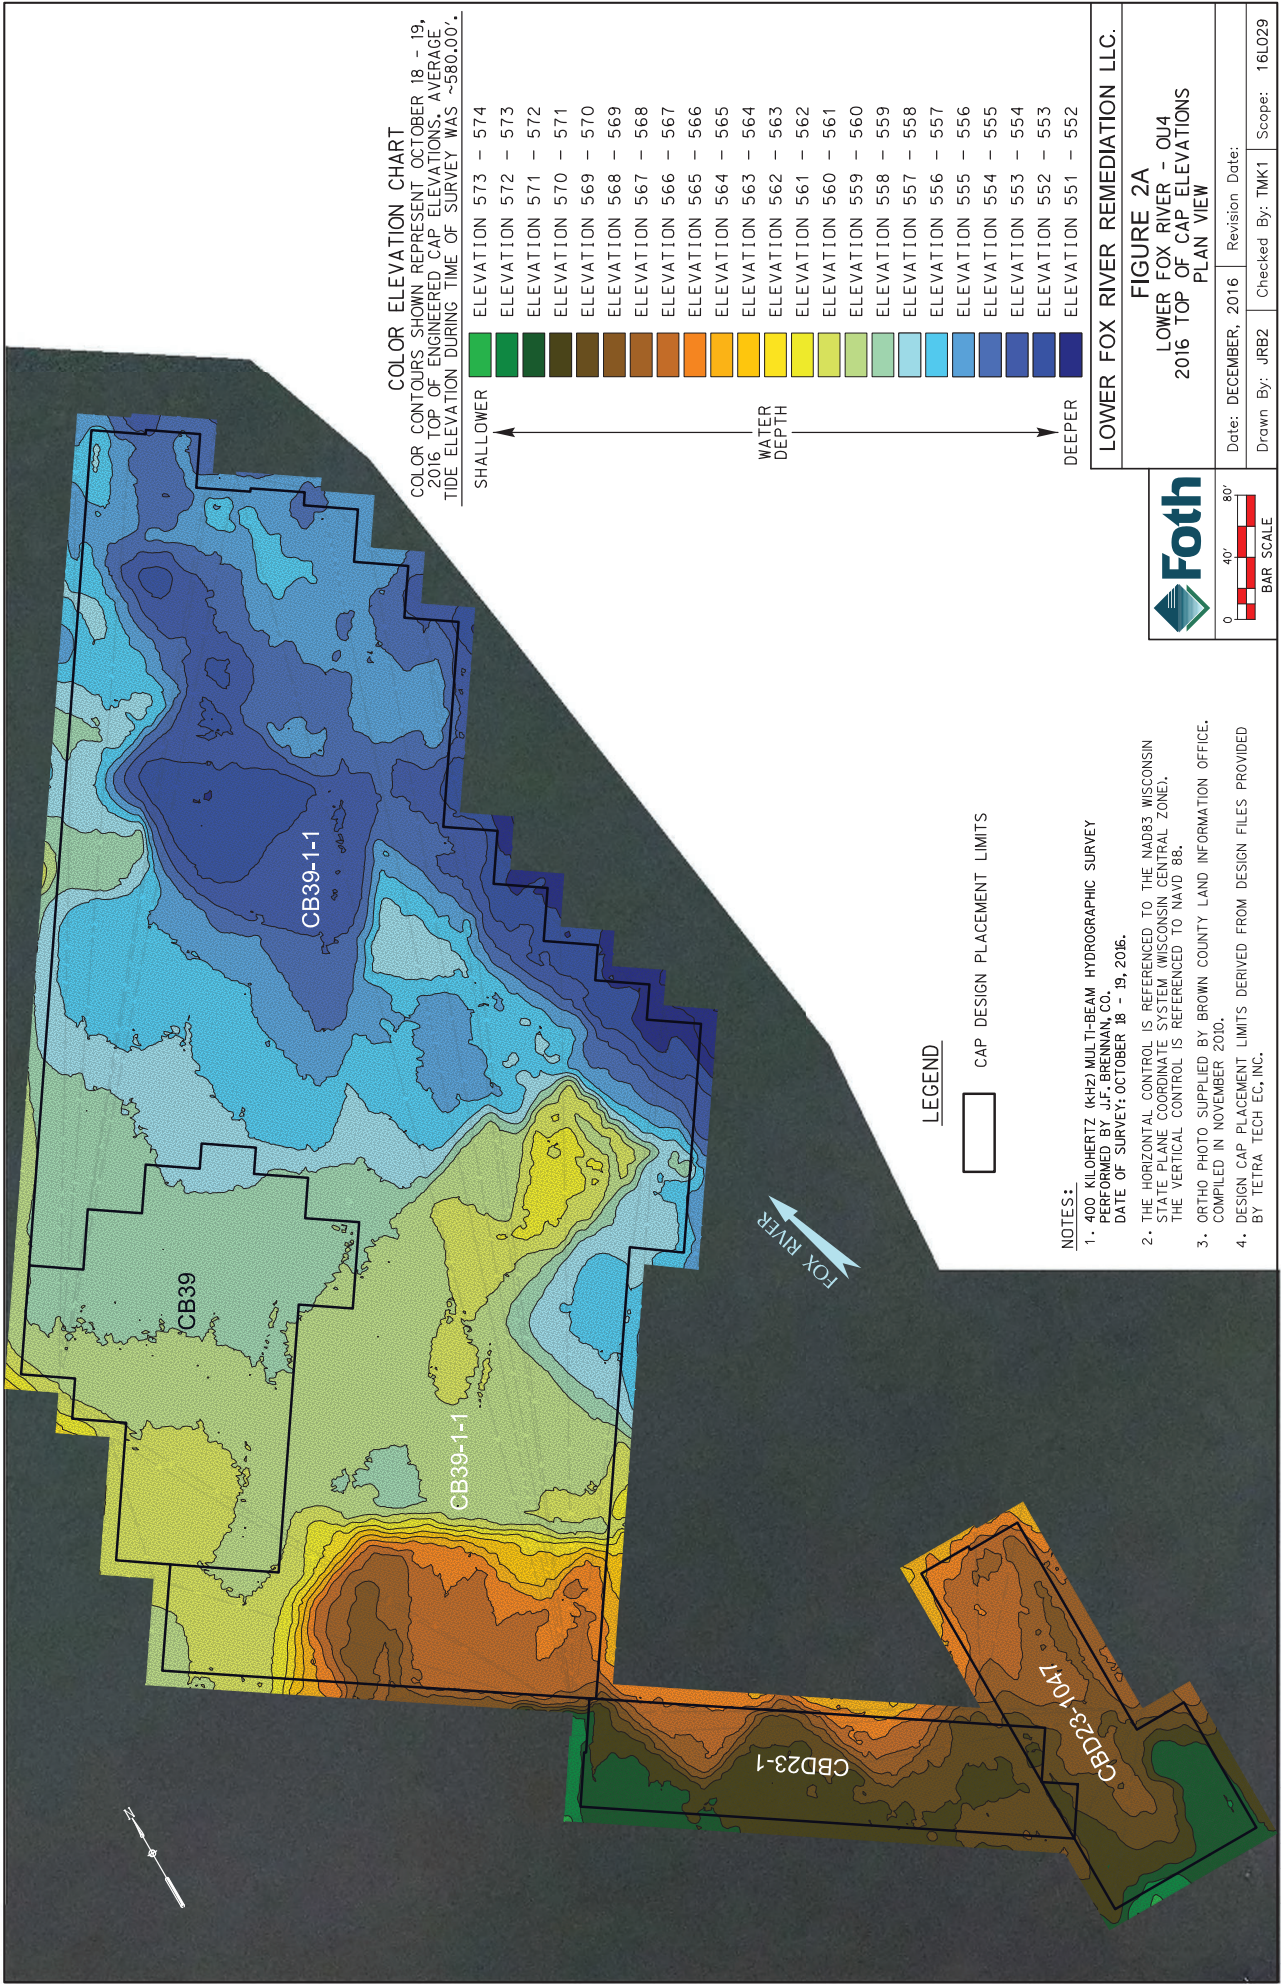

COLOR ELEVATION CHART
 COLOR CONTOURS SHOWN REPRESENT OCTOBER 18 - 19, 2016 TOP OF ENGINEERED CAP ELEVATIONS, AVERAGE, TIDE ELEVATION DURING TIME OF SURVEY WAS ~580.00'.

SHALLOWER	ELEVATION 573 - 574
	ELEVATION 572 - 573
	ELEVATION 571 - 572
	ELEVATION 570 - 571
	ELEVATION 569 - 570
	ELEVATION 568 - 569
	ELEVATION 567 - 568
	ELEVATION 566 - 567
	ELEVATION 565 - 566
	ELEVATION 564 - 565
	ELEVATION 563 - 564
	ELEVATION 562 - 563
	ELEVATION 561 - 562
	ELEVATION 560 - 561
	ELEVATION 559 - 560
	ELEVATION 558 - 559
	ELEVATION 557 - 558
	ELEVATION 556 - 557
	ELEVATION 555 - 556
	ELEVATION 554 - 555
	ELEVATION 553 - 554
	ELEVATION 552 - 553
DEEPER	ELEVATION 551 - 552

LEGEND
 [] CAP DESIGN PLACEMENT LIMITS

- NOTES:**
1. 400 KILOBERTZ (KSP) MULTI-BEAM HYDROGRAPHIC SURVEY PERFORMED BY J.F. BRENNAN CO. 18 - 19, 2016. DATE OF SURVEY: OCTOBER 18 - 19, 2016.
 2. THE HORIZONTAL CONTROL IS REFERENCED TO THE NAD83 WISCONSIN STATE PLANE COORDINATE SYSTEM (WISCONSIN CENTRAL ZONE). THE VERTICAL CONTROL IS REFERENCED TO NAVD 88.
 3. ORTHO PHOTO SUPPLIED BY BROWN COUNTY LAND INFORMATION OFFICE. COMPILED IN NOVEMBER 2010.
 4. DESIGN CAP PLACEMENT LIMITS DERIVED FROM DESIGN FILES PROVIDED BY TETRA TECH EC, INC.

Foth

0 40' 80'
 BAR SCALE


LOWER FOX RIVER REMEDIATION LLC.

FIGURE 2A
 LOWER FOX RIVER - QUA
 2016 TOP OF CAP ELEVATIONS
 PLAN VIEW

Date: DECEMBER, 2016	Revision Date:
Drawn By: JRB2	Checked By: TMT1
Scope: 16L029	




FOX RIVER

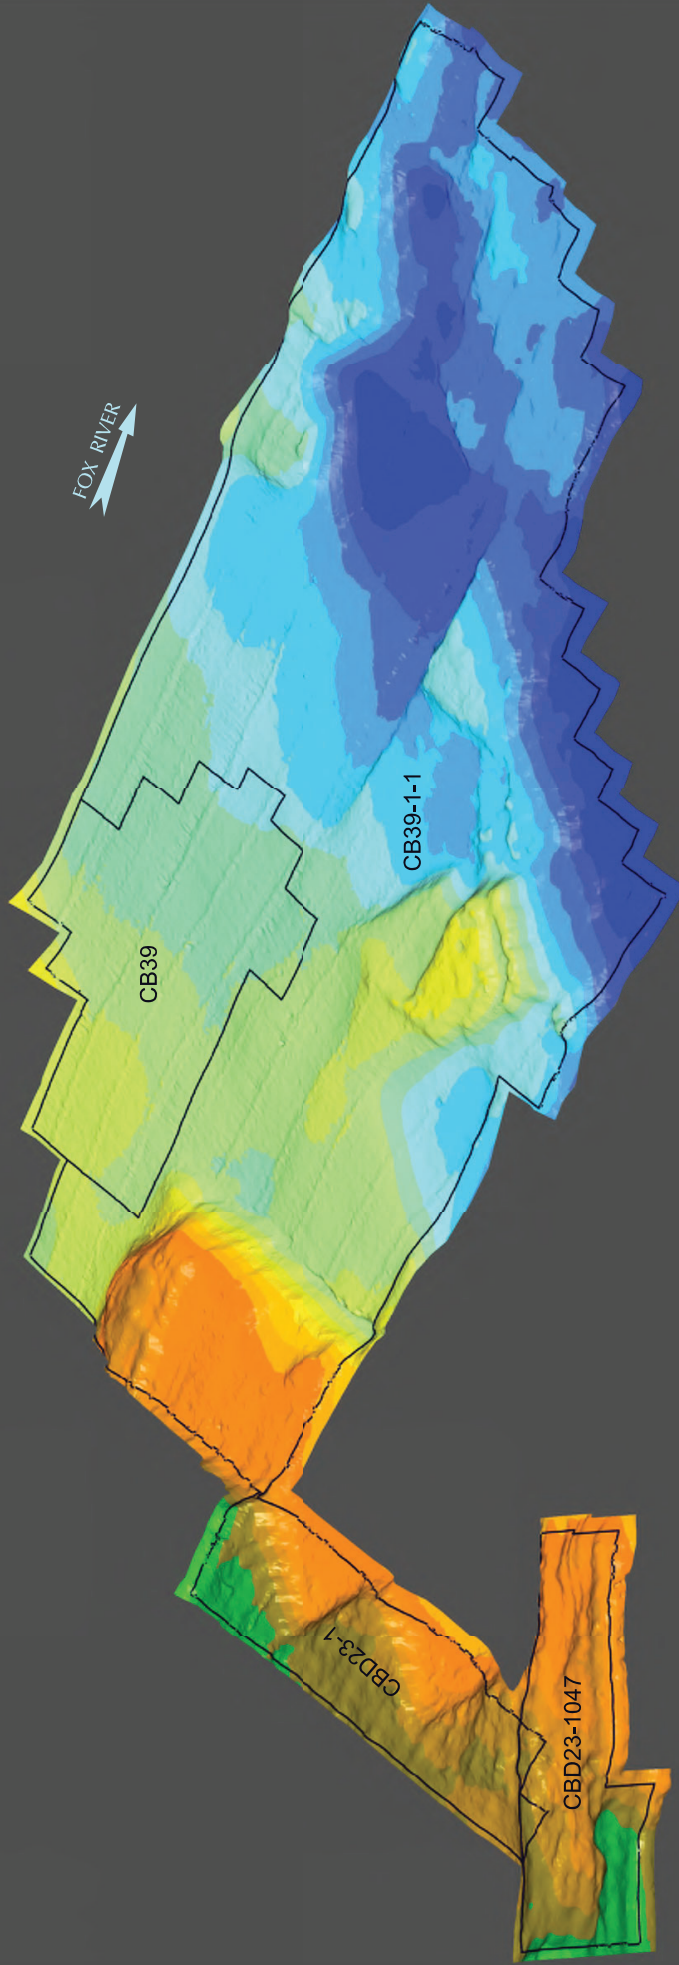

COLOR ELEVATION CHART

COLOR CONTOURS SHOWN REPRESENT OCTOBER 18 - 19, 2016 TOP OF ENGINEERED CAP ELEVATIONS. AVERAGE TIDE ELEVATION DURING TIME OF SURVEY WAS ~580.00'.

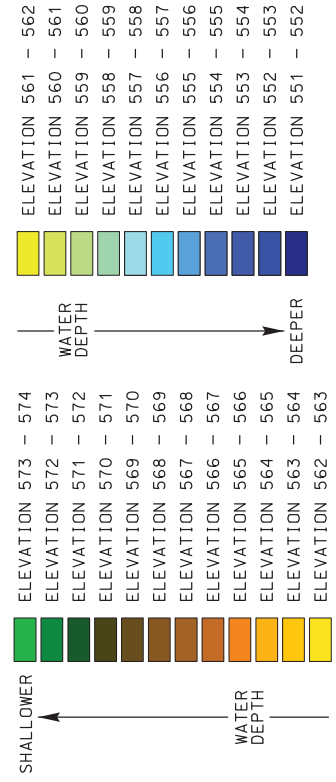

LEGEND


□ CAP DESIGN PLACEMENT LIMITS

- NOTES:**
- 400 KILOHERTZ (KHZ) MULTI-BEAM HYDROGRAPHIC SURVEY PERFORMED BY J.F. BRENNAN, CO. DATE OF SURVEY: OCTOBER 18 - 19, 2016.
 - THE HORIZONTAL CONTROL IS REFERENCED TO THE NAD83 WISCONSIN STATE PLANE COORDINATE SYSTEM (WISCONSIN CENTRAL ZONE). THE VERTICAL CONTROL IS REFERENCED TO NAVD 88.
 - DESIGN CAP PLACEMENT LIMITS DERIVED FROM DESIGN FILES PROVIDED BY TETRA TECH EC, INC.




VERTICAL SCALE FOR ILLUSTRATION PURPOSES ONLY. NOT TO SCALE.

LOWER FOX RIVER REMEDIATION LLC.	
FIGURE 2B	
LOWER FOX RIVER - QUA	
2016 TOP OF CAP ELEVATIONS	
ISOMETRIC VIEW	
Date: DECEMBER, 2016	Revision Date:
Drawn By: JRB2	Checked By: TMT1
Scope: 16L029	

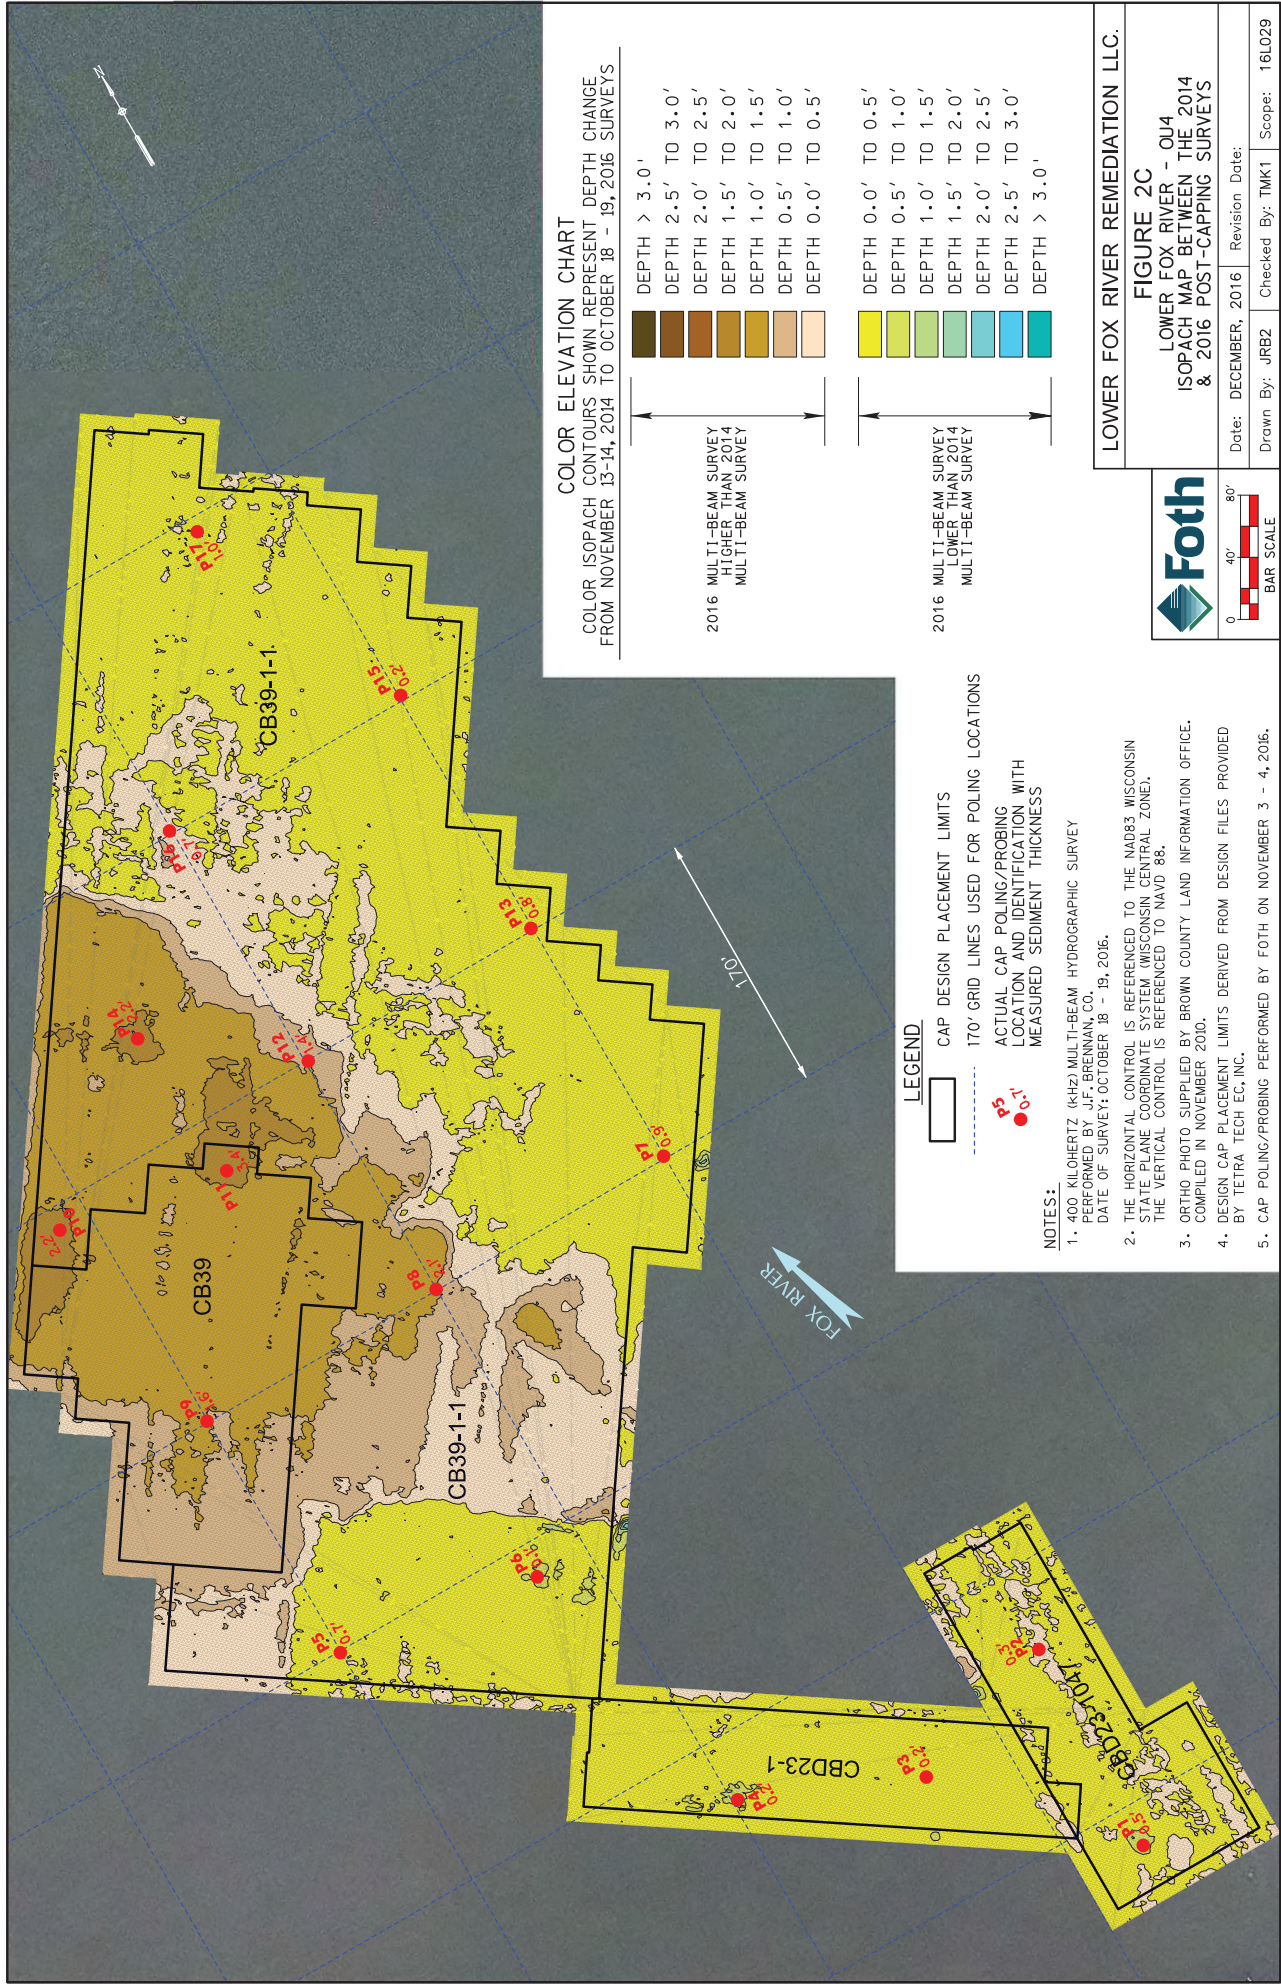

COLOR ELEVATION CHART

COLOR ISOPACH CONTOURS SHOWN REPRESENT DEPTH CHANGE FROM NOVEMBER 13-14, 2014 TO OCTOBER 18 - 19, 2016 SURVEYS

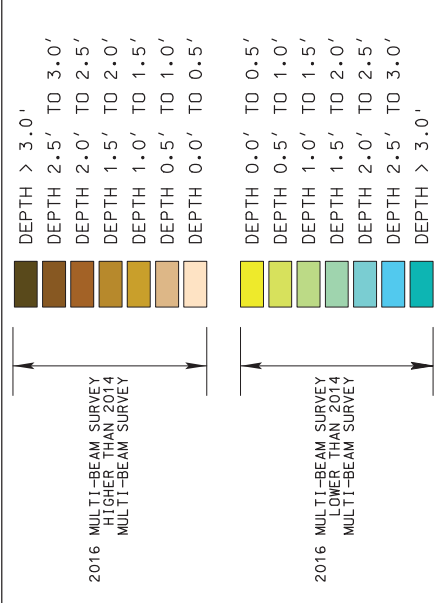

LEGEND

- CAP DESIGN PLACEMENT LIMITS
- 170' GRID LINES USED FOR POLING LOCATIONS
- P5 ACTUAL CAP POLING/PROBING LOCATION AND IDENTIFICATION WITH MEASURED SEDIMENT THICKNESS

NOTES:

1. 400 KILOHERTZ (KHZ) MULTI-BEAM HYDROGRAPHIC SURVEY PERFORMED BY J.F. BRENNAN, CO. DATE OF SURVEY: OCTOBER 18 - 19, 2016.
2. THE HORIZONTAL CONTROL IS REFERENCED TO THE NAD83 WISCONSIN STATE PLANE COORDINATE SYSTEM (WISCONSIN CENTRAL ZONE). THE VERTICAL CONTROL IS REFERENCED TO NAVD 88.
3. ORTHO PHOTO SUPPLIED BY BROWN COUNTY LAND INFORMATION OFFICE. COMPILED IN NOVEMBER 2010.
4. DESIGN CAP PLACEMENT LIMITS DERIVED FROM DESIGN FILES PROVIDED BY TETRA TECH EC, INC.
5. CAP POLING/PROBING PERFORMED BY FOTH ON NOVEMBER 3 - 4, 2016.

0 40' 80'
BAR SCALE

LOWER FOX RIVER REMEDIATION LLC.	
FIGURE 2C	
LOWER FOX RIVER - OUA ISOPACH MAP BETWEEN THE 2014 & 2016 POST-CAPPING SURVEYS	
Date: DECEMBER, 2016	Revision Date:
Drawn By: JRB2	Checked By: TMB
Scope: 16L029	

LEGEND





CAP DESIGN PLACEMENT LIMITS

NOTES:

1. 400 KILOHERTZ (KHZ) MULTI-BEAM HYDROGRAPHIC SURVEY PERFORMED BY J.F. BRENNAN, CO. DATE OF SURVEY: OCTOBER 18 - 19, 2016.
2. THE HORIZONTAL CONTROL IS REFERENCED TO THE NAD83, WISCONSIN STATE PLANE COORDINATE SYSTEM, WISCONSIN CENTRAL ZONE. THE VERTICAL CONTROL IS REFERENCED TO NAVD 88.
3. ORTHO PHOTO SUPPLIED BY BROWN COUNTY LAND INFORMATION OFFICE. COMPILED IN NOVEMBER 2010.
4. DESIGN CAP PLACEMENT LIMITS DERIVED FROM DESIGN FILES PROVIDED BY TETRA TECH EC, INC.

COLOR ELEVATION CHART
 COLOR CONTOURS SHOWN REPRESENT OCTOBER 18 - 19, 2016 TOP OF ENGINEERED CAP ELEVATIONS. AVERAGE TIDE ELEVATION DURING TIME OF SURVEY WAS ~580.00'.

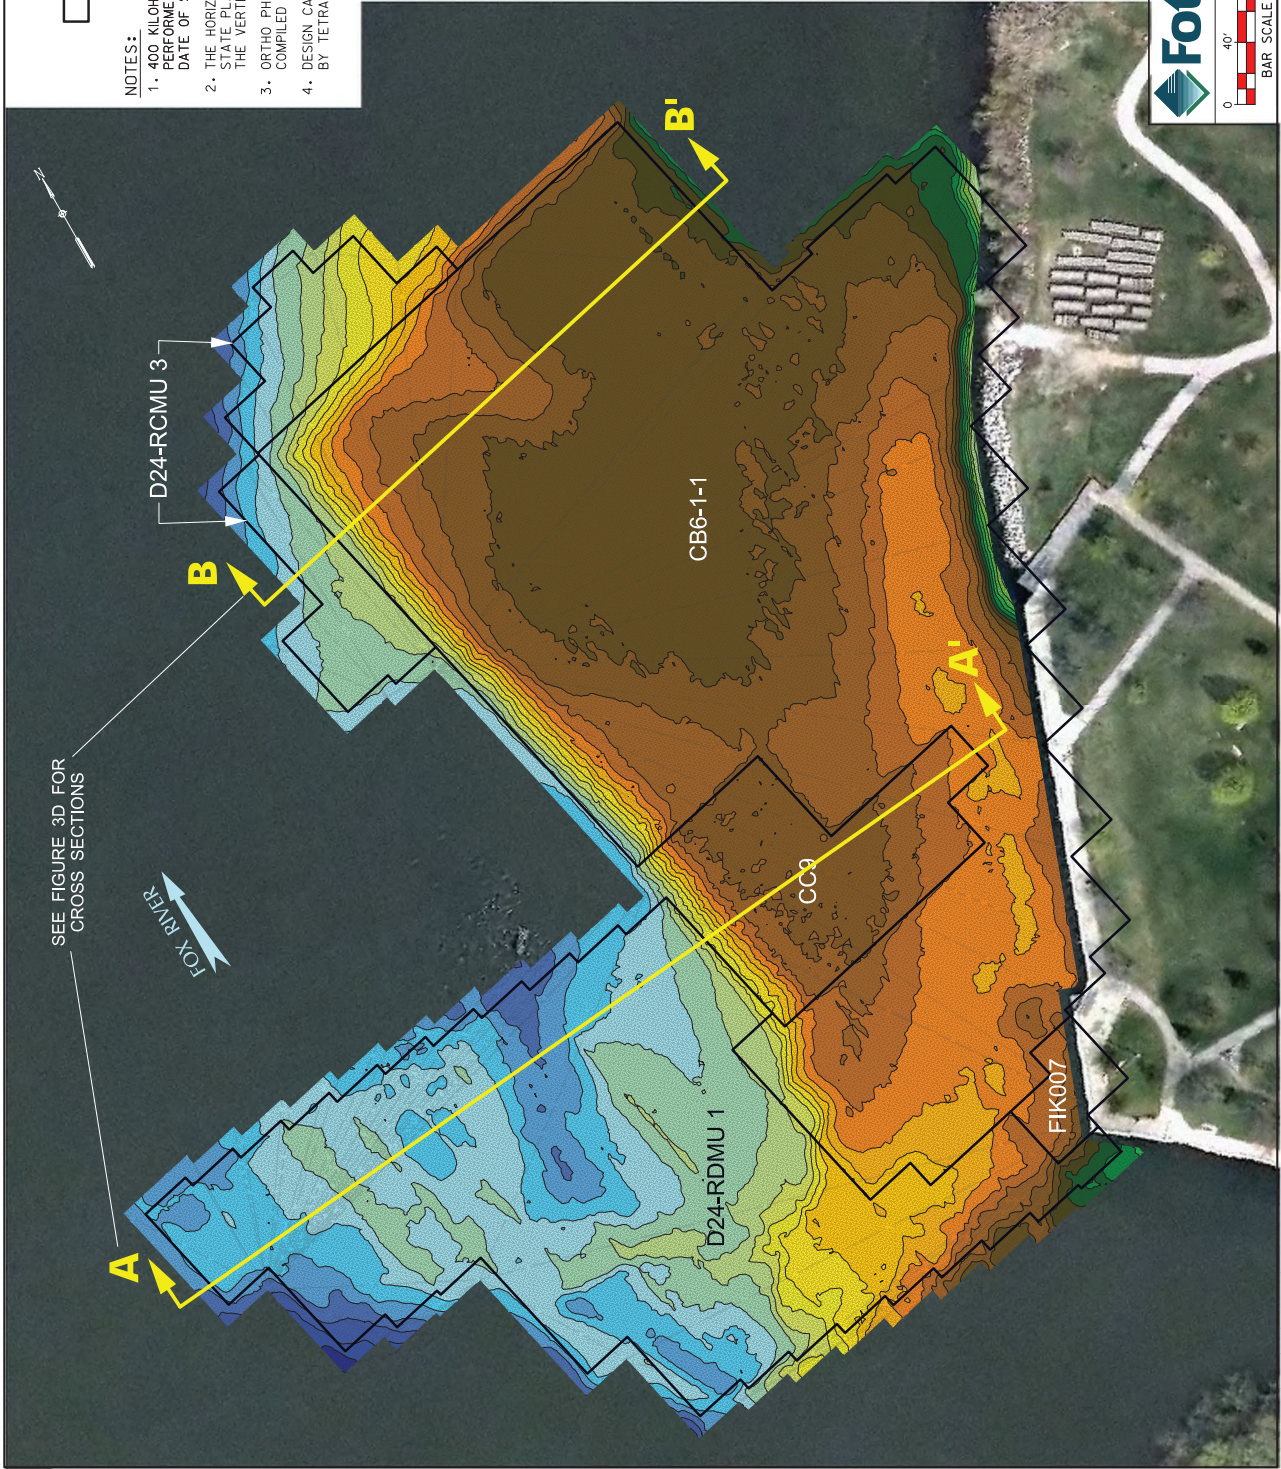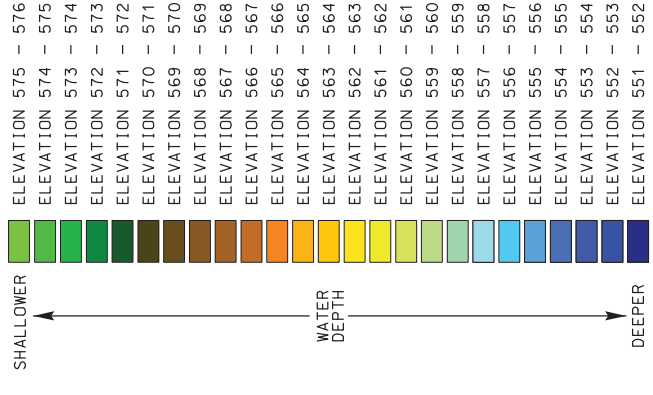


SEE FIGURE 3D FOR CROSS SECTIONS



0 40' 80'
 BAR SCALE


LOWER FOX RIVER REMEDIATION LLC.	
FIGURE 3A	
LOWER FOX RIVER - QUA	
2016 TOP OF CAP ELEVATIONS	
PLAN VIEW	
Date: DECEMBER, 2016	Revision Date:
Drawn By: JRB2	Checked By: TMK1
Scope: 16L029	

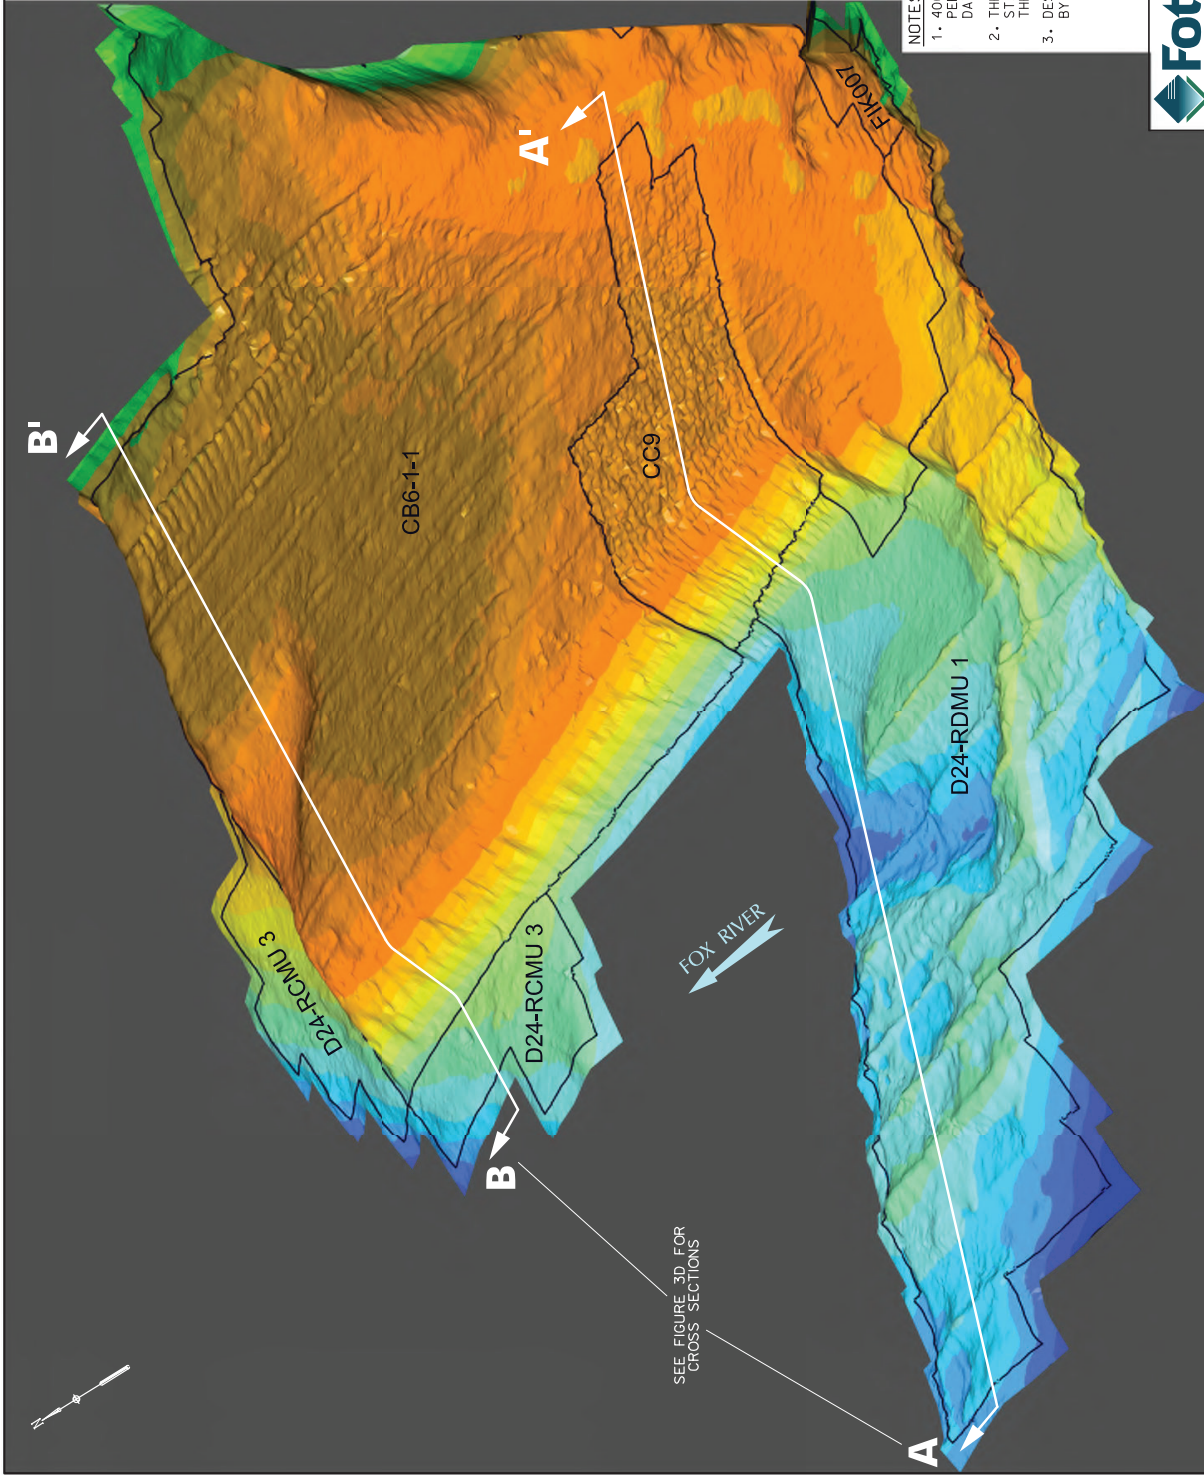

LEGEND

□ CAP DESIGN PLACEMENT LIMITS

COLOR ELEVATION CHART
 COLOR CONTOURS SHOWN REPRESENT OCTOBER 18 - 19, 2016 TOP OF ENGINEERED CAP ELEVATIONS AVERAGE TIDE ELEVATION DURING TIME OF SURVEY WAS ~580.00'

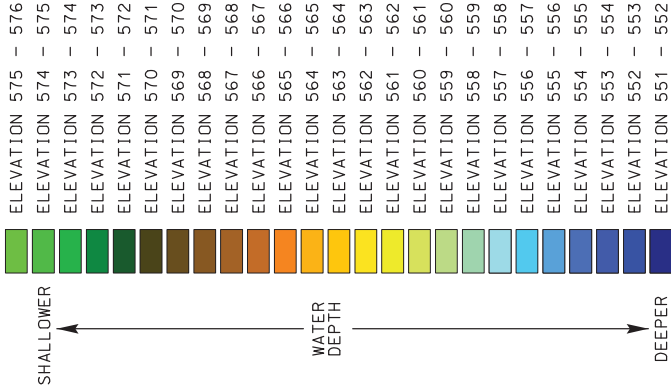

NOTES:

1. 400 KILOHERTZ (KHZ) MULTI-BEAM HYDROGRAPHIC SURVEY PERFORMED BY J.F. BRENNAN, CO. DATE OF SURVEY: OCTOBER 18 - 19, 2016.
2. THE HORIZONTAL CONTROL IS REFERENCED TO THE NAD83 WISCONSIN STATE PLANE COORDINATE SYSTEM (WISCONSIN CENTRAL ZONE). THE VERTICAL CONTROL IS REFERENCED TO NAVD 88.
3. DESIGN CAP PLACEMENT LIMITS DERIVED FROM DESIGN FILES PROVIDED BY TETRA TECH EC, INC.




LOWER FOX RIVER REMEDIATION LLC.

FIGURE 3B
 LOWER FOX RIVER - QUA
 2016 TOP OF CAP ELEVATIONS
 ISOMETRIC VIEW

Date: DECEMBER, 2016 Revision Date:
 Drawn By: JRB2 Checked By: TMT1 Scope: 16L029


VERTICAL SCALE
 FOR CALCULATION
 PURPOSES ONLY.
 NOT TO SCALE.

LEGEND:

 CAP DESIGN PLACEMENT LIMITS
 170' GRID LINES USED FOR POLING LOCATIONS
 ACTUAL CAP POLING/PROBING LOCATION AND IDENTIFICATION WITH MEASURED SEDIMENT THICKNESS

NOTES:

- 400 KILOHERTZ (KHZ) MULTI-BEAM HYDROGRAPHIC SURVEY PERFORMED BY J.F. BRENNAN, CO. DATE OF SURVEY: OCTOBER 18 - 19, 2016.
- THE HORIZONTAL CONTROL IS REFERENCED TO THE NAD83 WISCONSIN STATE PLANE COORDINATE SYSTEM (WISCONSIN CENTRAL ZONE). THE VERTICAL CONTROL IS REFERENCED TO NAVD 88.
- ORTHO PHOTO SUPPLIED BY BROWN COUNTY LAND INFORMATION OFFICE. COMPILED IN NOVEMBER 2010.
- DESIGN CAP PLACEMENT LIMITS DERIVED FROM DESIGN FILES PROVIDED BY TETRA TECH EC, INC.
- CAP POLING/PROBING PERFORMED BY FOTH ON NOVEMBER 3 - 4, 2016.

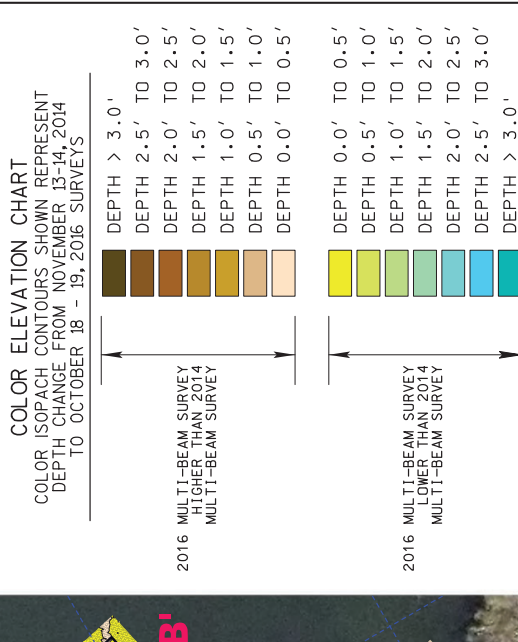

Foth




0 40' 80'
BAR SCALE

LOWER FOX RIVER REMEDIATION LLC.

FIGURE 3C

LOWER FOX RIVER - OUA
ISOPACH MAP BETWEEN THE 2014
& 2016 POST-CAPPING SURVEYS

Date: NOVEMBER, 2016 Revision Date:
 Drawn By: JRB2 Checked By: TMK1 Scope: 16L029

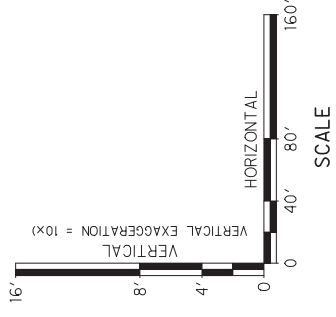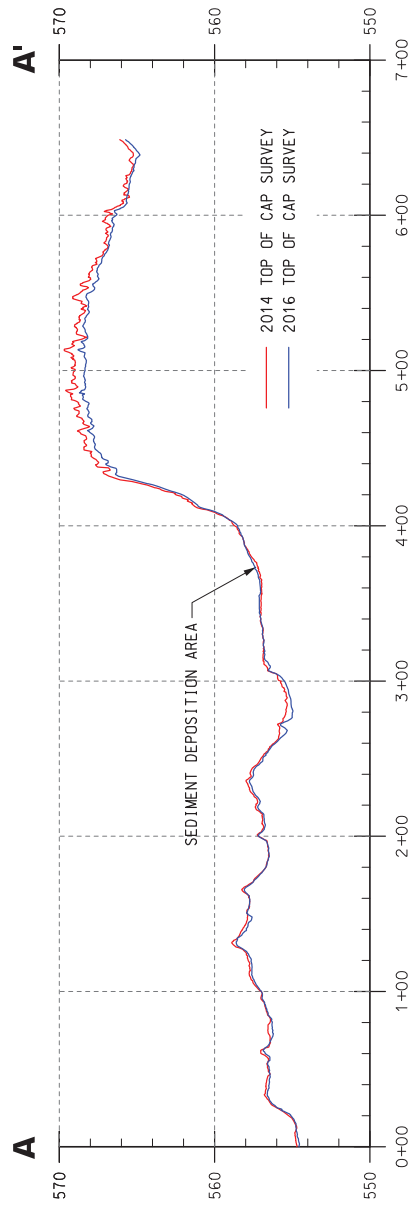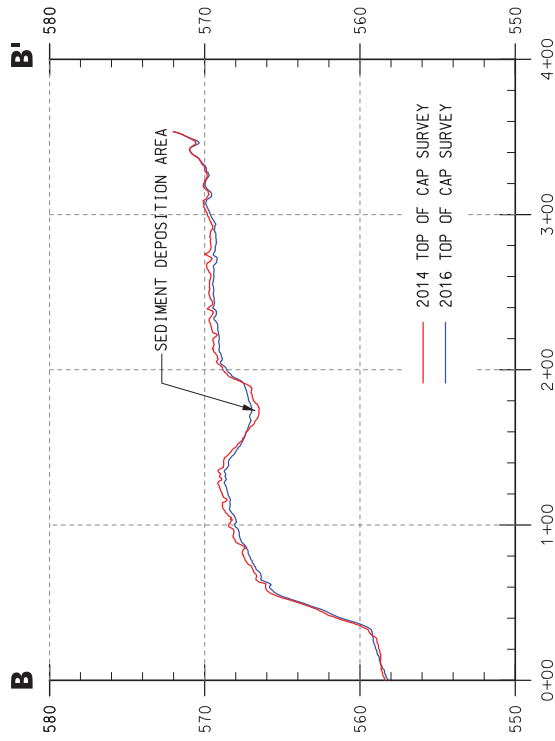

SEE FIGURES 3A, 3B & 3C FOR
CROSS SECTION LOCATIONS



SCALE: AS SHOWN

LOWER FOX RIVER REMEDIATION LLC.			
FIGURE 3D			
LOWER FOX RIVER - OU4 TOP OF CAP CROSS SECTIONS			
Date: DECEMBER, 2016	Revision Date:		Scope: 16L029
Drawn By: JRB2	Checked By: TMK1		




LEGEND



CAP DESIGN PLACEMENT LIMITS


COLOR ELEVATION CHART

COLOR CONTOURS SHOWN REPRESENT OCTOBER 18 - 19, 2016 TOP OF ENGINEERED CAP ELEVATIONS. AVERAGE TIDE ELEVATION DURING TIME OF SURVEY WAS ~580.00'.

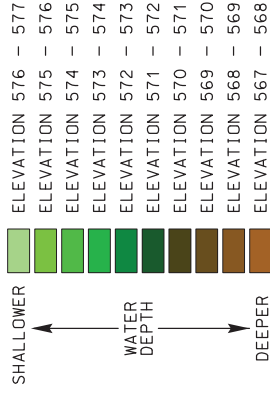

NOTES:

- 400 KILOHERTZ (KHZ) MULTI-BEAM HYDROGRAPHIC SURVEY PERFORMED BY J.F. BRENNAN, CO. DATE OF SURVEY: OCTOBER 18 - 19, 2016.
- THE HORIZONTAL CONTROL IS REFERENCED TO THE NAD83 WISCONSIN STATE PLANE COORDINATE SYSTEM (WISCONSIN CENTRAL ZONE). THE VERTICAL CONTROL IS REFERENCED TO NAVD 88.
- ORTHO PHOTO SUPPLIED BY BROWN COUNTY LAND INFORMATION OFFICE. COMPILED IN NOVEMBER 2010.
- DESIGN CAP PLACEMENT LIMITS DERIVED FROM DESIGN FILES PROVIDED BY TETRA TECH EC, INC.

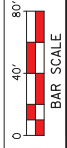

BAR SCALE

Date: DECEMBER, 2016	Revision Date:
Drawn By: JRB2	Checked By: TMK1
Scope:	16L029

LOWER FOX RIVER REMEDIATION LLC.

FIGURE 4A
LOWER FOX RIVER - QUA
2016 TOP OF CAP ELEVATIONS
PLAN VIEW



FOX RIVER

COLOR ELEVATION CHART
 COLOR CONTOURS SHOWN REPRESENT OCTOBER 18 - 19, 2016 TOP OF ENGINEERED CAP ELEVATIONS. AVERAGE TIDE ELEVATION DURING TIME OF SURVEY WAS ~580.00'.

SHALLOWER	ELEVATION 576	-	577
	ELEVATION 575	-	576
	ELEVATION 574	-	575
	ELEVATION 573	-	574
	ELEVATION 572	-	573
	ELEVATION 571	-	572
	ELEVATION 570	-	571
	ELEVATION 569	-	570
	ELEVATION 568	-	569
DEEPER	ELEVATION 567	-	568

WATER DEPTH

LEGEND



CAP DESIGN PLACEMENT LIMITS

NOTES:

1. 400 KILOHERTZ (KHZ) MULTI-BEAM HYDROGRAPHIC SURVEY PERFORMED BY J.F. BRENNAN, CO. DATE OF SURVEY: OCTOBER 18 - 19, 2016.
2. THE HORIZONTAL CONTROL IS REFERENCED TO THE NAD83 WISCONSIN STATE PLANE COORDINATE SYSTEM WISCONSIN CENTRAL ZONE. THE VERTICAL CONTROL IS REFERENCED TO NAVD 88.
3. DESIGN CAP PLACEMENT LIMITS DERIVED FROM DESIGN FILES PROVIDED BY TETRA TECH EC, INC.



VERTICAL SCALE
 NOT TO SCALE.
 HORIZONTAL SCALE
 NOT TO SCALE.

LOWER FOX RIVER REMEDIATION LLC.

FIGURE 4B
 LOWER FOX RIVER - Q14
 2016 TOP OF CAP ELEVATIONS
 ISOMETRIC VIEW

Date: DECEMBER, 2016 | Revision Date:
 Drawn By: JRB2 | Checked By: TMK1 | Scope: 16L029




LEGEND

- CAP DESIGN PLACEMENT LIMITS
- 170' GRID LINES USED FOR POLING LOCATIONS
- ACTUAL CAP POLING/PROBING LOCATION AND IDENTIFICATION WITH MEASURED SEDIMENT THICKNESS

COLOR ELEVATION CHART

COLOR ISOPACH CONTOURS SHOWN REPRESENT DEPTH CHANGE FROM NOVEMBER 13-14, 2014 TO OCTOBER 18, 19 & 25 2016 SURVEYS

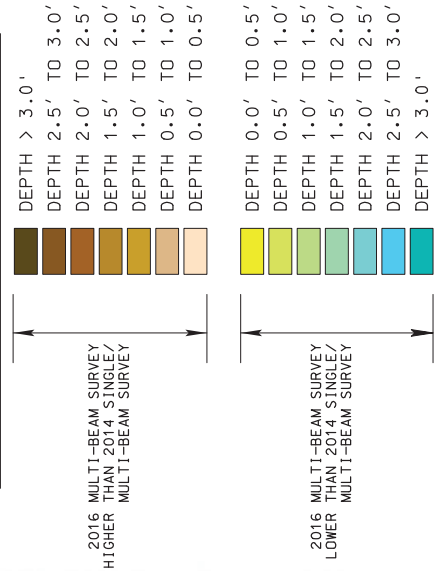


NOTES:

1. 200 KILOHERTZ (KHZ) SINGLE BEAM HYDROGRAPHIC SURVEY PERFORMED BY J.F. BRENNAN, CO. DATE OF SURVEY: OCTOBER 18 - 19, 2016.
2. THE HORIZONTAL CONTROL IS REFERENCED TO THE NAD83 WISCONSIN STATE PLANE COORDINATE SYSTEM (WISCONSIN CENTRAL ZONE). THE VERTICAL CONTROL IS REFERENCED TO NAVD 88.
3. ORTHO PHOTO SUPPLIED BY BROWN COUNTY LAND INFORMATION OFFICE. COMPILED IN NOVEMBER 2016.
4. DESIGN CAP PLACEMENT LIMITS DERIVED FROM DESIGN FILES PROVIDED BY TETRA TECH EC, INC.
5. CAP POLING/PROBING PERFORMED BY FOTH ON NOVEMBER 3 - 4, 2016.

LOWER FOX RIVER REMEDIATION LLC.

FIGURE 4C

LOWER FOX RIVER - 014
ISOPACH MAP BETWEEN THE 2014
& 2016 POST-CAPPING SURVEYS

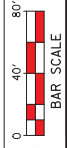





Date: DECEMBER, 2016	Revision Date:
Drawn By: JRB2	Checked By: TMK1
Scope: 16L029	

LEGEND



CAP DESIGN PLACEMENT LIMITS

COLOR ELEVATION CHART
 COLOR CONTOURS SHOWN REPRESENT 4-11, 4-20 & 5-3, 2016 TOP OF ENGINEERED CAP ELEVATIONS. AVERAGE TIDE ELEVATION DURING TIME OF SURVEY WAS 580.30'.

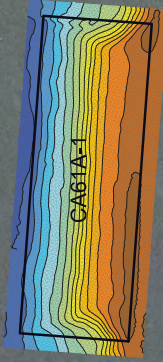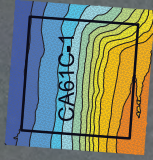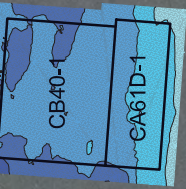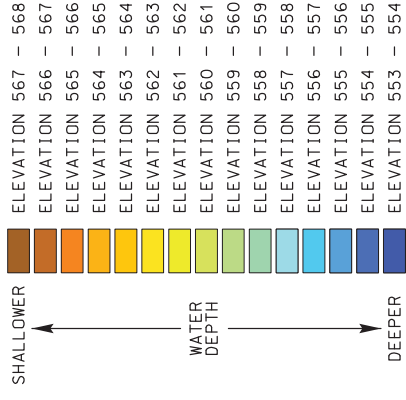


FOX RIVER

NOTES:

1. 400 KILOHERTZ (KHz) MULTI-BEAM HYDROGRAPHIC SURVEY PERFORMED BY J.F. BRENNAN, CO. DATE OF SURVEY: APRIL 11, APRIL 20 AND MAY 3, 2016.
2. THE HORIZONTAL CONTROL IS REFERENCED TO THE NAD83 WISCONSIN STATE PLANE COORDINATE SYSTEM (WISCONSIN CENTRAL ZONE). THE VERTICAL CONTROL IS REFERENCED TO NAVD 86.
3. ORTHO PHOTO SUPPLIED BY BROWN COUNTY LAND INFORMATION OFFICE. COMPILED IN NOVEMBER 2010.
4. DESIGN CAP PLACEMENT LIMITS DERIVED FROM DESIGN FILES PROVIDED BY TETRA TECH EC, INC.




DRAFT

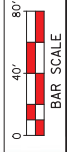

LOWER FOX RIVER REMEDIATION LLC.


FIGURE 5A
 LOWER FOX RIVER - QUA
 2016 TOP OF CAP ELEVATIONS
 PLAN VIEW

Date:	JULY, 2016	Revision Date:	
Drawn By:	JRB2	Checked By:	TMK1
Scope:	16L029		

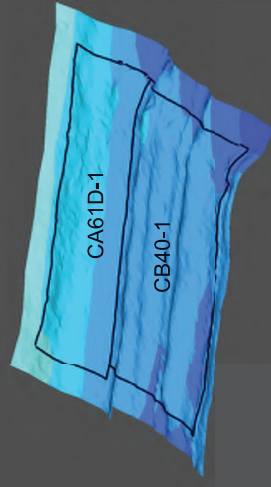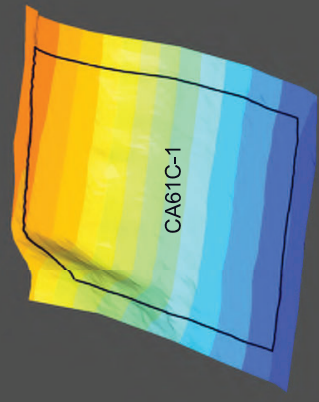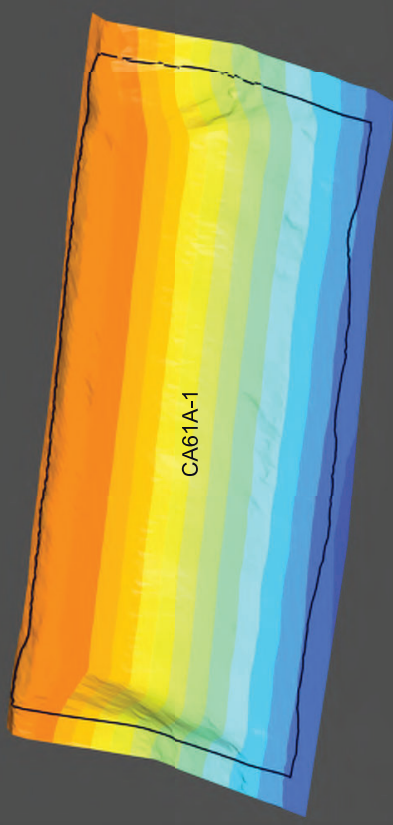

FOX RIVER

COLOR ELEVATION CHART
 COLOR CONTOURS SHOWN REPRESENT OCTOBER 18 - 19, 2016 TOP OF ENGINEERED CAP ELEVATIONS, AVERAGE TIDE ELEVATION DURING TIME OF SURVEY WAS ~580.30'

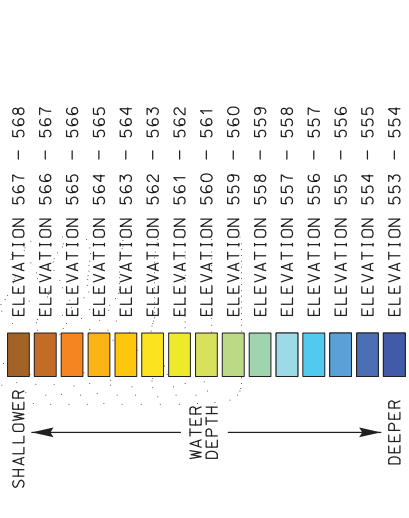


LEGEND

□ CAP DESIGN PLACEMENT LIMITS

- NOTES:**
1. 400 KILBERTZ (4472) MULTI-BEAM HYDROGRAPHIC SURVEY PERFORMED BY J.F. BERGMAN CO., 19, 2016. DATE OF SURVEY: OCTOBER 18 - 19, 2016.
 2. THE HORIZONTAL CONTROL IS REFERENCED TO THE NAD83 WISCONSIN STATE PLANE COORDINATE SYSTEM (WISCONSIN CENTRAL ZONE). THE VERTICAL CONTROL IS REFERENCED TO NAVD 88.
 3. DESIGN CAP PLACEMENT LIMITS DERIVED FROM DESIGN FILES PROVIDED BY TETRA TECH EC, INC.

c:\pw_a\workdir\pw_a\p2\00153523\Fig-5B_Cap Iso View.dgn
 1/31/2016 1:56:12 PM -JRBZ



VERTICAL SCALE FOR CONSTRUCTION PURPOSES ONLY. NOT TO SCALE.

LOWER FOX RIVER REMEDIATION LLC.

FIGURE 5B

LOWER FOX RIVER - QUA

2016 TOP OF CAP ELEVATIONS

ISOMETRIC VIEW

Date: DECEMBER, 2016 Revision Date:
 Drawn By: JRBZ Checked By: TMK1 Scope: 16L029


LEGEND



CAP DESIGN PLACEMENT LIMITS


COLOR ELEVATION CHART

COLOR ISOPACH CONTOURS SHOWN REPRESENT
DEPTH CHANGE FROM NOVEMBER 13-14, 2014
TO APRIL 11, APRIL 20 AND MAY 3, 2016 SURVEYS

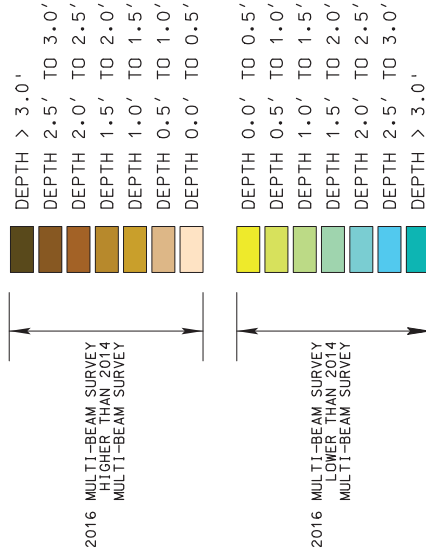


NOTES:

1. 400 KILOHERTZ (KHZ) MULTI-BEAM HYDROGRAPHIC SURVEY PERFORMED BY J.F. BRENNAN, CO. DATE OF SURVEY: APRIL 11, APRIL 20 AND MAY 3, 2016.
2. THE HORIZONTAL CONTROL IS REFERENCED TO THE NAD83 WISCONSIN STATE PLANE COORDINATE SYSTEM (WISCONSIN CENTRAL ZONE). THE VERTICAL CONTROL IS REFERENCED TO NAVD 88.
3. ORTHO PHOTO SUPPLIED BY BROWN COUNTY LAND INFORMATION OFFICE. COMPILED IN NOVEMBER 2010.
4. DESIGN CAP PLACEMENT LIMITS DERIVED FROM DESIGN FILES PROVIDED BY TETRA TECH EC, INC.

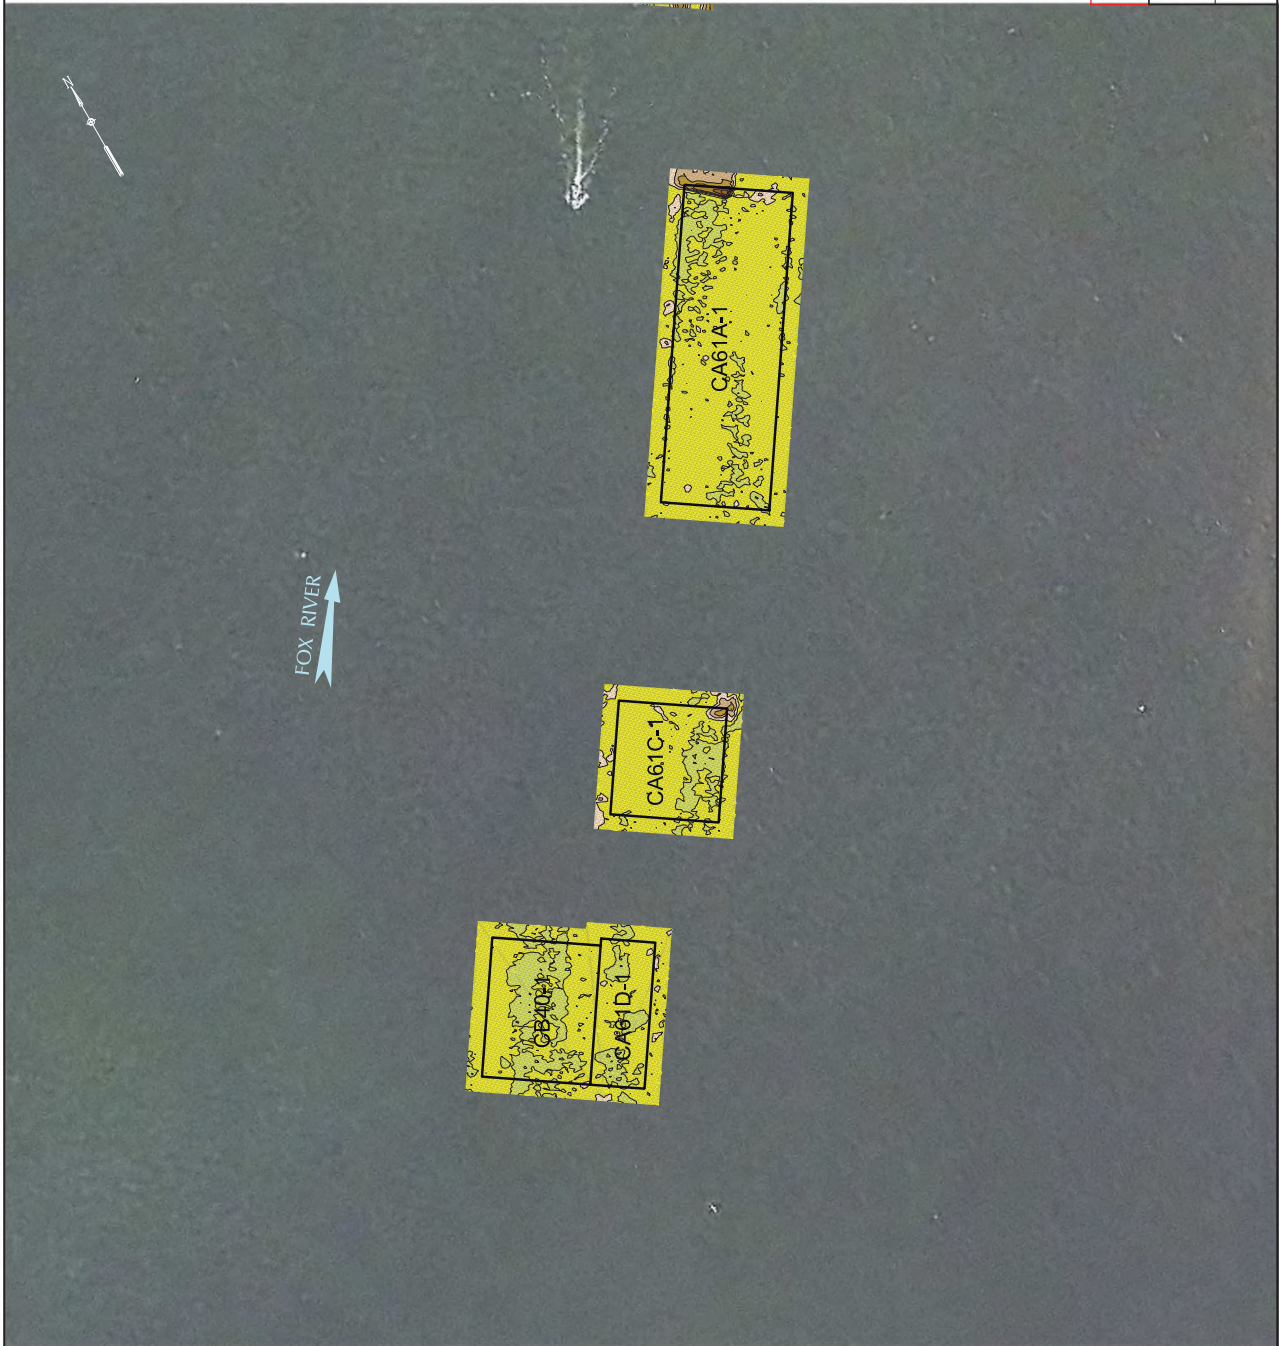

DRAFT

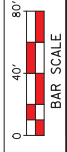


BAR SCALE


LOWER FOX RIVER REMEDIATION LLC.

FIGURE 5C
LOWER FOX RIVER - OUA
ISOPACH MAP BETWEEN THE 2014
& 2016 POST-CAPPING SURVEYS

Date:	JULY, 2016	Revision:	Date:
Drawn By:	JRBZ	Checked By:	TMK1
Scope:		16L029	

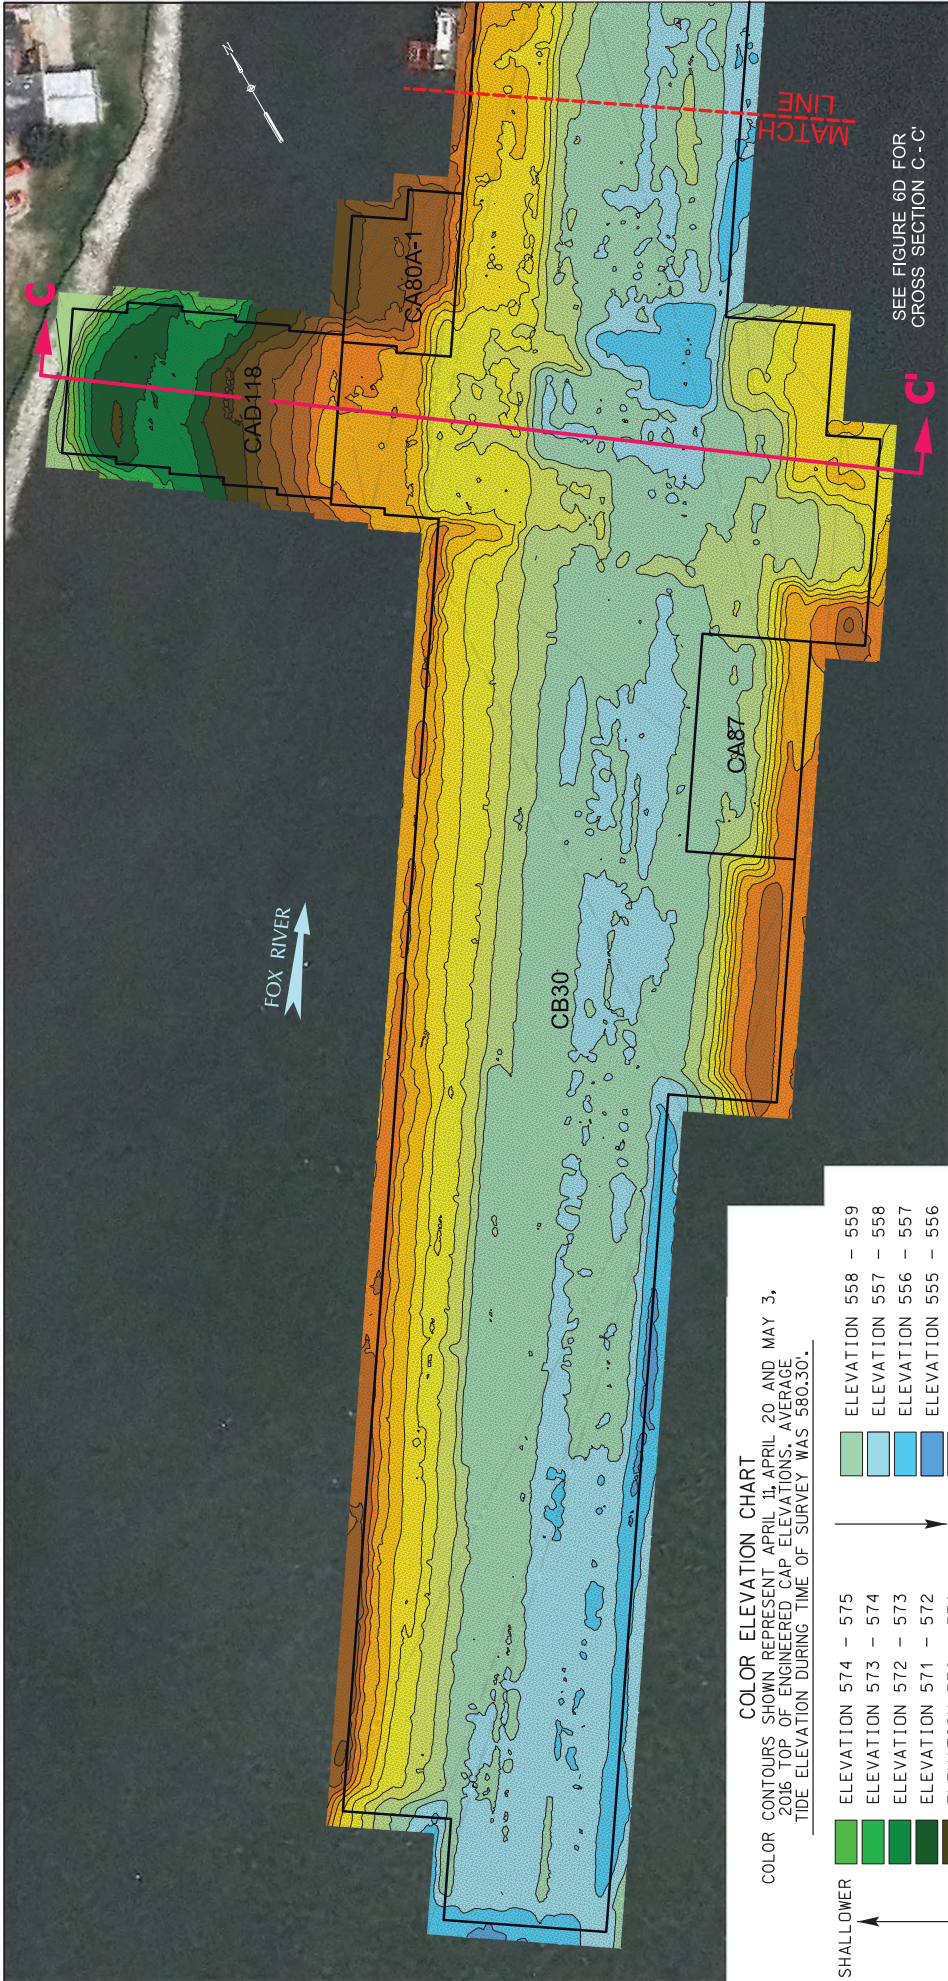

COLOR ELEVATION CHART
 COLOR CONTOURS SHOWN REPRESENT APRIL 11, APRIL 20 AND MAY 3, 2016 TOP OF ENGINEERED CAP ELEVATIONS. AVERAGE TIDE ELEVATION DURING TIME OF SURVEY WAS 580.30'

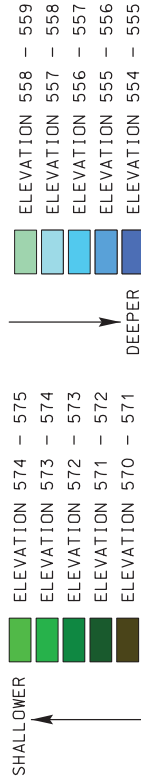


NOTES:

- 400 KILOHERTZ (KHZ) MULTI-BEAM HYDROGRAPHIC SURVEY PERFORMED BY J.F. BRENNAN, CO. DATE OF SURVEY: APRIL 11, APRIL 20 AND MAY 3, 2016.
- 200 KILOHERTZ (KHZ) SINGLE BEAM HYDROGRAPHIC SURVEY PERFORMED BY J.F. BRENNAN, CO. DATE OF SURVEY: APRIL 11, 2016.
- THE HORIZONTAL CONTROL IS REFERENCED TO THE NAD83 WISCONSIN STATE PLANE COORDINATE SYSTEM (WISCONSIN CENTRAL ZONE). THE VERTICAL CONTROL IS REFERENCED TO NAVD 88.
- ORTHO PHOTO SUPPLIED BY BROWN COUNTY LAND INFORMATION OFFICE. COMPILED IN NOVEMBER 2010.
- DESIGN CAP PLACEMENT LIMITS DERIVED FROM DESIGN FILES PROVIDED BY TETRA TECH EC, INC.
- MATCH LINES REPRESENT DUPLICATE LOCATIONS ON CONSECUTIVE FIGURES.

LEGEND

☐ CAP DESIGN PLACEMENT LIMITS



DRAFT

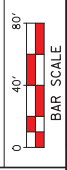

LOWER FOX RIVER REMEDIATION LLC.
FIGURE 6A
 LOWER FOX RIVER - Q14
 2016 TOP OF CAP ELEVATIONS
 PLAN VIEW

Date:	JULY, 2016	Revision Date:	
Drawn By:	JRB2	Checked By:	TMK1
Scope:	16L029		

AREA OF 2016 SINGLE BEAM SURVEYING

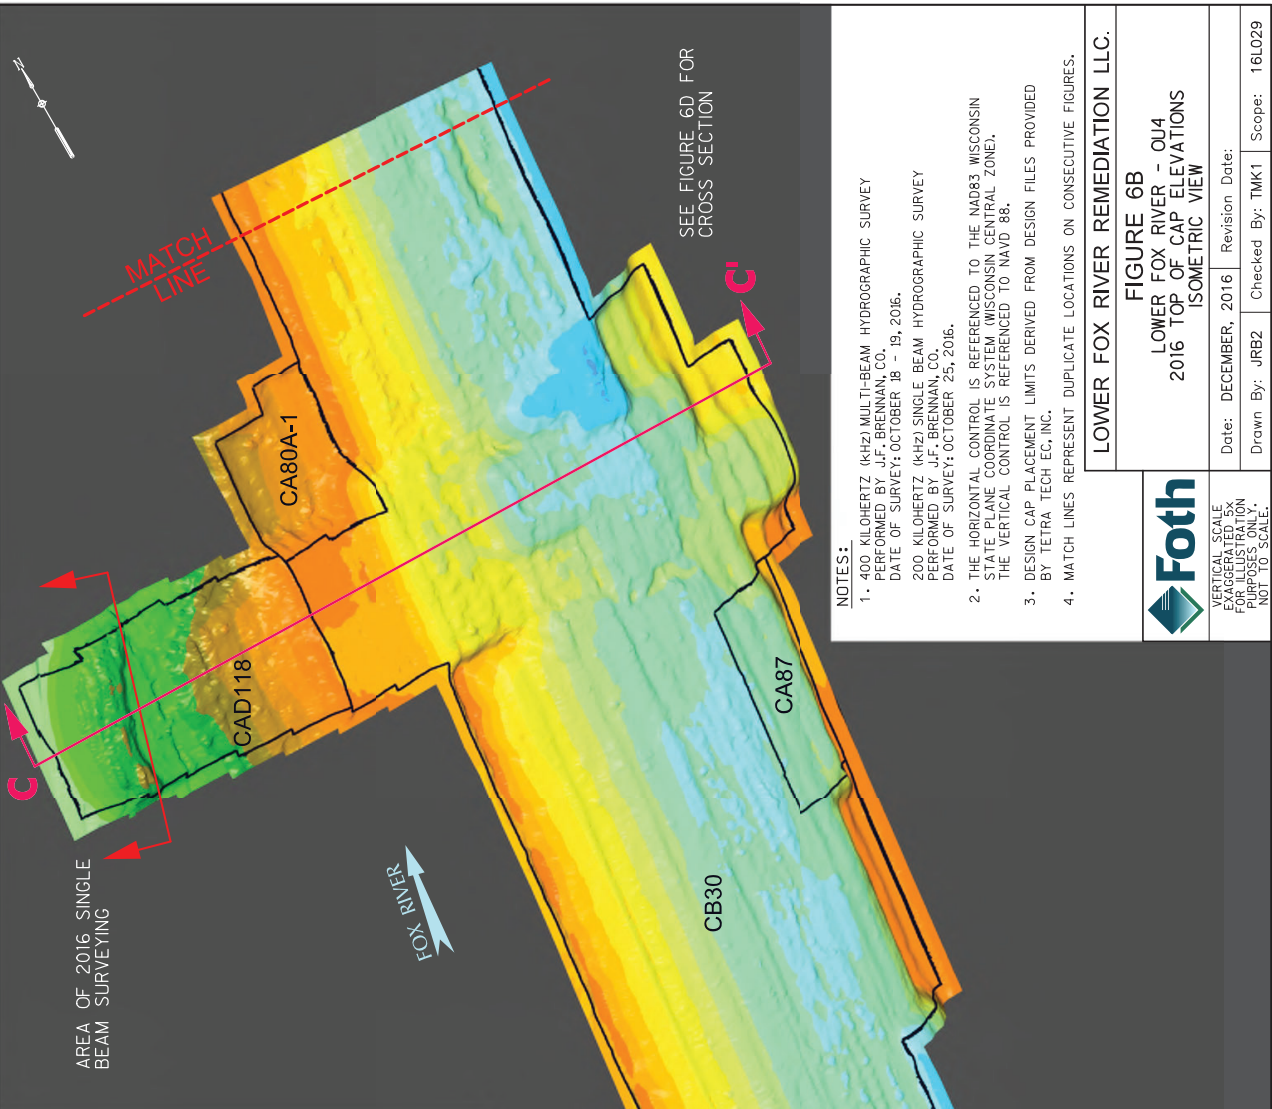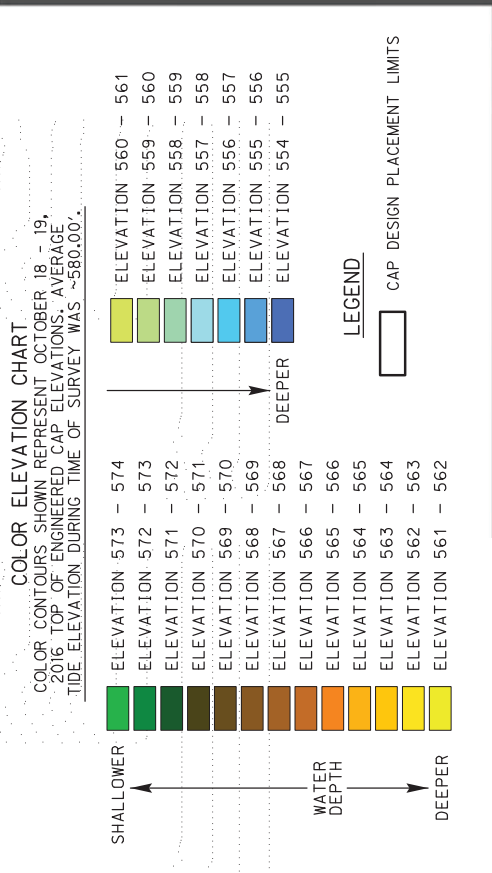

SEE FIGURE 6D FOR CROSS SECTION

NOTES:

- 400 KILOHERTZ (KH2) MULTI-BEAM HYDROGRAPHIC SURVEY PERFORMED BY J.F. BRENNAN, CO. DATE OF SURVEY: OCTOBER 18 - 19, 2016.
- 200 KILOHERTZ (KH2) SINGLE BEAM HYDROGRAPHIC SURVEY PERFORMED BY J.F. BRENNAN, CO. DATE OF SURVEY: OCTOBER 25, 2016.
- THE HORIZONTAL CONTROL IS REFERENCED TO THE NAD83 WISCONSIN STATE PLANE COORDINATE SYSTEM (WISCONSIN CENTRAL ZONE). THE VERTICAL CONTROL IS REFERENCED TO NAVD 86.
- DESIGN CAP PLACEMENT LIMITS DERIVED FROM DESIGN FILES PROVIDED BY TETRA TECH EC, INC.
- MATCH LINES REPRESENT DUPLICATE LOCATIONS ON CONSECUTIVE FIGURES.

LOWER FOX RIVER REMEDIATION LLC.

FIGURE 6B
 LOWER FOX RIVER - QUA
 2016 TOP OF CAP ELEVATIONS
 ISOMETRIC VIEW


Foth

VERTICAL SCALE FOR ELEVATION PURPOSES ONLY. NOT TO SCALE.

Date: DECEMBER, 2016	Revision Date:
Drawn By: JRB2	Checked By: TMT1
Scope: 16L029	



COLOR ELEVATION CHART
 COLOR ISOPACH CONTOURS, SHOWN REPRESENT DEPTH CHANGE FROM
 NOVEMBER 13-14, 2014 TO APRIL 11, APRIL 20 AND MAY 3, 2016 SURVEYS

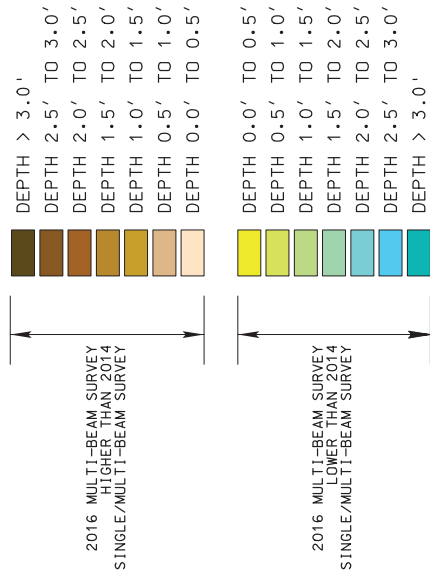


2016 MULTI-BEAM SURVEY
 HIGHER THAN 2014
 SINGLE/MULTI-BEAM SURVEY

2016 MULTI-BEAM SURVEY
 LOWER THAN 2014
 SINGLE/MULTI-BEAM SURVEY

- NOTES:**
- 400 KILOHERTZ (KHz) MULTI-BEAM HYDROGRAPHIC SURVEY PERFORMED BY J.F. BRENNAN, CO. DATE OF SURVEY: APRIL 11, APRIL 20 AND MAY 3, 2016.
 - 200 KILOHERTZ (KHz) SINGLE BEAM HYDROGRAPHIC SURVEY PERFORMED BY J.F. BRENNAN, CO. DATE OF SURVEY: APRIL 11, 2016.
 - THE HORIZONTAL CONTROL IS REFERENCED TO THE NAD83 WISCONSIN STATE PLANE COORDINATE SYSTEM (WISCONSIN CENTRAL ZONE). THE VERTICAL CONTROL IS REFERENCED TO NAVD 88.
 - ORTHO PHOTO SUPPLIED BY BROWN COUNTY LAND INFORMATION OFFICE. COMPILED IN NOVEMBER 2010.
 - DESIGN CAP PLACEMENT LIMITS DERIVED FROM DESIGN FILES PROVIDED BY TETRA TECH EC, INC.
 - MATCH LINES REPRESENT DUPLICATE LOCATIONS ON CONSECUTIVE FIGURES.



LEGEND

☐ CAP DESIGN PLACEMENT LIMITS

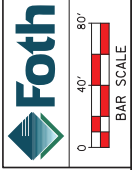

LOWER FOX RIVER REMEDIATION LLC.
FIGURE 6C
 LOWER FOX RIVER - 014
 ISOPACH MAP BETWEEN THE 2014
 & 2016 POST-CAPPING SURVEYS

Date: JULY, 2016 Revision Date:
 Drawn By: JRB2 Checked By: TMT1 Scope: 16L029

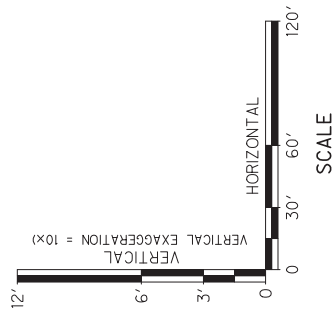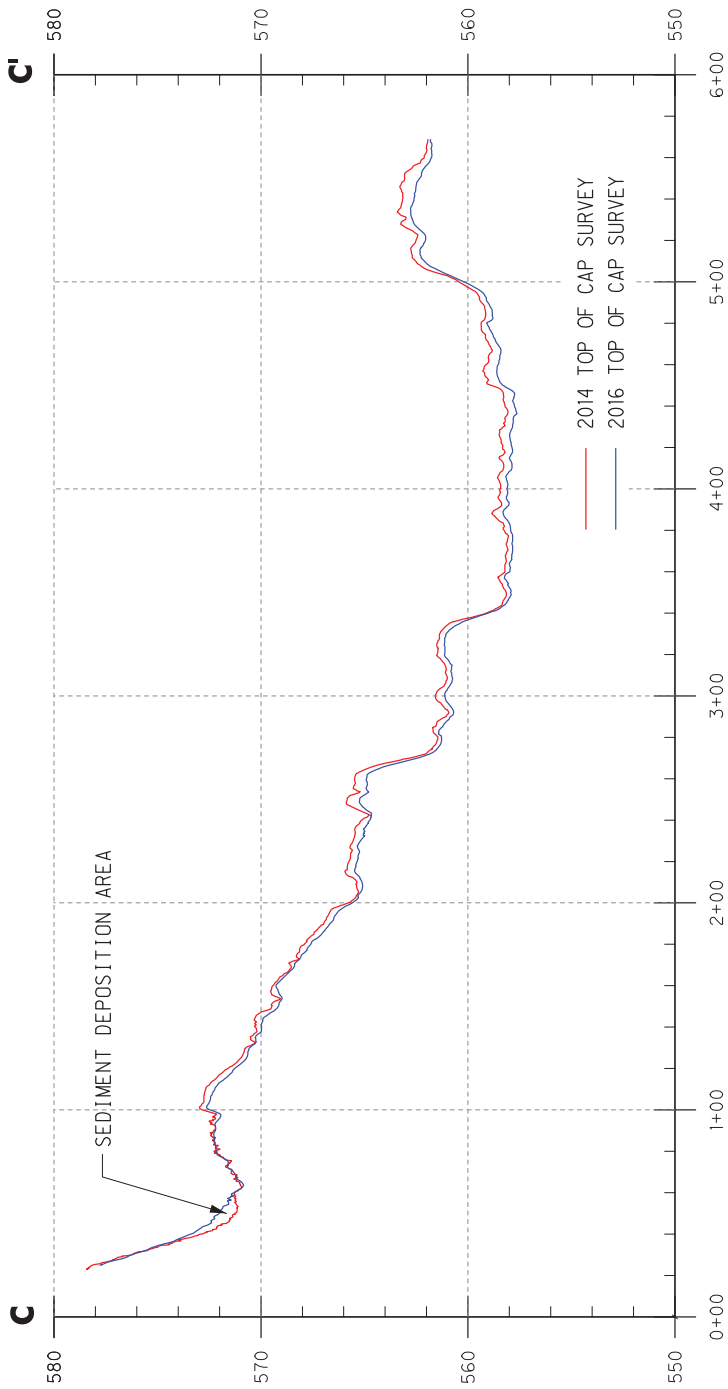

SEE FIGURES 6A, 6B & 6C FOR
CROSS SECTION LOCATIONS

LOWER FOX RIVER REMEDIATION LLC.

FIGURE 6D

LOWER FOX RIVER - OI4
TOP OF CAP CROSS SECTIONS



SCALE: AS SHOWN


Date: DECEMBER, 2016 Revision Date:

Drawn By: JRB2 Checked By: TMK1 Scope: 16L029



FOX RIVER

COLOR ELEVATION CHART
 COLOR CONTOURS SHOWN REPRESENT APRIL 11, APRIL 20 & MAY 3, 2016 TOP OF ENGINEERED CAP ELEVATIONS, AVERAGE. TIDE ELEVATION DURING TIME OF SURVEY WAS 580.30'.

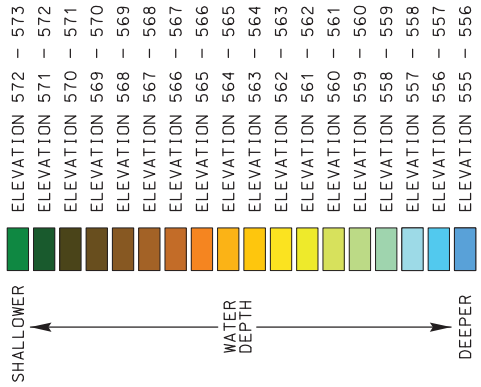

WATER DEPTH


LEGEND



CAP DESIGN PLACEMENT LIMITS

NOTES:

- 400 KILOHERTZ (KHZ) MULTI-BEAM HYDROGRAPHIC SURVEY PERFORMED BY J.F. BRENNAN, CO. DATE OF SURVEY: APRIL 11, APRIL 20 AND MAY 3, 2016.
- THE HORIZONTAL CONTROL IS REFERENCED TO THE NAD83 WISCONSIN STATE PLANE COORDINATE SYSTEM (WISCONSIN CENTRAL ZONE). THE VERTICAL CONTROL IS REFERENCED TO NAVD 88.
- ORTHO PHOTO SUPPLIED BY BROWN COUNTY LAND INFORMATION OFFICE. COMPILED IN NOVEMBER 2010.
- DESIGN CAP PLACEMENT LIMITS DERIVED FROM DESIGN FILES PROVIDED BY TETRA TECH EC, INC.
- MATCH LINES REPRESENT DUPLICATE LOCATIONS ON CONSECUTIVE FIGURES.

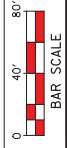

BAR SCALE

LOWER FOX RIVER REMEDIATION LLC.


FIGURE 7A

LOWER FOX RIVER - OUI4
 2016 TOP OF CAP ELEVATIONS
 PLAN VIEW

Date:	JULY, 2016	Revision:	Date:
Drawn By:	JRB2	Checked By:	TMK1
		Scope:	16L029



COLOR ELEVATION CHART
 COLOR CONTOURS SHOWN REPRESENT OCTOBER 18 - 19, 2016, TOP OF ENGINEERED CAP ELEVATIONS. AVERAGE TIDE ELEVATION DURING TIME OF SURVEY WAS ~580.00'.

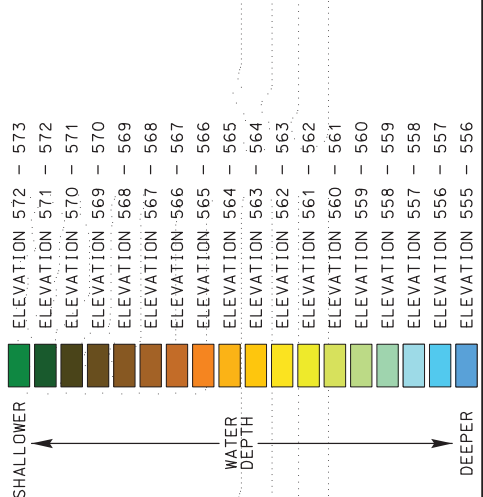


LEGEND
 [Symbol] CAP DESIGN PLACEMENT LIMITS

- NOTES:**
1. 400 KILOHERTZ (KHz) MULTI-BEAM HYDROGRAPHIC SURVEY PERFORMED BY J.F. BRENNAN, CO., 18, 2016. DATE OF SURVEY: OCTOBER 18 - 19, 2016.
 2. THE HORIZONTAL CONTROL IS REFERENCED TO THE NAD83 WISCONSIN STATE PLANE COORDINATE SYSTEM (WISCONSIN CENTRAL ZONE). THE VERTICAL CONTROL IS REFERENCED TO NAVD 88.
 3. DESIGN CAP PLACEMENT LIMITS DERIVED FROM DESIGN FILES PROVIDED BY TETRA TECH EC, INC.
 4. MATCH LINES REPRESENT DUPLICATE LOCATIONS ON CONSECUTIVE FIGURES.




LOWER FOX RIVER REMEDIATION LLC.
FIGURE 7B
 LOWER FOX RIVER - QUA
 2016 TOP OF CAP ELEVATIONS
 ISOMETRIC VIEW

Date: DECEMBER, 2016 | Revision Date:
 Drawn By: JRB2 | Checked By: TMK1 | Scope: 16L029

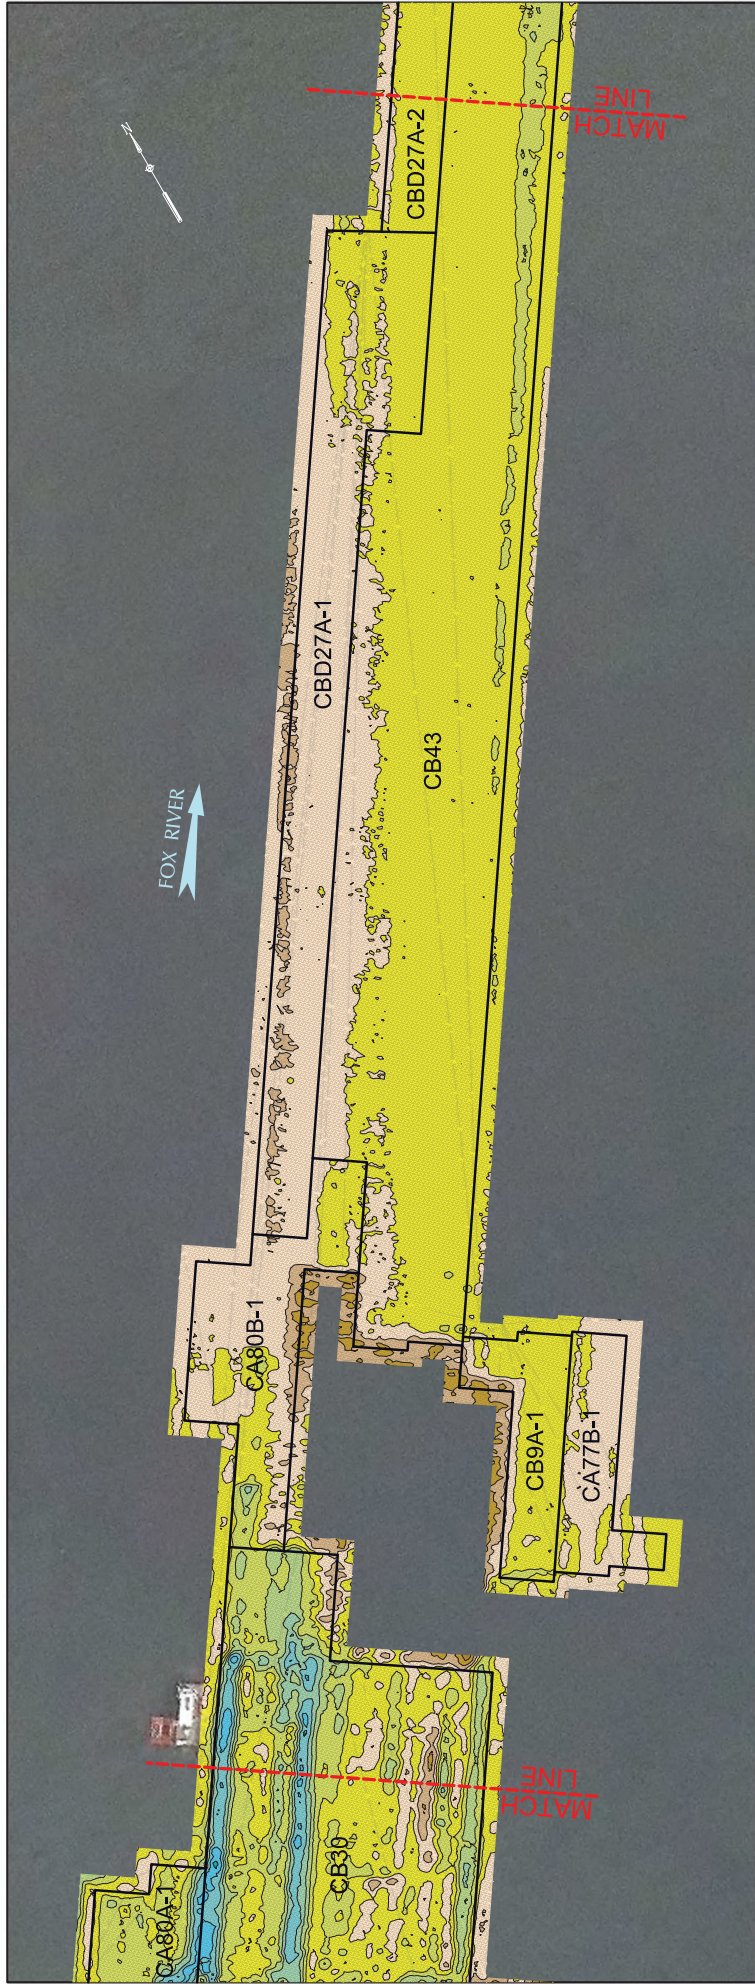

COLOR ELEVATION CHART
 COLOR ISOPACH CONTOURS, SHOWN REPRESENT DEPTH CHANGE FROM
 NOVEMBER 13-14, 2014 TO APRIL 11, APRIL 20 AND MAY 3, 2016 SURVEYS

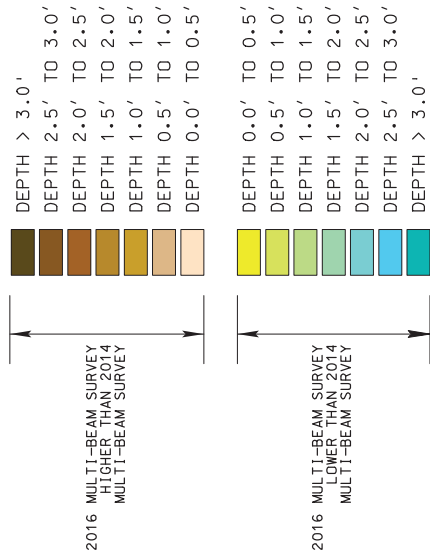


LEGEND

☐ CAP DESIGN PLACEMENT LIMITS

NOTES:


- 400 KILOHERTZ (KHZ) MULTI-BEAM HYDROGRAPHIC SURVEY PERFORMED BY J.F. BRENNAN, CO. DATE OF SURVEY: APRIL 11, APRIL 20 AND MAY 3, 2016.
- THE HORIZONTAL CONTROL IS REFERENCED TO THE NAD83 WISCONSIN STATE PLANE COORDINATE SYSTEM (WISCONSIN CENTRAL ZONE). THE VERTICAL CONTROL IS REFERENCED TO NAVD 88.
- ORTHO PHOTO SUPPLIED BY BROWN COUNTY LAND INFORMATION OFFICE. COMPILED IN NOVEMBER 2010.
- DESIGN CAP PLACEMENT LIMITS DERIVED FROM DESIGN FILES PROVIDED BY TETRA TECH EC, INC.
- MATCH LINES REPRESENT DUPLICATE LOCATIONS ON CONSECUTIVE FIGURES.

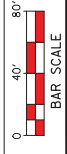


LOWER FOX RIVER REMEDIATION LLC.

FIGURE 7C
 LOWER FOX RIVER - OUI4
 ISOPACH MAP BETWEEN THE 2014
 & 2016 POST-CAPPING SURVEYS

Date:	JULY, 2016	Revision:	Date:
Drawn By:	JRB2	Checked By:	TMK1
		Scope:	16L029

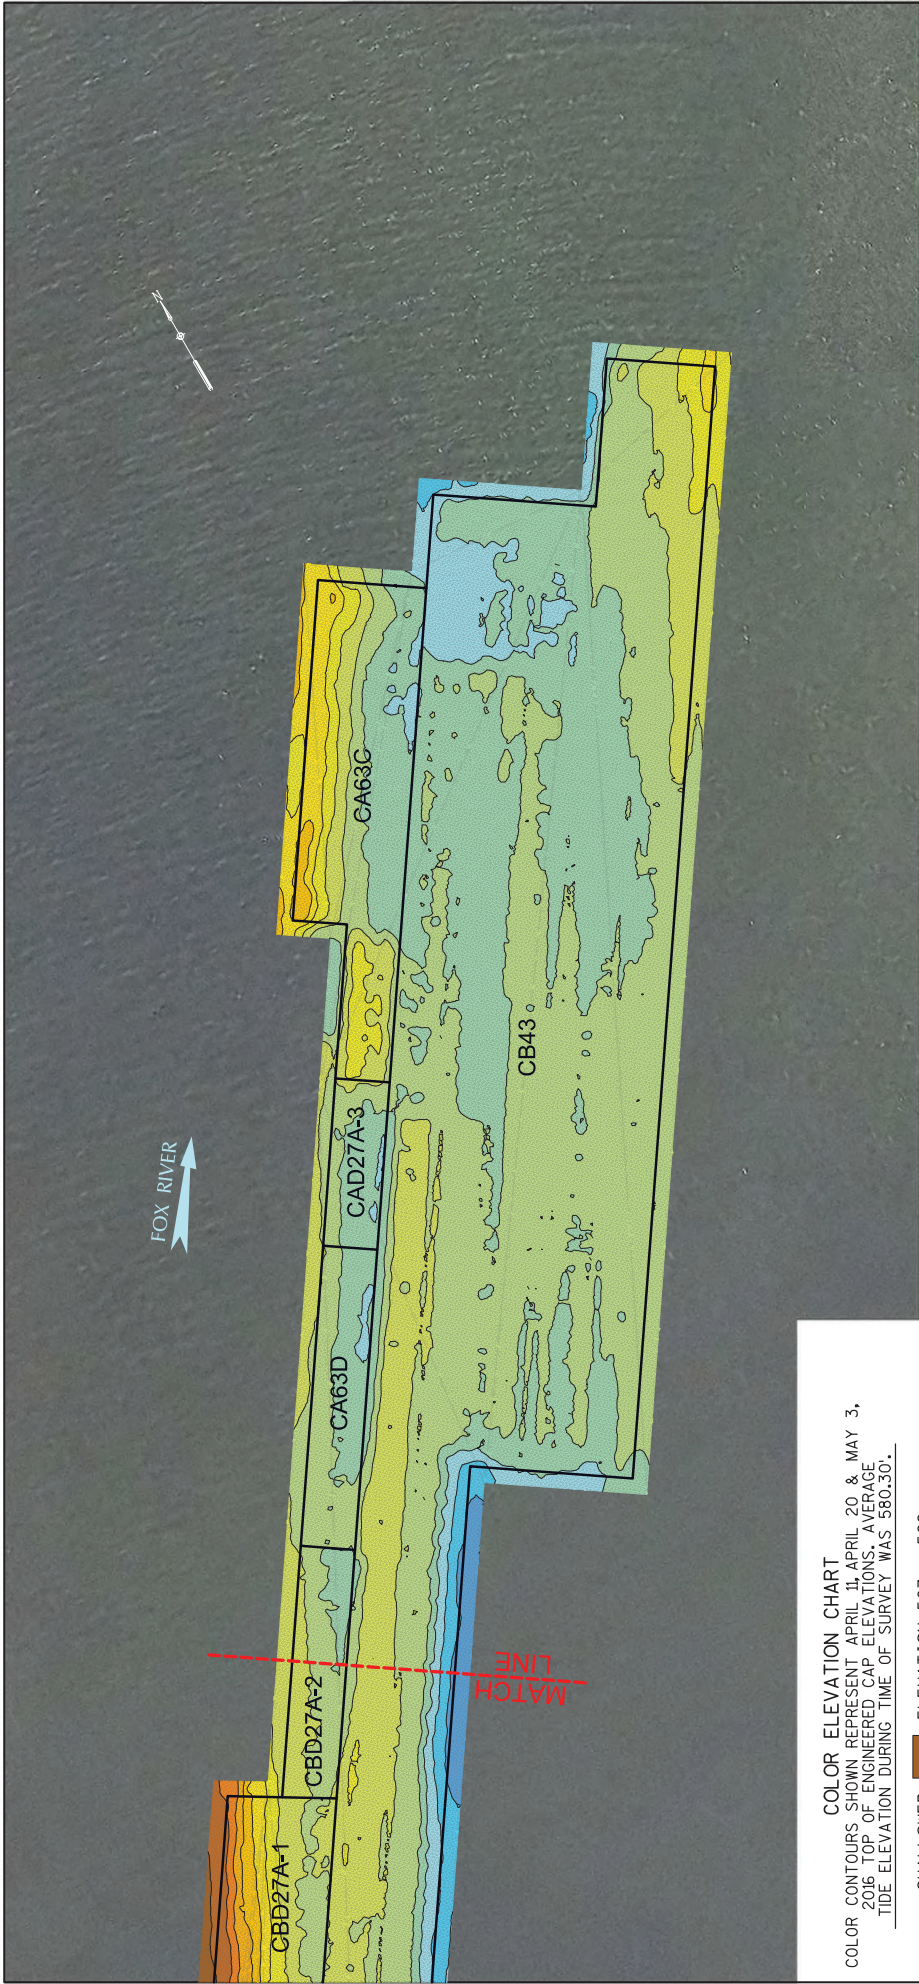

COLOR ELEVATION CHART
 COLOR CONTOURS SHOWN REPRESENT APRIL 11, APRIL 20 & MAY 3, 2016 TOP OF ENGINEERED CAP ELEVATIONS. AVERAGE TIDE ELEVATION DURING TIME OF SURVEY WAS 580.30'.

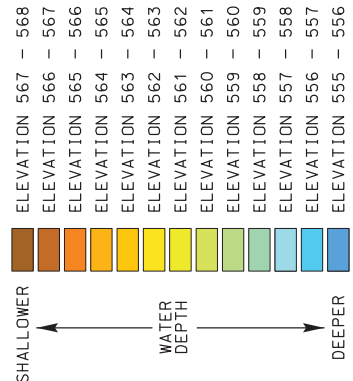

LEGEND
 [Symbol] CAP DESIGN PLACEMENT LIMITS


- NOTES:**
- 400 KILOHERTZ (KHZ) MULTI-BEAM HYDROGRAPHIC SURVEY PERFORMED BY J.F. BRENNAN, CO. DATE OF SURVEY: APRIL 11, APRIL 20 AND MAY 3, 2016.
 - THE HORIZONTAL CONTROL IS REFERENCED TO THE NAD83 WISCONSIN STATE PLANE COORDINATE SYSTEM (WISCONSIN CENTRAL ZONE). THE VERTICAL CONTROL IS REFERENCED TO NAVD 88.
 - ORTHO PHOTO SUPPLIED BY BROWN COUNTY LAND INFORMATION OFFICE. COMPILED IN NOVEMBER 2016.
 - DESIGN CAP PLACEMENT LIMITS DERIVED FROM DESIGN FILES PROVIDED BY TETRA TECH EC, INC.
 - MATCH LINES REPRESENT DUPLICATE LOCATIONS ON CONSECUTIVE FIGURES.

0 40' 80'
 BAR SCALE

LOWER FOX RIVER REMEDIATION LLC.			
FIGURE 8A			
LOWER FOX RIVER - QUA			
2016 TOP OF CAP ELEVATIONS			
PLAN VIEW			
Date:	JULY, 2016	Revision Date:	
Drawn By:	JRB2	Checked By:	TMK1
Scope:	16L029		



COLOR ELEVATION CHART
 COLOR CONTOURS SHOWN REPRESENT OCTOBER 18 - 19, 2016 TOP OF ENGINEERED CAP ELEVATIONS. AVERAGE TIDE ELEVATION DURING TIME OF SURVEY WAS ~580.00'.

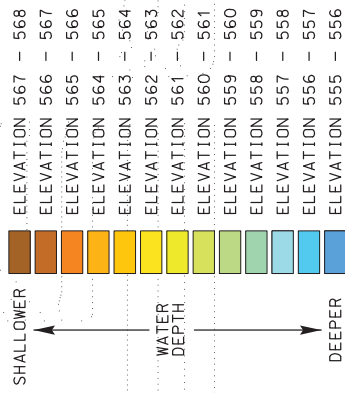

LEGEND

 CAP DESIGN PLACEMENT LIMITS

- NOTES:**
1. 400 KILBERTZ (442) MULTI-BEAM HYDROGRAPHIC SURVEY PERFORMED BY J.F. BERGMAN CO. CO. 19, 2016. DATE OF SURVEY: OCTOBER 18 - 19, 2016.
 2. THE HORIZONTAL CONTROL IS REFERENCED TO THE NAD83 WISCONSIN STATE PLANE COORDINATE SYSTEM (WISCONSIN CENTRAL ZONE). THE VERTICAL CONTROL IS REFERENCED TO NAVD 88.
 3. DESIGN CAP PLACEMENT LIMITS DERIVED FROM DESIGN FILES PROVIDED BY TETRA TECH EC, INC.




VERTICAL SCALE FOR ILLUSTRATION PURPOSES ONLY. NOT TO SCALE.

LOWER FOX RIVER REMEDIATION LLC.


FIGURE 8B
 LOWER FOX RIVER - QUA
 2016 TOP OF CAP ELEVATIONS
 ISOMETRIC VIEW

Date: DECEMBER, 2016 | Revision Date:
 Drawn By: JRB2 | Checked By: TMK1 | Scope: 16L029

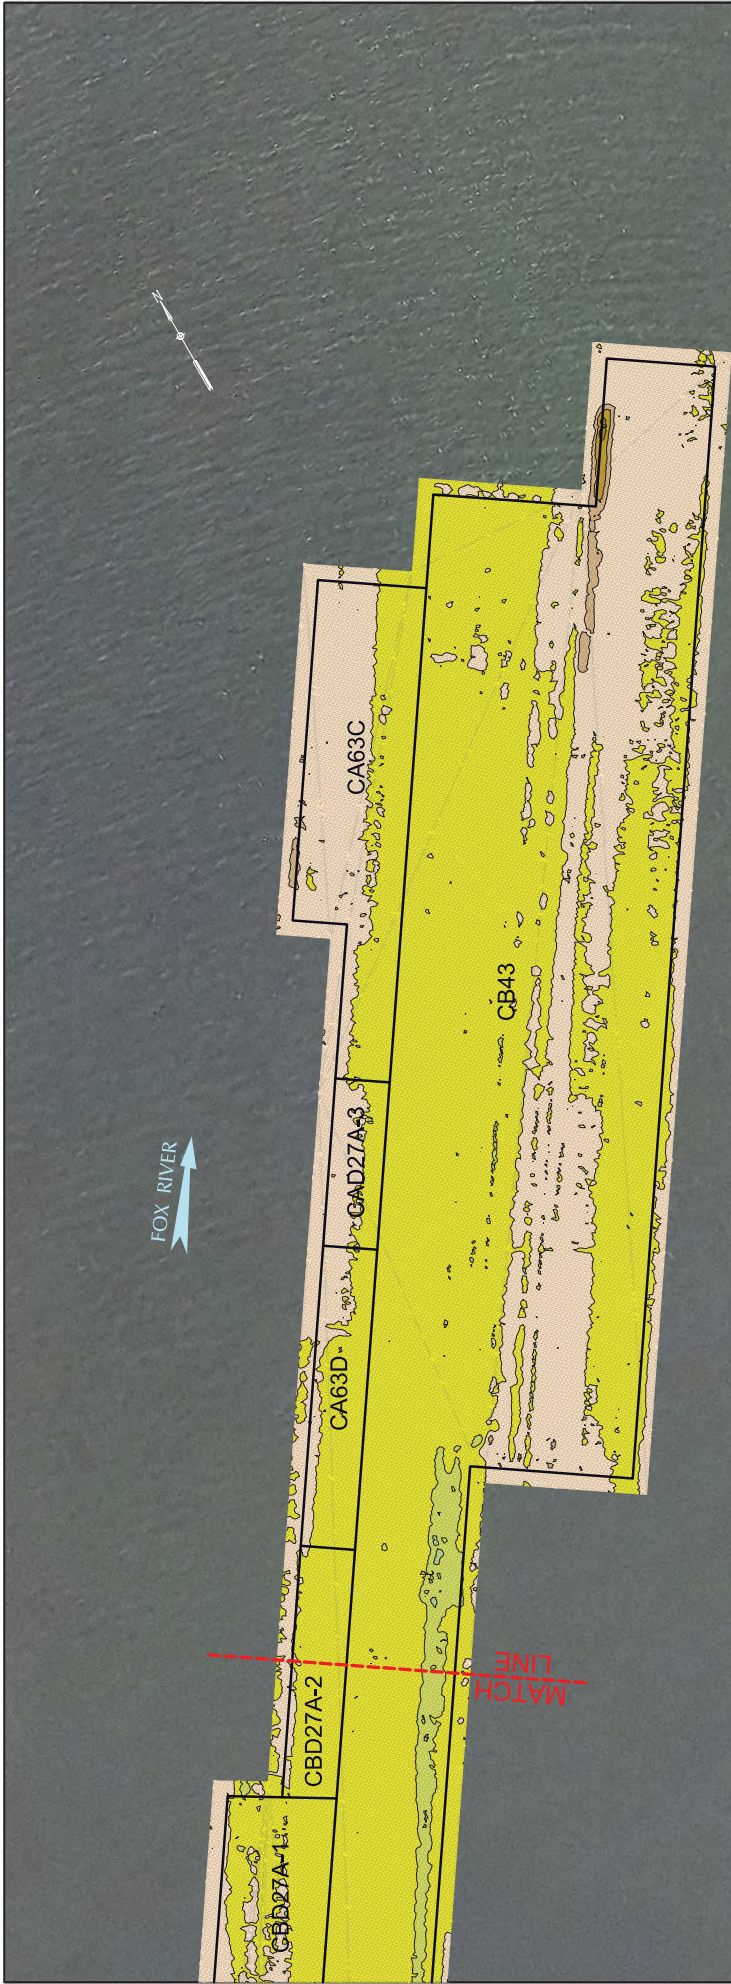

FOX RIVER

COLOR ELEVATION CHART
 COLOR ISOPACH CONTOURS SHOWN REPRESENT DEPTH CHANGE FROM
 NOVEMBER 13-14, 2014 TO APRIL 20 AND MAY 3, 2016 SURVEYS

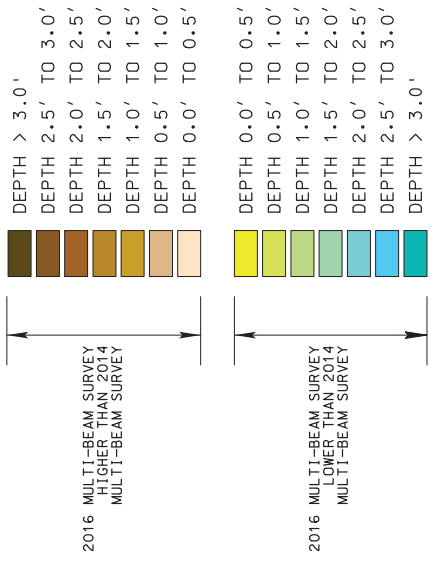

LEGEND
 CAP DESIGN PLACEMENT LIMITS

- NOTES:**
- 400 KILOHERTZ (KHZ) MULTI-BEAM HYDROGRAPHIC SURVEY PERFORMED BY J.F. BRENNAN, CO. DATE OF SURVEY: APRIL 20 AND MAY 3, 2016.
 - THE HORIZONTAL CONTROL IS REFERENCED TO THE NAD83 WISCONSIN STATE PLANE COORDINATE SYSTEM (WISCONSIN CENTRAL ZONE). THE VERTICAL CONTROL IS REFERENCED TO NAVD 88.
 - ORTHO PHOTO SUPPLIED BY BROWN COUNTY LAND INFORMATION OFFICE. COMPILED IN NOVEMBER 2016.
 - DESIGN CAP PLACEMENT LIMITS DERIVED FROM DESIGN FILES PROVIDED BY TETRA TECH EC, INC.
 - MATCH LINES REPRESENT DUPLICATE LOCATIONS ON CONSECUTIVE FIGURES.

0 40' 80'
 BAR SCALE

LOWER FOX RIVER REMEDIATION LLC.	
FIGURE 8C	
LOWER FOX RIVER - OUA	
ISOPACH MAP BETWEEN THE 2014	
& 2016 POST-CAPPING SURVEYS	
Date: JULY, 2016	Revision Date:
Drawn By: JRB2	Checked By: TMT1
Scope: 16L029	

LEGEND


□ CAP DESIGN PLACEMENT LIMITS

NOTES:

1. 400 KILOHERTZ (kHz) MULTI-BEAM HYDROGRAPHIC SURVEY PERFORMED BY J.F. BRENNAN, CO. DATE OF SURVEY: OCTOBER 18 - 19, 2016.
2. 200 KILOHERTZ (kHz) SINGLE BEAM HYDROGRAPHIC SURVEY PERFORMED BY J.F. BRENNAN, CO. DATE OF SURVEY: OCTOBER 25, 2016.
3. THE HORIZONTAL CONTROL IS REFERENCED TO THE NAD83 WISCONSIN STATE PLANE COORDINATE SYSTEM (WISCONSIN CENTRAL ZONE). THE VERTICAL CONTROL IS REFERENCED TO NAVD 88.
4. ORTHO PHOTO SUPPLIED BY BROWN COUNTY LAND INFORMATION OFFICE. COMPILED IN NOVEMBER 2010.
5. DESIGN CAP PLACEMENT LIMITS DERIVED FROM DESIGN FILES PROVIDED BY TETRA TECH EC, INC.
6. MATCH LINES REPRESENT DUPLICATE LOCATIONS ON CONSECUTIVE FIGURES.


COLOR ELEVATION CHART
 COLOR CONTOURS SHOWN REPRESENT OCTOBER 18 - 19, 2016 TOP OF ENGINEERED CAP ELEVATIONS. AVERAGE TIDE ELEVATION DURING TIME OF SURVEY WAS ~580.00'.

SHALLOWER ↑ WATER DEPTH ↓ DEEPER	ELEVATION 576 - 577
	ELEVATION 575 - 576
	ELEVATION 574 - 575
	ELEVATION 573 - 574
	ELEVATION 572 - 573
	ELEVATION 571 - 572
	ELEVATION 570 - 571
	ELEVATION 569 - 570
	ELEVATION 568 - 569
	ELEVATION 567 - 568
	ELEVATION 566 - 567
	ELEVATION 565 - 566
	ELEVATION 564 - 565
	ELEVATION 563 - 564
	ELEVATION 562 - 563
	ELEVATION 561 - 562
	ELEVATION 560 - 561
	ELEVATION 559 - 560
	ELEVATION 558 - 559
	ELEVATION 557 - 558
ELEVATION 556 - 557	
ELEVATION 555 - 556	
ELEVATION 554 - 555	

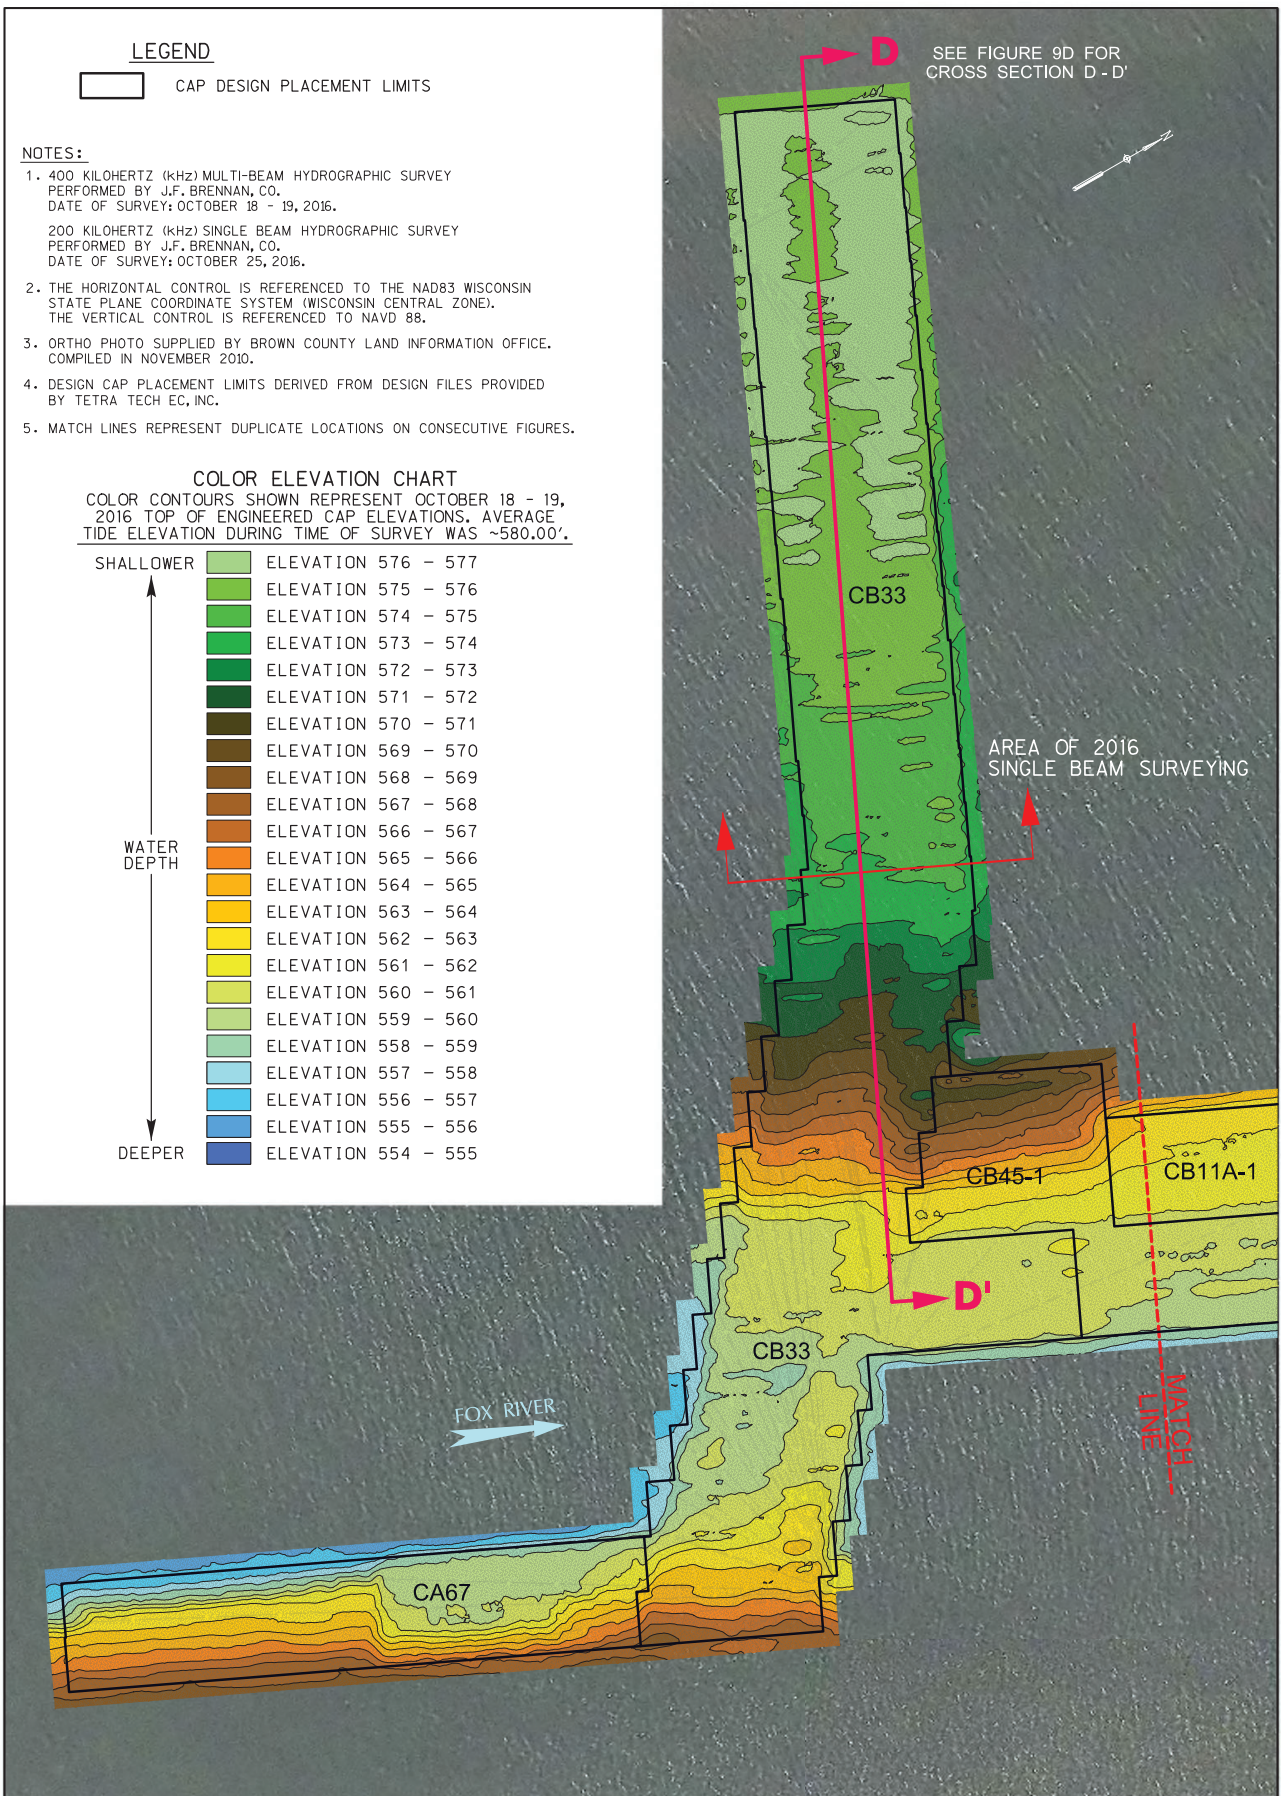


LOWER FOX RIVER REMEDIATION LLC.

FIGURE 9A
 LOWER FOX RIVER - OU4
 2016 TOP OF CAP ELEVATIONS
 PLAN VIEW

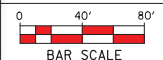

Date: DECEMBER, 2016	Revision Date:
Drawn By: JRB2	Checked By: TMK1
Scope: 16L029	

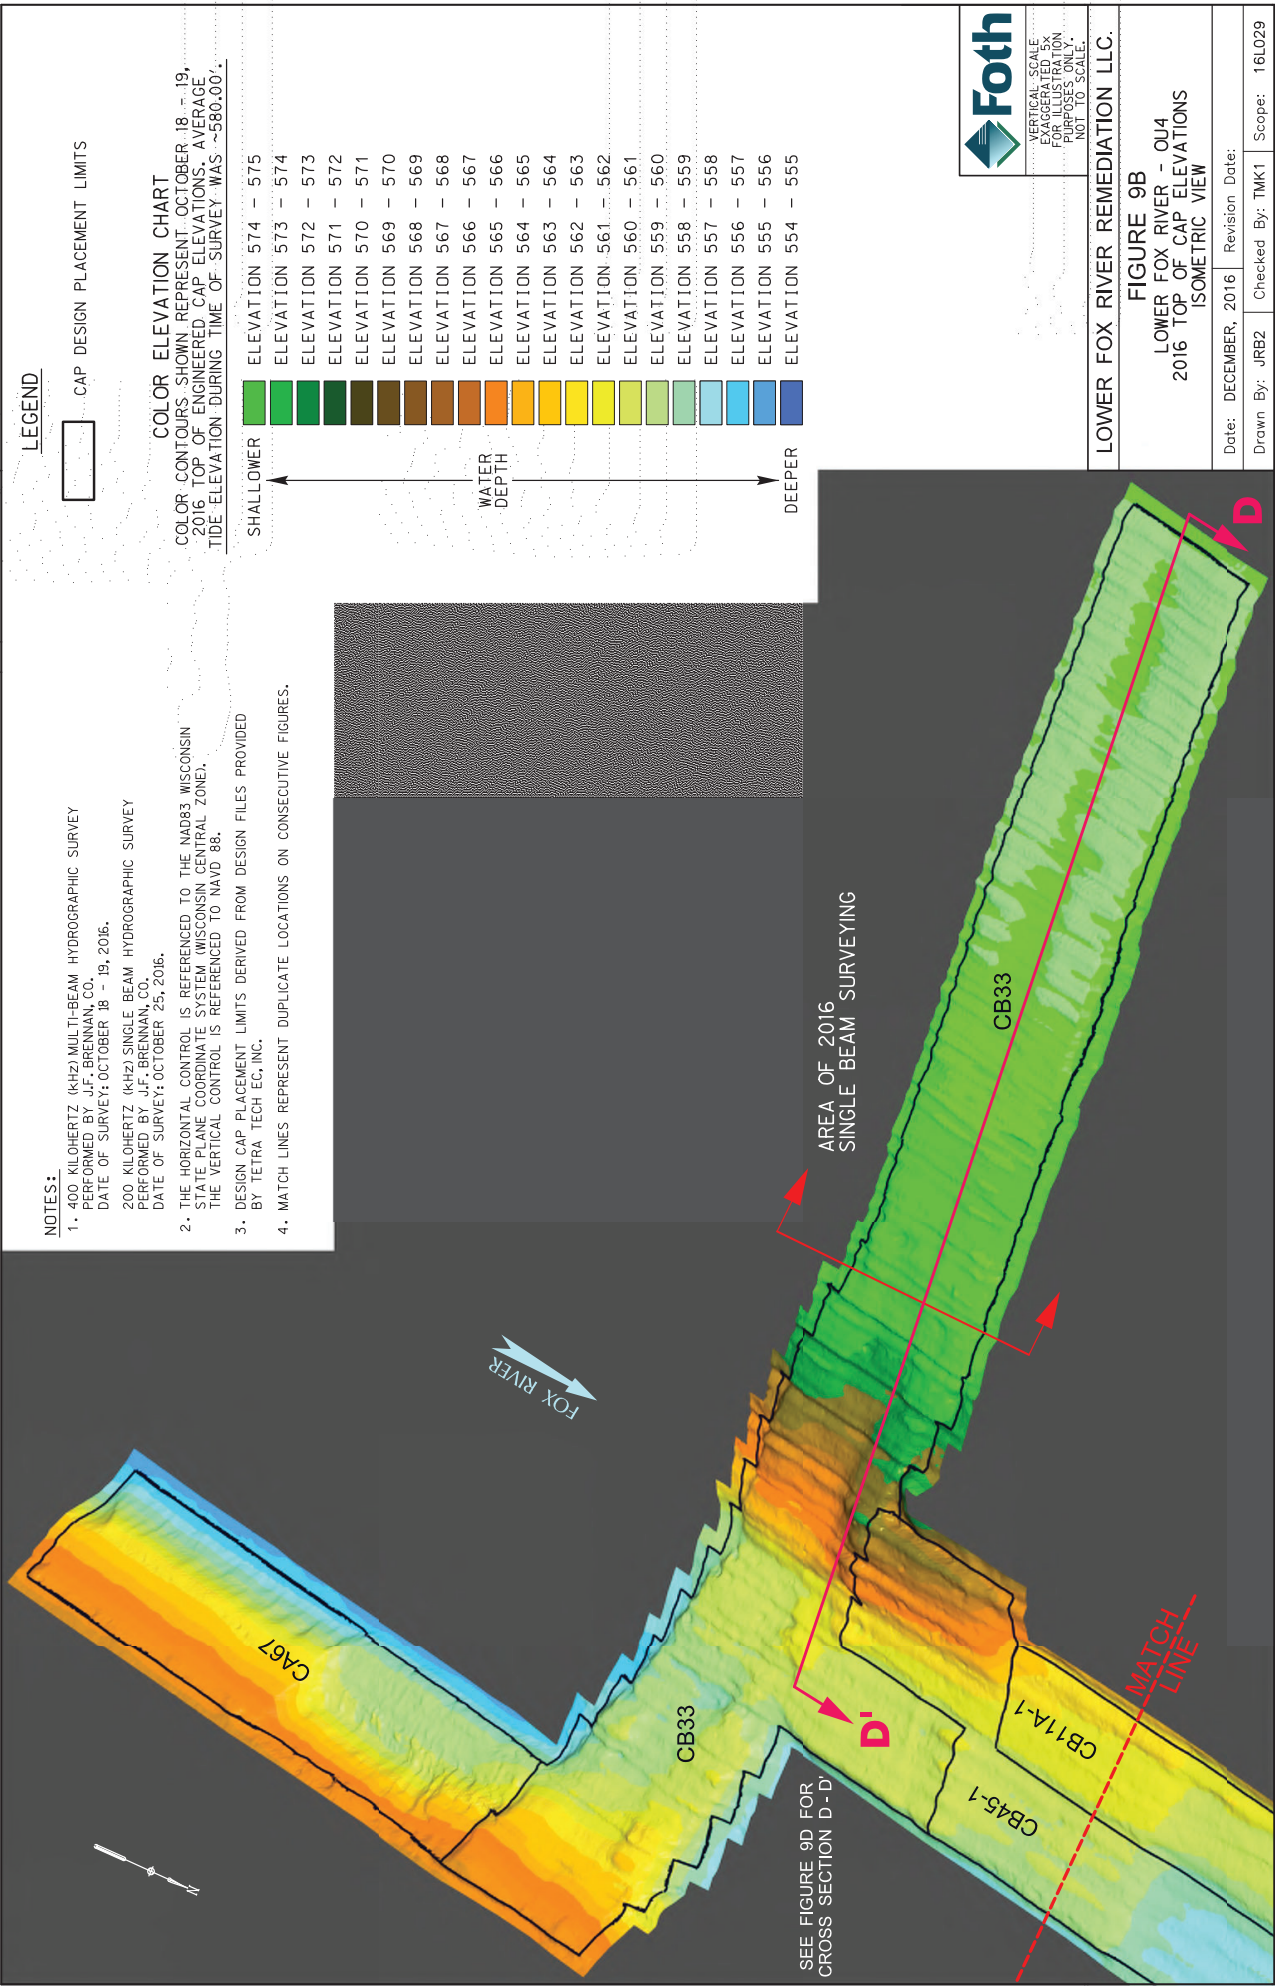

NOTES:


1. 400 KILOHERTZ (KHZ) MULTI-BEAM HYDROGRAPHIC SURVEY PERFORMED BY J.F. BRENNAN, CO. DATE OF SURVEY: OCTOBER 18 - 19, 2016.
- 200 KILOHERTZ (KHZ) SINGLE BEAM HYDROGRAPHIC SURVEY PERFORMED BY J.F. BRENNAN, CO. DATE OF SURVEY: OCTOBER 25, 2016.
2. THE HORIZONTAL CONTROL IS REFERENCED TO THE NAD83 WISCONSIN STATE PLANE COORDINATE SYSTEM (WISCONSIN CENTRAL ZONE). THE VERTICAL CONTROL IS REFERENCED TO NAVD 88.
3. DESIGN CAP PLACEMENT LIMITS DERIVED FROM DESIGN FILES PROVIDED BY TETRA TECH EC, INC.
4. MATCH LINES REPRESENT DUPLICATE LOCATIONS ON CONSECUTIVE FIGURES.

LEGEND



COLOR ELEVATION CHART

COLOR CONTOURS SHOWN REPRESENT OCTOBER 18 - 19, 2016 TOP OF ENGINEERED CAP ELEVATIONS, AVERAGE TIDE ELEVATION DURING TIME OF SURVEY WAS ~580.00'.

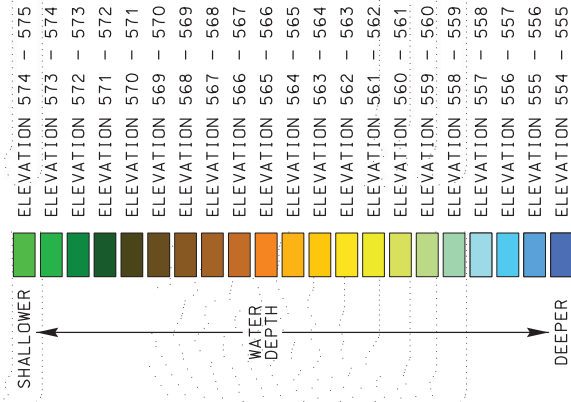




VERTICAL SCALE
EXAGGERATED 5X
FOR ILLUSTRATION
PURPOSES ONLY
NOT TO SCALE.

LOWER FOX RIVER REMEDIATION LLC.			
FIGURE 9B			
LOWER FOX RIVER - QUA			
2016 TOP OF CAP ELEVATIONS			
ISOMETRIC VIEW			
Date: DECEMBER, 2016	Revision Date:	Checked By: TMK1	Scope: 16L029
Drawn By: JRB2			

SEE FIGURE 9D FOR CROSS SECTION D-D'

MATCH LINE



LEGEND

-  CAP DESIGN PLACEMENT LIMITS
-  170' GRID LINES USED FOR POLING LOCATIONS
-  ACTUAL CAP POLING/PROBING LOCATION AND IDENTIFICATION WITH MEASURED SEDIMENT THICKNESS

NOTES:

1. 400 KILOHERTZ (KHZ) MULTI-BEAM HYDROGRAPHIC SURVEY PERFORMED BY J.F. BRENNAN, CO. DATE OF SURVEY: OCTOBER 18 - 19, 2016.
2. 200 KILOHERTZ (KHZ) SINGLE BEAM HYDROGRAPHIC SURVEY PERFORMED BY J.F. BRENNAN, CO. DATE OF SURVEY: OCTOBER 25, 2016.
2. THE HORIZONTAL CONTROL IS REFERENCED TO THE NAD83 WISCONSIN STATE PLANE COORDINATE SYSTEM (WISCONSIN CENTRAL ZONE). THE VERTICAL CONTROL IS REFERENCED TO NAVD 88.
3. ORTHO PHOTO SUPPLIED BY BROWN COUNTY LAND INFORMATION OFFICE. COMPILED IN NOVEMBER 2010.
4. MATCH LINES REPRESENT DUPLICATE LOCATIONS ON CONSECUTIVE FIGURES.
5. DESIGN CAP PLACEMENT LIMITS DERIVED FROM DESIGN FILES PROVIDED BY TETRA TECH EC, INC.
6. CAP POLING/PROBING PERFORMED BY FOTH ON NOVEMBER 3 - 4, 2016.

COLOR ELEVATION CHART
 COLOR ISOPACH CONTOURS SHOWN REPRESENT DEPTH CHANGE FROM NOVEMBER 13-14, 2014 TO OCTOBER 18, 19 & 25, 2016 SURVEYS

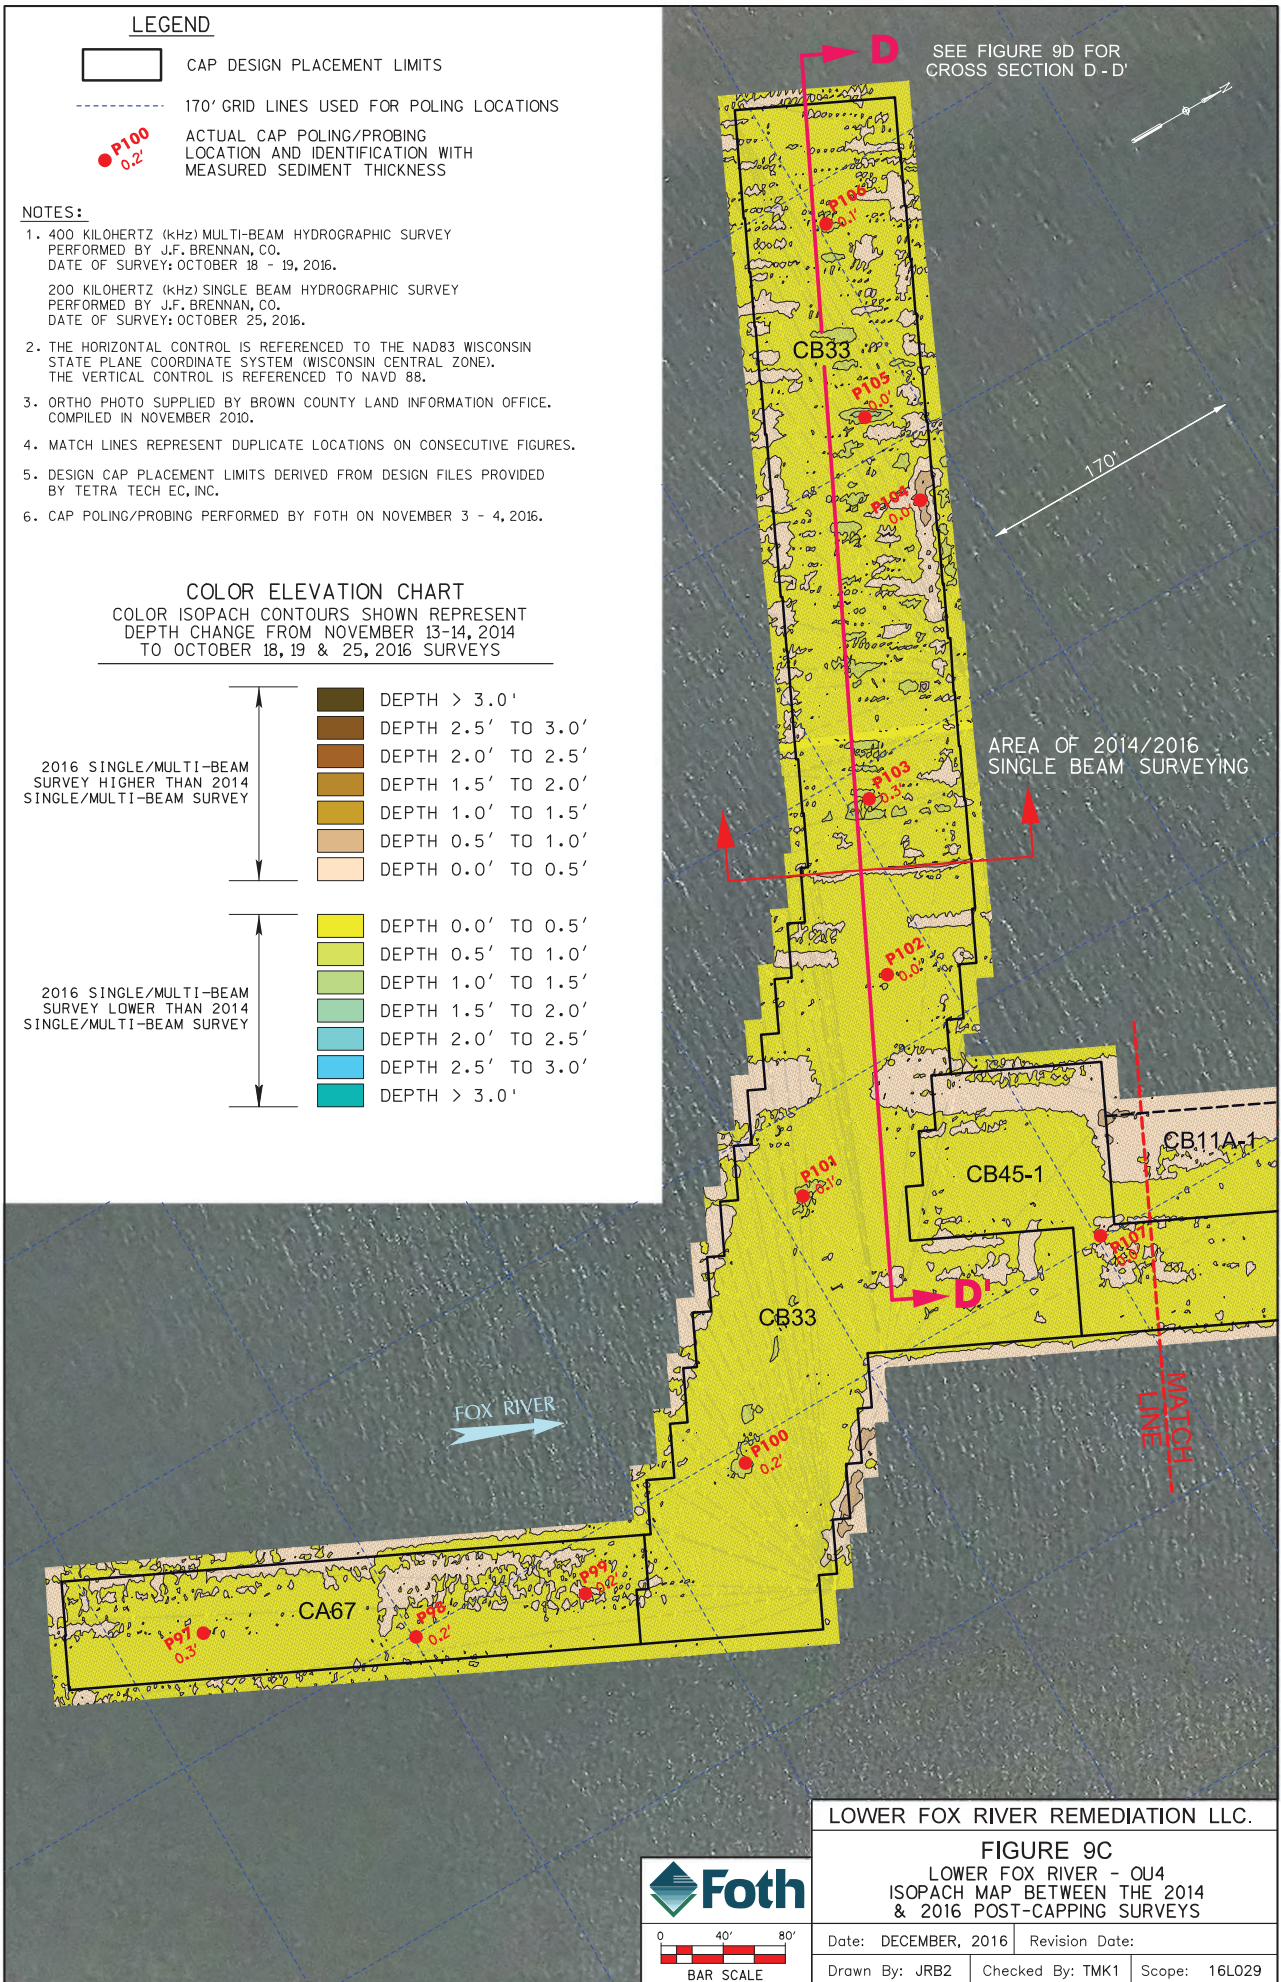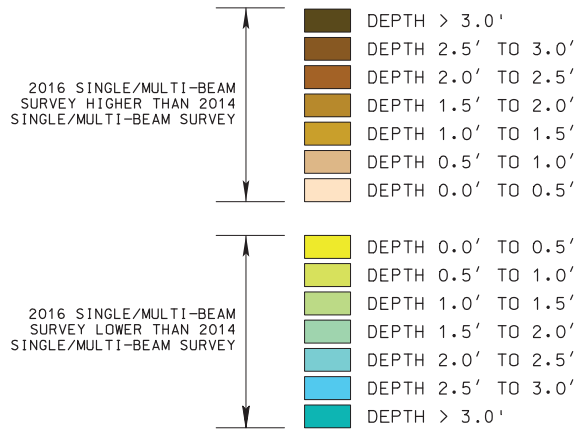

SEE FIGURE 9D FOR CROSS SECTION D-D'


AREA OF 2014/2016 SINGLE BEAM SURVEYING

FOX RIVER



MATCH LINE

LOWER FOX RIVER REMEDIATION LLC.

FIGURE 9C
 LOWER FOX RIVER - OU4
 ISOPACH MAP BETWEEN THE 2014 & 2016 POST-CAPPING SURVEYS

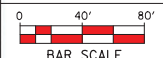

Date: DECEMBER, 2016	Revision Date:
Drawn By: JRB2	Checked By: TMK1
Scope: 16L029	

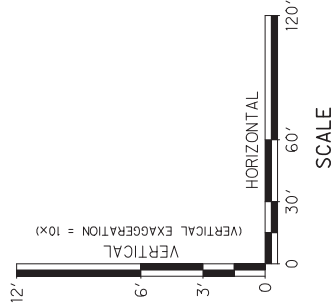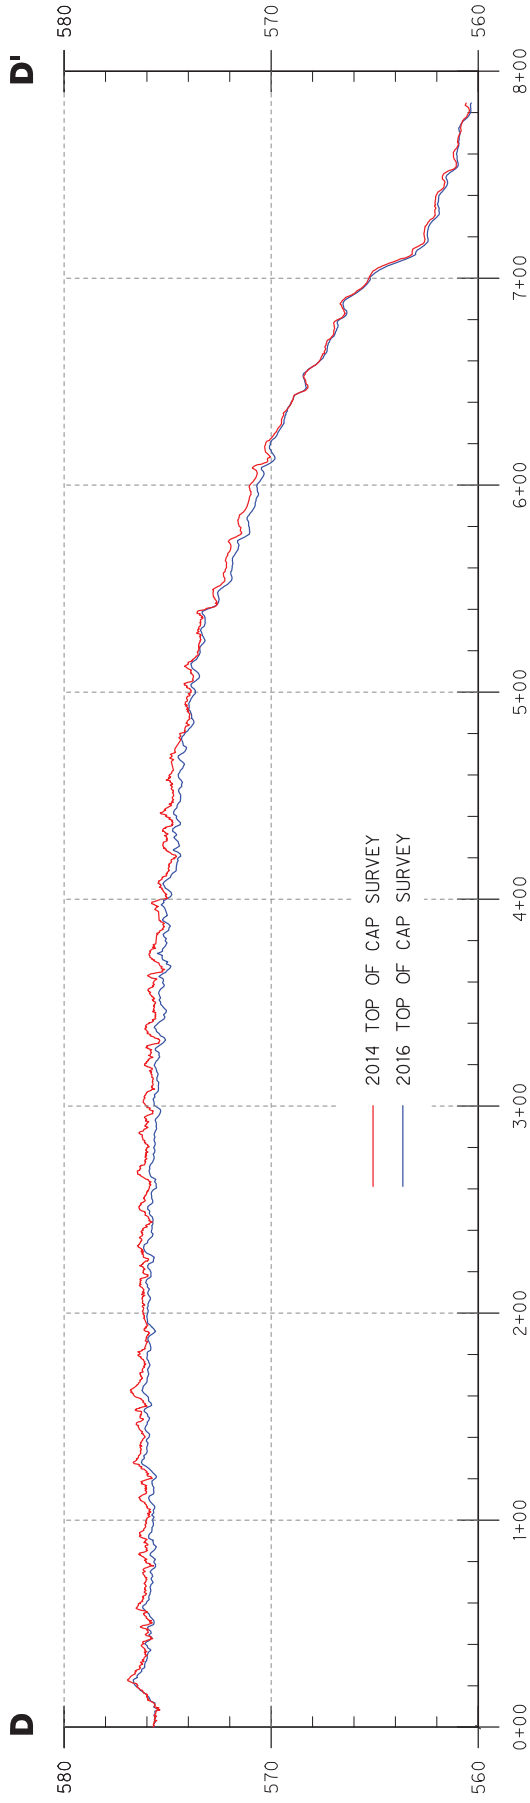

SEE FIGURES 9A, 9B & 9C FOR
CROSS SECTION LOCATION




SCALE: AS SHOWN

LOWER FOX RIVER REMEDIATION LLC.

FIGURE 9D
LOWER FOX RIVER - OU4
TOP OF CAP CROSS SECTION

Date: DECEMBER, 2016	Revision Date:
Drawn By: JRB2	Checked By: TMK1
Scope: 16L029	

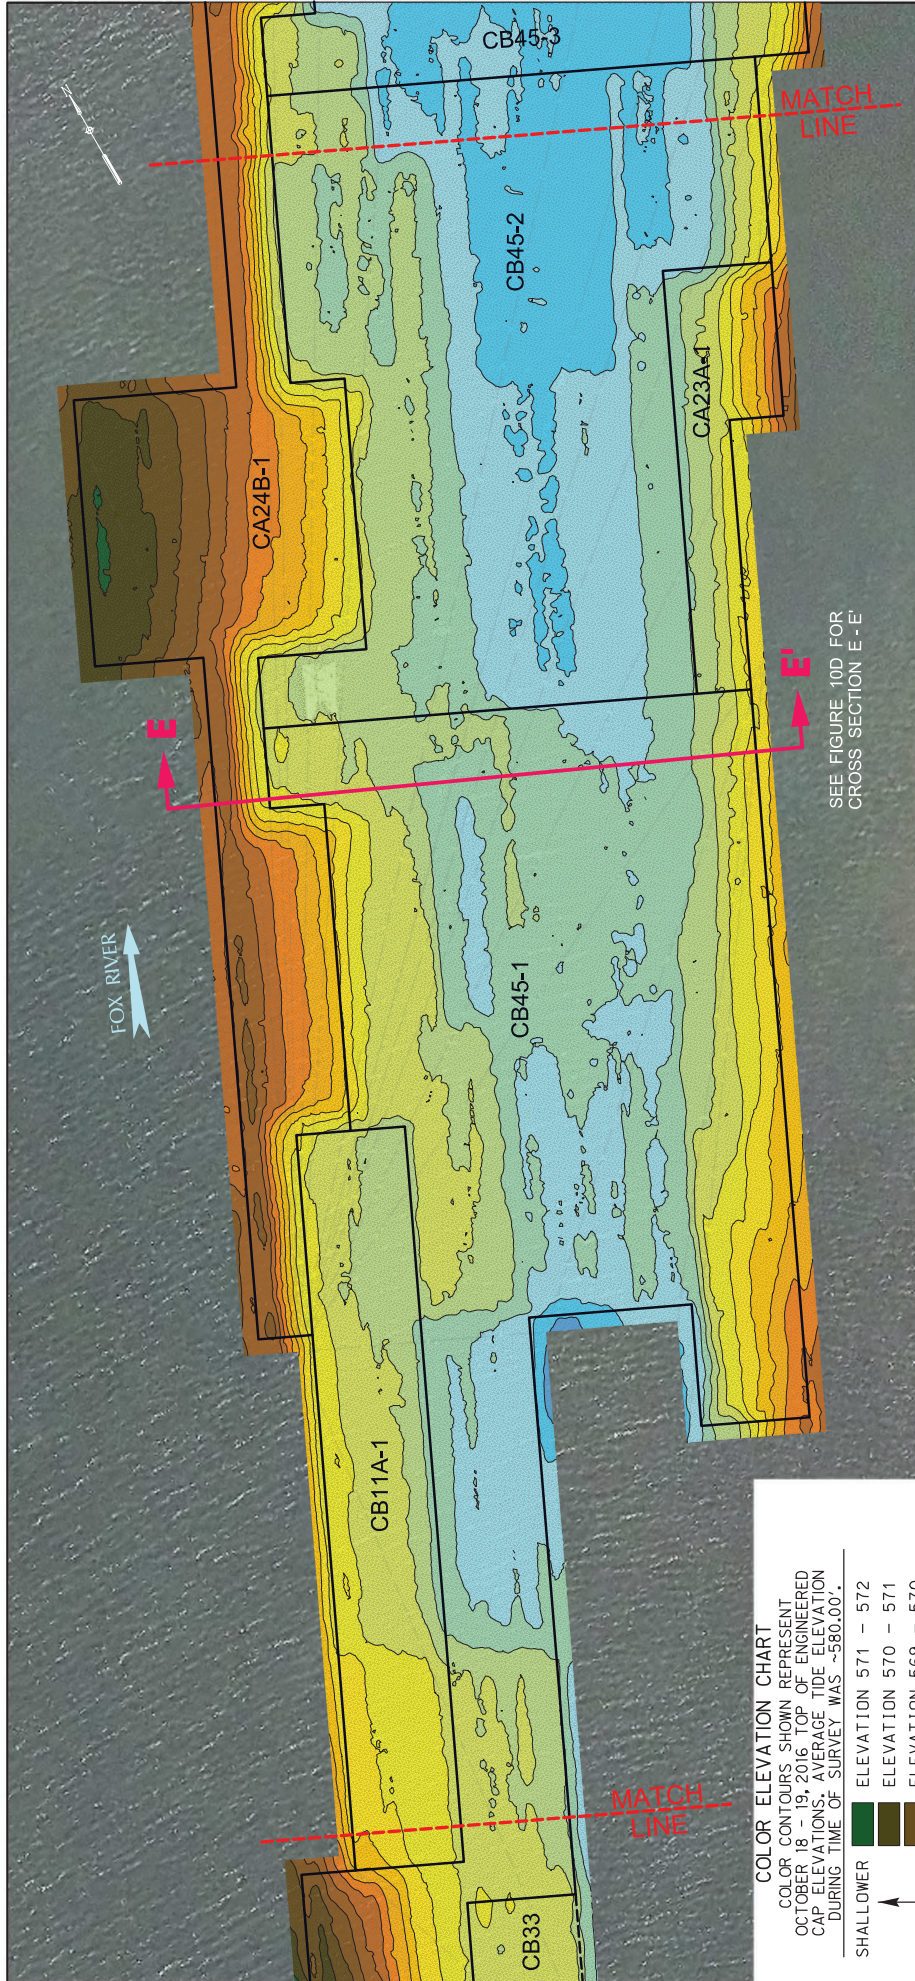

COLOR ELEVATION CHART

COLOR CONTOURS SHOWN REPRESENT OCTOBER 18 - 19, 2016, TOP OF ENGINEERED CAP ELEVATIONS, AVERAGE TIDE ELEVATION DURING TIME OF SURVEY WAS -580.00'.

SHALLOWER	ELEVATION 571 - 572
	ELEVATION 570 - 571
	ELEVATION 569 - 570
	ELEVATION 568 - 569
	ELEVATION 567 - 568
	ELEVATION 566 - 567
	ELEVATION 565 - 566
	ELEVATION 564 - 565
	ELEVATION 563 - 564
	ELEVATION 562 - 563
	ELEVATION 561 - 562
	ELEVATION 560 - 561
	ELEVATION 559 - 560
	ELEVATION 558 - 559
	ELEVATION 557 - 558
DEEPER	ELEVATION 556 - 557


WATER DEPTH

LEGEND

□ CAP DESIGN PLACEMENT LIMITS

NOTES:

1. 400 KILOHERTZ (KHZ) MULTI-BEAM HYDROGRAPHIC SURVEY PERFORMED BY J.F. BRENNAN, CO. DATE OF SURVEY: APRIL 14, APRIL 20 AND MAY 3, 2016.
2. THE HORIZONTAL CONTROL IS REFERENCED TO THE NAD83 WISCONSIN STATE PLANE COORDINATE SYSTEM (WISCONSIN CENTRAL ZONE). THE VERTICAL CONTROL IS REFERENCED TO NAVD 88.
3. ORTHO PHOTO SUPPLIED BY BROWN COUNTY LAND INFORMATION OFFICE. COMPILED IN NOVEMBER 2010.
4. DESIGN CAP PLACEMENT LIMITS DERIVED FROM DESIGN FILES PROVIDED BY TETRA TECH EC, INC.
5. MATCH LINES REPRESENT DUPLICATE LOCATIONS ON CONSECUTIVE FIGURES.

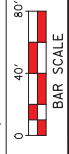

LOWER FOX RIVER REMEDIATION LLC.


FIGURE 10A

LOWER FOX RIVER - QUA
2016 TOP OF CAP ELEVATIONS
PLAN VIEW

Date: DECEMBER, 2016	Revision Date:
Drawn By: JRB2	Checked By: TMK1
Scope: 16L029	


COLOR ELEVATION CHART

COLOR CONTOURS SHOWN REPRESENT OCTOBER 18 - 19, 2016 TOP OF ENGINEERED CAP ELEVATIONS. AVERAGE TIDE ELEVATION DURING TIME OF SURVEY WAS -580.00'.

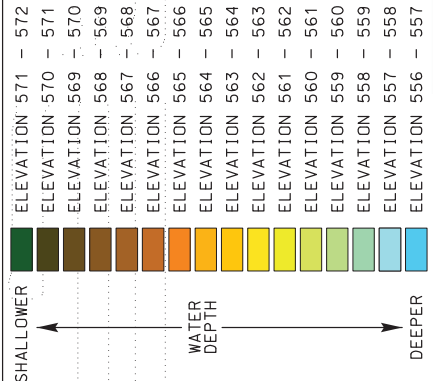

LEGEND

CAP DESIGN PLACEMENT LIMITS

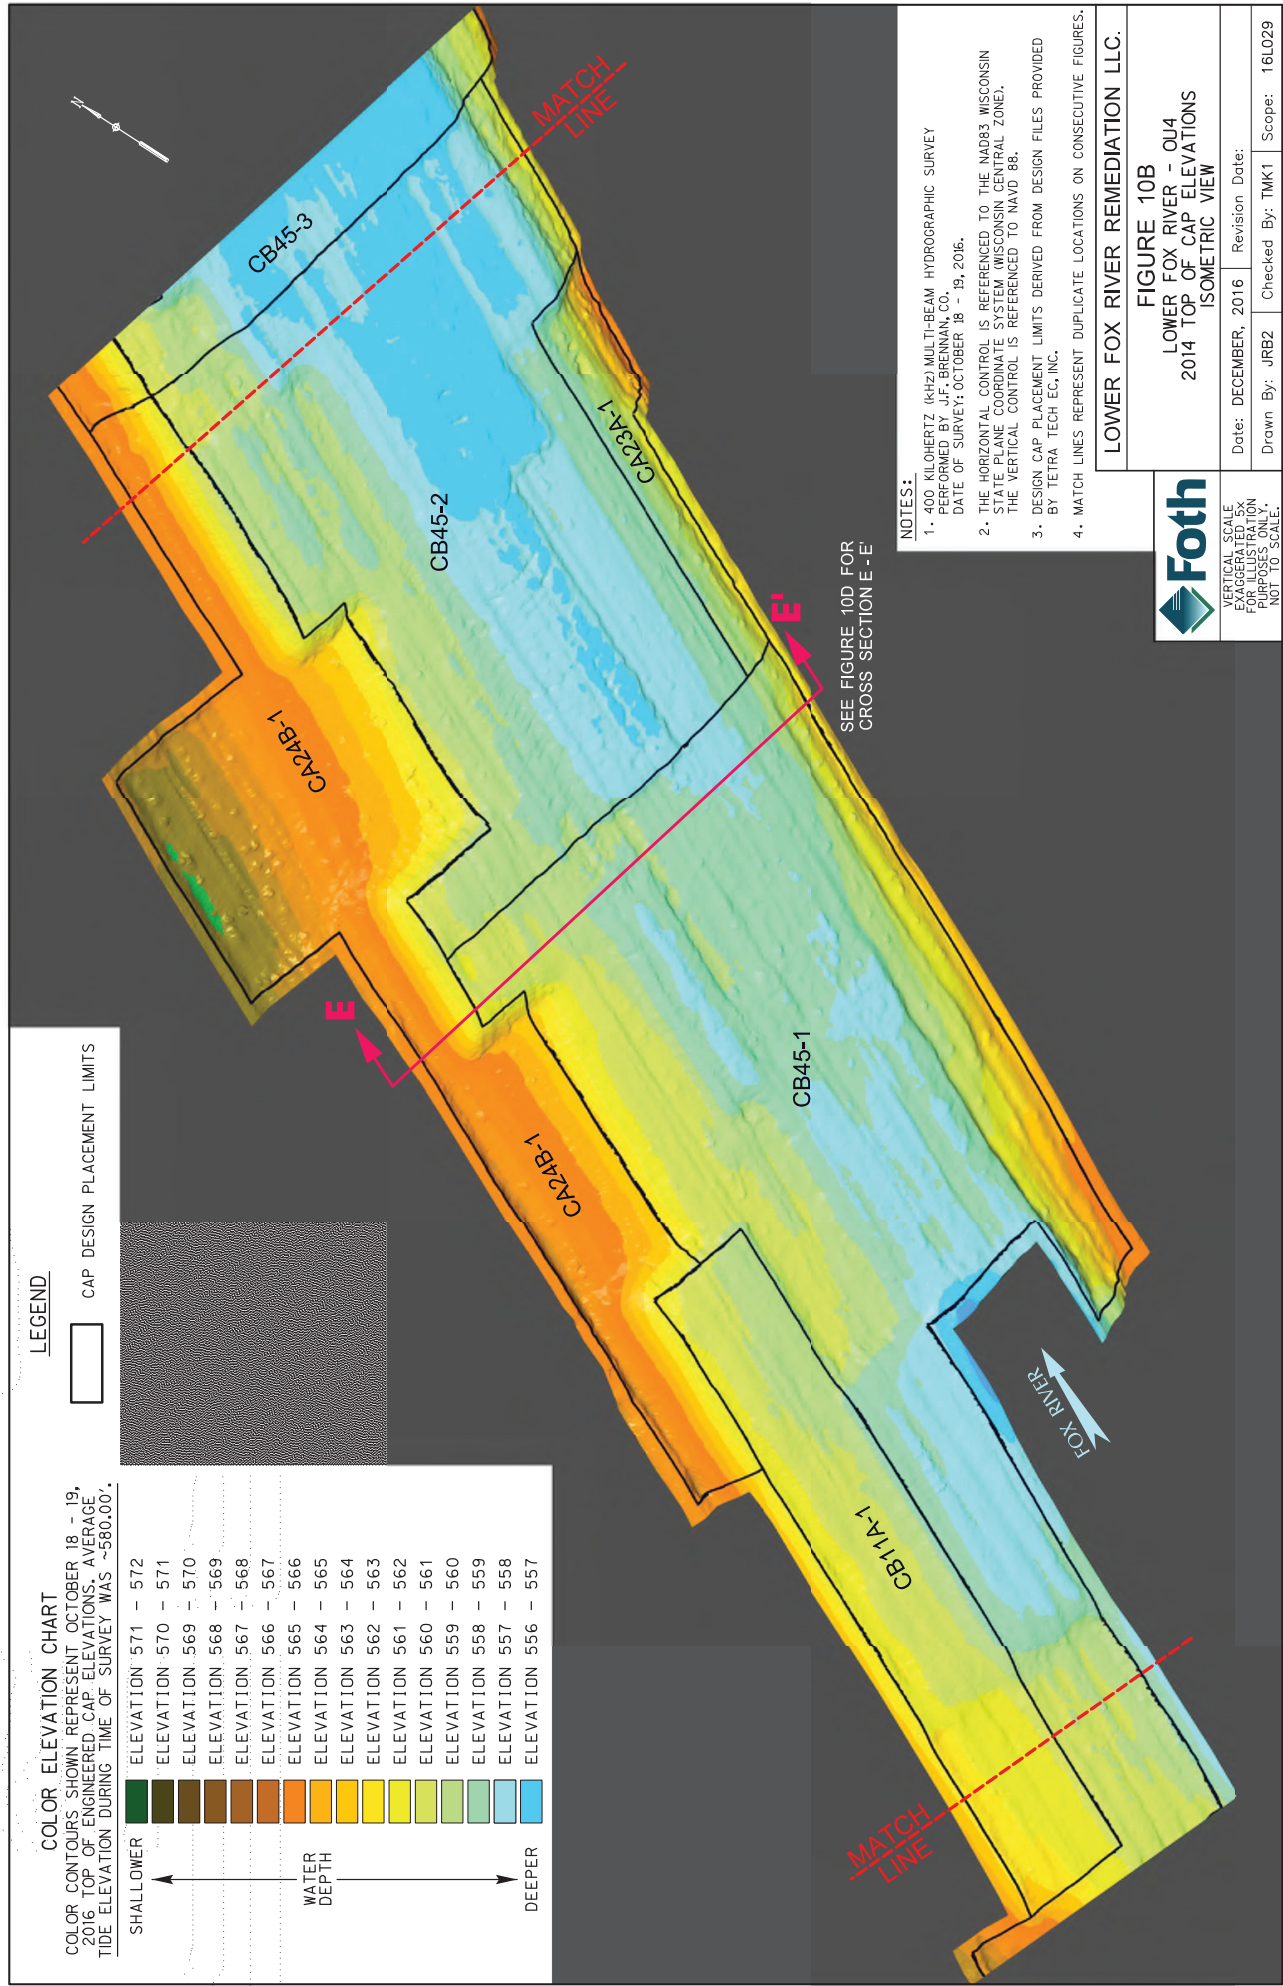

SEE FIGURE 10D FOR CROSS SECTION E-E'

NOTES:

1. 400 KILOHERTZ (KHZ) MULTI-BEAM HYDROGRAPHIC SURVEY PERFORMED BY J.F. BRENNAN, CO. DATE OF SURVEY: OCTOBER 18 - 19, 2016.
2. THE HORIZONTAL CONTROL IS REFERENCED TO THE NAD83 WISCONSIN STATE COORDINATE SYSTEM (WISCONSIN STATE COORDINATE REFERENCE TO NAD83).
3. DESIGN CAP PLACEMENT LIMITS DERIVED FROM DESIGN FILES PROVIDED BY TETRA TECH EC, INC.
4. MATCH LINES REPRESENT DUPLICATE LOCATIONS ON CONSECUTIVE FIGURES.




VERTICAL SCALE FOR ILLUSTRATION PURPOSES ONLY. NOT TO SCALE.

LOWER FOX RIVER REMEDIATION LLC.	
FIGURE 10B	
LOWER FOX RIVER - Q14	
2014 TOP OF CAP ELEVATIONS	
ISOMETRIC VIEW	
Date: DECEMBER, 2016	Revision Date:
Drawn By: JRB2	Checked By: TMK1
Scope: 16L029	



SEE FIGURE 10D FOR
CROSS SECTION E-E'


COLOR ELEVATION CHART
COLOR ISOPACH CONTOURS SHOWN REPRESENT
DEPTH CHANGE FROM NOVEMBER 13-14, 2014
TO OCTOBER 18 - 19, 2016 SURVEYS

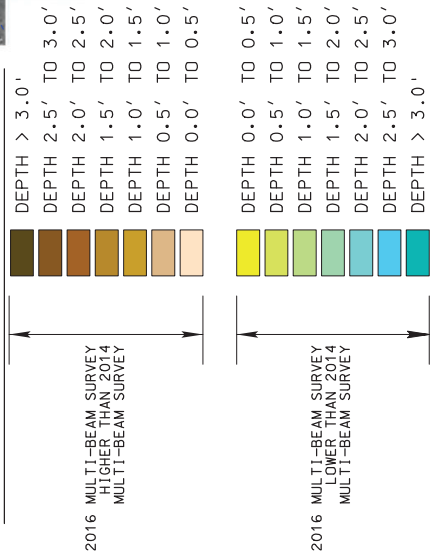

LEGEND

- CAP DESIGN PLACEMENT LIMITS
- 170' GRID LINES USED FOR POLING LOCATIONS
- ACTUAL CAP POLING/PROBING LOCATION AND IDENTIFICATION WITH MEASURED SEDIMENT THICKNESS

- NOTES:**
1. 400 KILOHERTZ (KHZ) MULTI-BEAM HYDROGRAPHIC SURVEY PERFORMED BY J.F. BRENNAN, CO. DATE OF SURVEY: APRIL 11, APRIL 20 AND MAY 3, 2016.
 2. THE HORIZONTAL CONTROL IS REFERENCED TO THE NAD83 WISCONSIN STATE PLANE COORDINATE SYSTEM (WISCONSIN CENTRAL ZONE). THE VERTICAL CONTROL IS REFERENCED TO NAVD 88.
 3. ORTHO PHOTO SUPPLIED BY BROWN COUNTY LAND INFORMATION OFFICE, COMPILED IN NOVEMBER 2010.
 4. DESIGN CAP PLACEMENT LIMITS DERIVED FROM DESIGN FILES PROVIDED BY TETRA TECH EC, INC.
 5. MATCH LINES REPRESENT DUPLICATE LOCATIONS ON CONSECUTIVE FIGURES.
 6. CAP POLING/PROBING PERFORMED BY FOTH ON NOVEMBER 3 - 4, 2016.


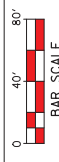


LOWER FOX RIVER REMEDIATION LLC.

FIGURE 10C

LOWER FOX RIVER - OUI4
ISOPACH MAP BETWEEN THE 2014
& 2016 POST-CAPPING SURVEYS


Date: DECEMBER, 2016	Revision Date:
Drawn By: JRB2	Checked By: TMK1
Scope: 16L029	

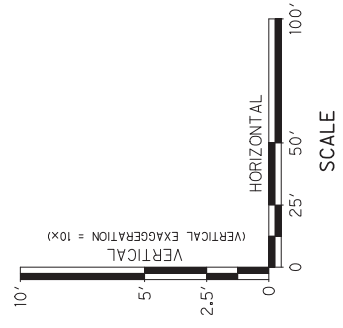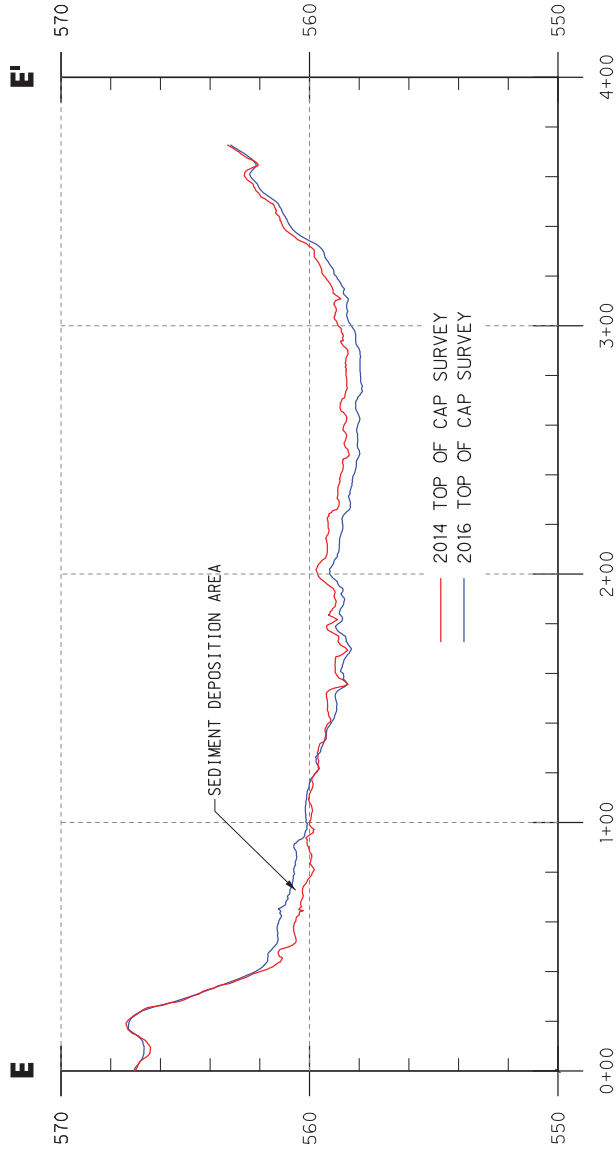

SEE FIGURES 10A, 10B & 10C FOR CROSS SECTION LOCATION E - E'

LOWER FOX RIVER REMEDIATION LLC.	
FIGURE 10D	
LOWER FOX RIVER - OU4 TOP OF CAP CROSS SECTION	
Date: DECEMBER, 2016	Revision Date:
Drawn By: JRB2	Checked By: TMK1
Scale: AS SHOWN	Scope: 16L029



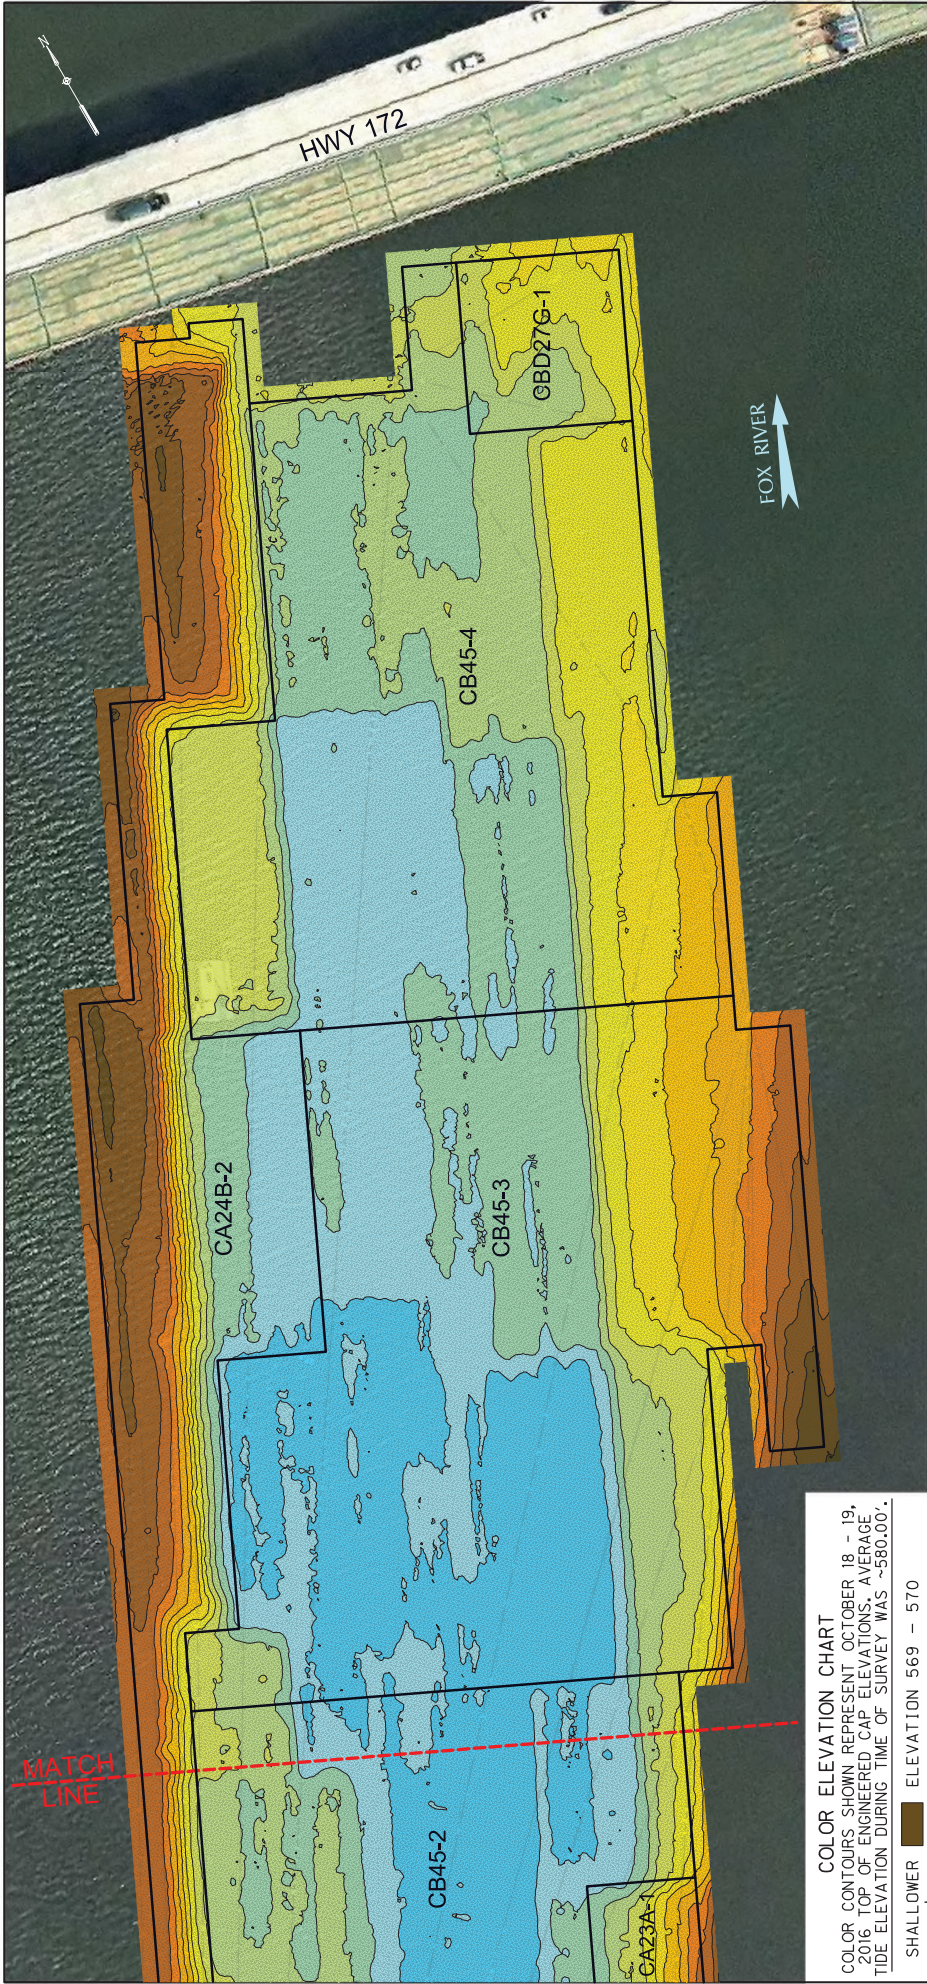

COLOR ELEVATION CHART
 COLOR CONTOURS SHOWN REPRESENT OCTOBER 18 - 19, 2016, TOP OF ENGINEERED CAP ELEVATIONS, AVERAGE, TIDE ELEVATION DURING TIME OF SURVEY WAS ~580.00'.

SHALLOWER	ELEVATION 569 - 570
	ELEVATION 568 - 569
	ELEVATION 567 - 568
	ELEVATION 566 - 567
	ELEVATION 565 - 566
	ELEVATION 564 - 565
	ELEVATION 563 - 564
	ELEVATION 562 - 563
	ELEVATION 561 - 562
	ELEVATION 560 - 561
	ELEVATION 559 - 560
	ELEVATION 558 - 559
	ELEVATION 557 - 558
DEEPER	ELEVATION 556 - 557

LEGEND

□ CAP DESIGN PLACEMENT LIMITS

- NOTES:**
- 400 KILOHERTZ (KHZ) MULTI-BEAM HYDROGRAPHIC SURVEY PERFORMED BY J.F. BRENNAN, CO. DATE OF SURVEY: APRIL 11, APRIL 20 AND MAY 3, 2016.
 - THE HORIZONTAL CONTROL IS REFERENCED TO THE NAD83 WISCONSIN STATE PLANE COORDINATE SYSTEM (WISCONSIN CENTRAL ZONE), THE VERTICAL CONTROL IS REFERENCED TO NAVD 88.
 - ORTHO PHOTO SUPPLIED BY BROWN COUNTY LAND INFORMATION OFFICE. COMPILED IN NOVEMBER 2010.
 - DESIGN CAP PLACEMENT LIMITS DERIVED FROM DESIGN FILES PROVIDED BY TEIRA TECH EC, INC.
 - MATCH LINES REPRESENT DUPLICATE LOCATIONS ON CONSECUTIVE FIGURES.


Foth
 0 40' 80'
 BAR SCALE

LOWER FOX RIVER REMEDIATION LLC.
FIGURE 11A
 LOWER FOX RIVER - OUI4
 2016 TOP OF CAP ELEVATIONS
 PLAN VIEW

Date: DECEMBER, 2016	Revision Date:
Drawn By: JRB2	Checked By: TMK1
Scope: 16L029	

COLOR ELEVATION CHART


COLOR CONTOURS SHOWN REPRESENT OCTOBER 18 - 19, 2016 TOP OF ENGINEERED CAP ELEVATIONS, AVERAGE TIDE ELEVATION DURING TIME OF SURVEY WAS ~580.00'.

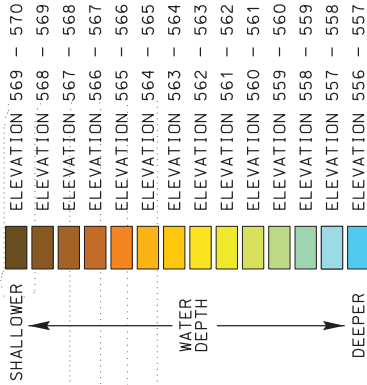


LEGEND



CAP DESIGN PLACEMENT LIMITS

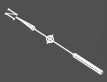

FOX RIVER

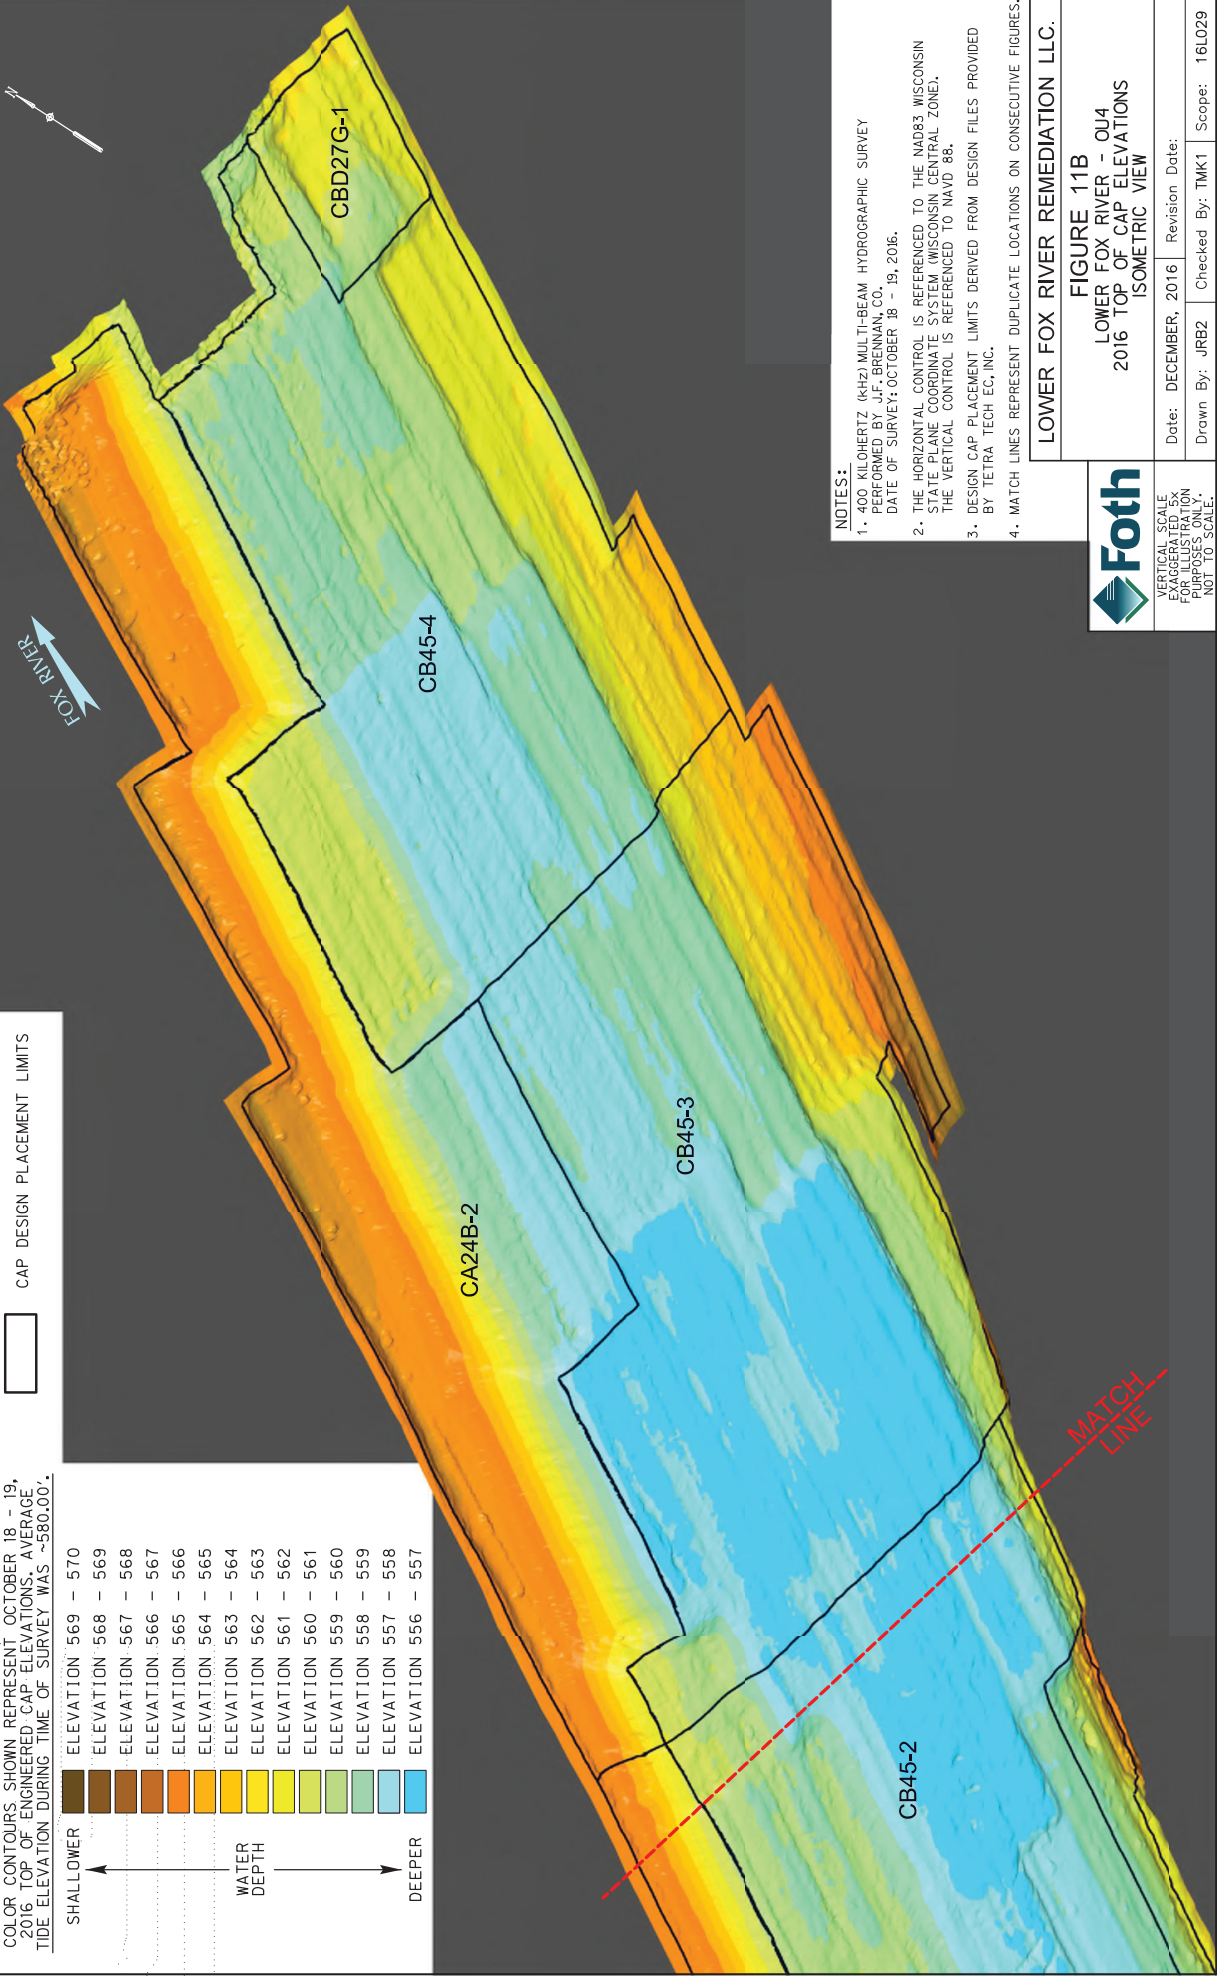

NOTES:

1. 400 KILOHERTZ (KHZ) MULTI-BEAM HYDROGRAPHIC SURVEY PERFORMED BY J.F. BRENNAN, CO. DATE OF SURVEY: OCTOBER 18 - 19, 2016.
2. THE HORIZONTAL CONTROL IS REFERENCED TO THE NAD83 WISCONSIN STATE PLANE COORDINATE SYSTEM (WISCONSIN CENTRAL ZONE). THE VERTICAL CONTROL IS REFERENCED TO NAVD 88.
3. DESIGN CAP PLACEMENT LIMITS DERIVED FROM DESIGN FILES PROVIDED BY TETRA TECH EC, INC.
4. MATCH LINES REPRESENT DUPLICATE LOCATIONS ON CONSECUTIVE FIGURES.




VERTICAL SCALE FOR ILLUSTRATION PURPOSES ONLY. NOT TO SCALE.

LOWER FOX RIVER REMEDIATION LLC.	
FIGURE 11B	
LOWER FOX RIVER - QU4	
2016 TOP OF CAP ELEVATIONS	
ISOMETRIC VIEW	
Date: DECEMBER, 2016	Revision Date:
Drawn By: JRB2	Checked By: TMT1
Scope: 16L029	



COLOR ELEVATION CHART

COLOR ISOPACH CONTOURS SHOWN REPRESENT DEPTH CHANGE FROM NOVEMBER 13-14, 2014 TO OCTOBER 18 - 19, 2016 SURVEYS

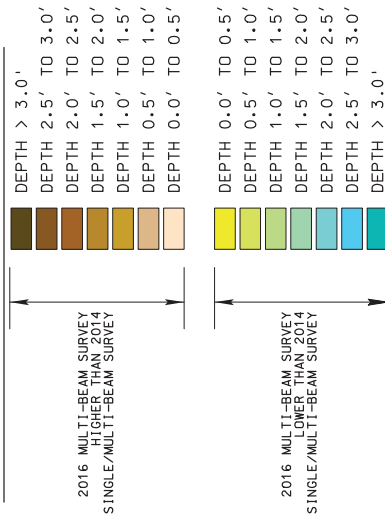

LEGEND

- CAP DESIGN PLACEMENT LIMITS
- 170' GRID LINES USED FOR POLING LOCATIONS
- ACTUAL CAP POLING/PROBING LOCATION AND IDENTIFICATION WITH MEASURED SEDIMENT THICKNESS


NOTES:
 1. 400 KILOHERTZ (KHZ) MULTI-BEAM HYDROGRAPHIC SURVEY PERFORMED BY J.F. BRENNAN, CO. DATE OF SURVEY: APRIL 11, APRIL 20 AND MAY 3, 2016.
 2. THE HORIZONTAL CONTROL IS REFERENCED TO THE NAD83 WISCONSIN STATE PLANE COORDINATE SYSTEM (WISCONSIN CENTRAL ZONE). THE VERTICAL CONTROL IS REFERENCED TO NAVD 88.
 3. ORTHO PHOTO SUPPLIED BY BROWN COUNTY LAND INFORMATION OFFICE. COMPILED IN NOVEMBER 2010.
 4. DESIGN CAP PLACEMENT LIMITS DERIVED FROM DESIGN FILES PROVIDED BY TETRA TECH EC, INC.
 5. MATCH LINES REPRESENT DUPLICATE LOCATIONS ON CONSECUTIVE FIGURES.


LOWER FOX RIVER REMEDIATION LLC.

FIGURE 11C

LOWER FOX RIVER - OUA
 ISOPACH MAP BETWEEN THE 2014
 & 2016 POST-CAPPING SURVEYS

Date: DECEMBER, 2016 Revision Date:
 Drawn By: JRB2 Checked By: TMT1 Scope: 16L029

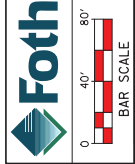

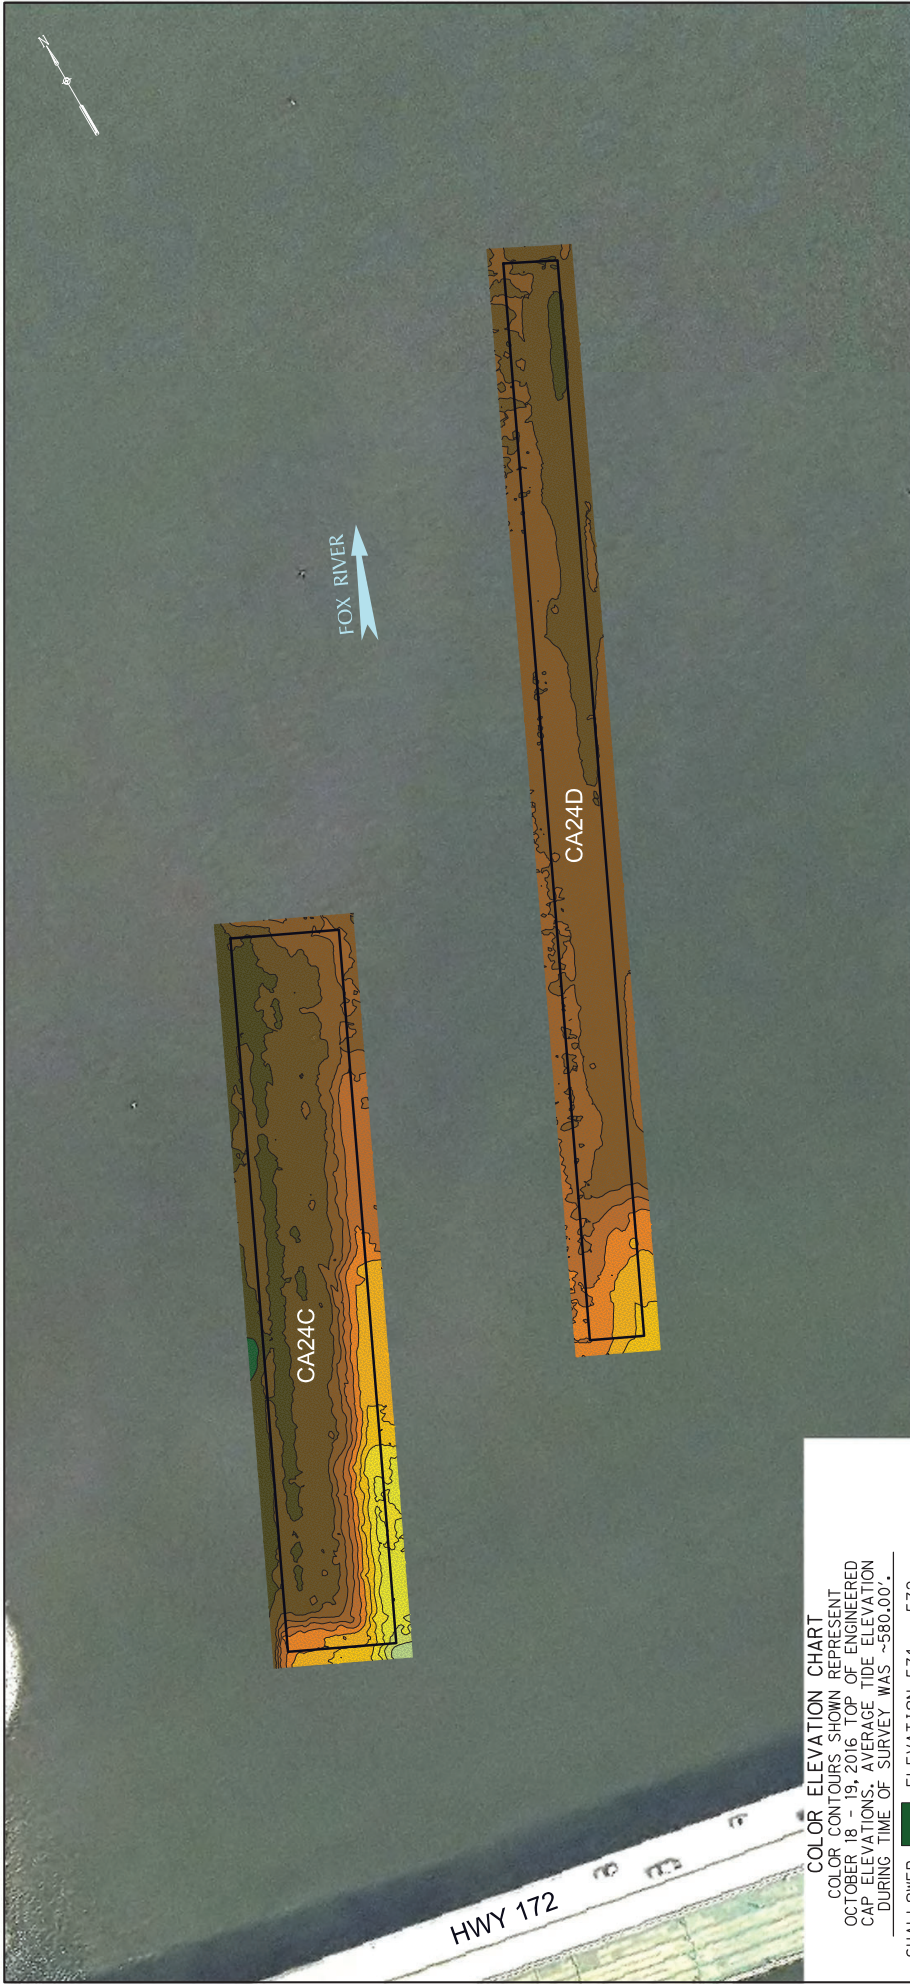


COLOR ELEVATION CHART
 COLOR CONTOURS SHOWN REPRESENT
 OCTOBER 18, 19, 2016 TOP OF ENGINEERED
 CAP ELEVATIONS. AVERAGE TIDE ELEVATION
 DURING TIME OF SURVEY WAS -580.00'.

SHALLOWER	ELEVATION 571 - 572
	ELEVATION 570 - 571
	ELEVATION 569 - 570
	ELEVATION 568 - 569
	ELEVATION 567 - 568
	ELEVATION 566 - 567
	ELEVATION 565 - 566
	ELEVATION 564 - 565
	ELEVATION 563 - 564
	ELEVATION 562 - 563
	ELEVATION 561 - 562
	ELEVATION 560 - 561
	ELEVATION 559 - 560
DEEPER	ELEVATION 558 - 559

LEGEND
 CAP DESIGN PLACEMENT LIMITS


- NOTES:**
1. 400 KILCHERTZ (KHz) MULTI-BEAM HYDROGRAPHIC SURVEY PERFORMED BY J.F. BRENNAN, CO. DATE OF SURVEY: APRIL 11, APRIL 20 AND MAY 3, 2016.
 2. THE HORIZONTAL CONTROL IS REFERENCED TO THE NAD83 WISCONSIN STATE PLANE COORDINATE SYSTEM (WISCONSIN CENTRAL ZONE). THE VERTICAL CONTROL IS REFERENCED TO NAVD 88.
 3. ORTHO PHOTO SUPPLIED BY BROWN COUNTY LAND INFORMATION OFFICE. COMPILED IN NOVEMBER 2010.
 4. DESIGN CAP PLACEMENT LIMITS DERIVED FROM DESIGN FILES PROVIDED BY TETRA TECH EC, INC.
 5. MATCH LINES REPRESENT DUPLICATE LOCATIONS ON CONSECUTIVE FIGURES.




0 40' 80'
 BAR SCALE

LOWER FOX RIVER REMEDIATION LLC.
FIGURE 12A
 LOWER FOX RIVER - OUI4
 2016 TOP OF CAP ELEVATIONS
 PLAN VIEW

Date: **NOVEMBER, 2016** Revision Date:
 Drawn By: **JRB2** Checked By: **TMK1** Scope: **16L029**

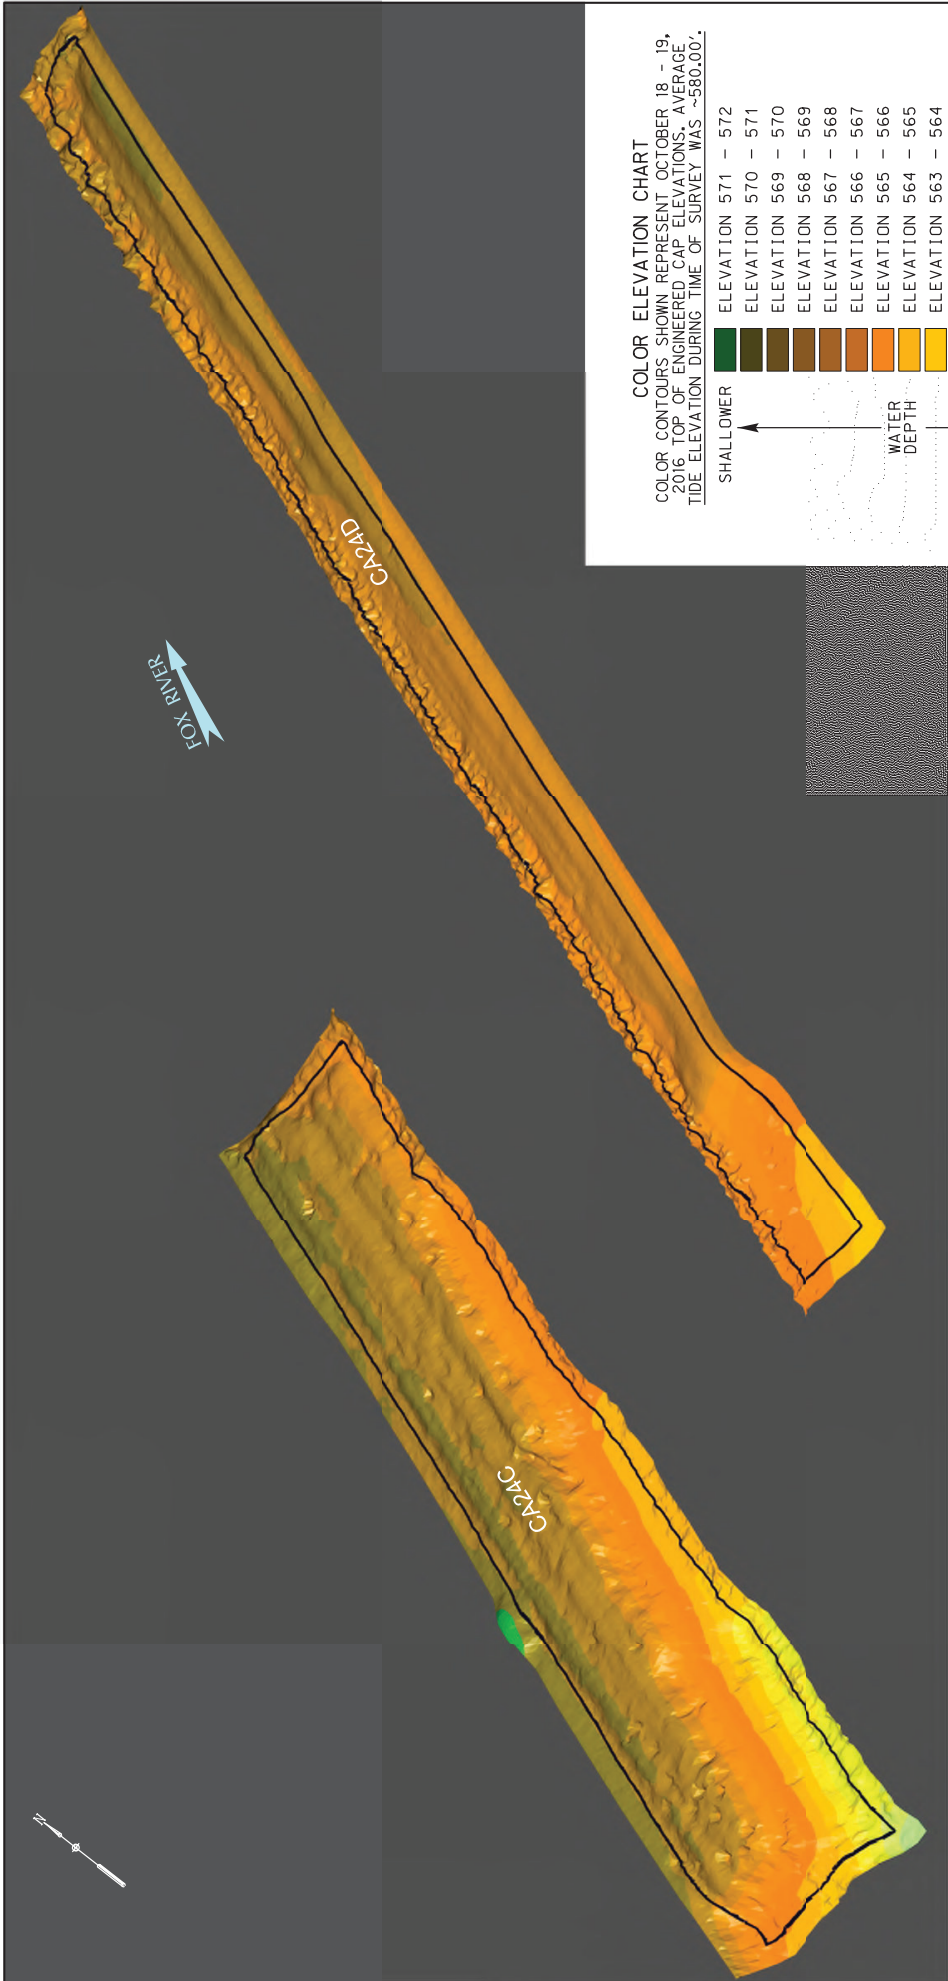

COLOR ELEVATION CHART
 COLOR CONTOURS SHOWN REPRESENT OCTOBER 18 - 19, 2016 TOP OF ENGINEERED CAP ELEVATIONS, AVERAGE, TIDE ELEVATION DURING TIME OF SURVEY WAS ~580.00'.

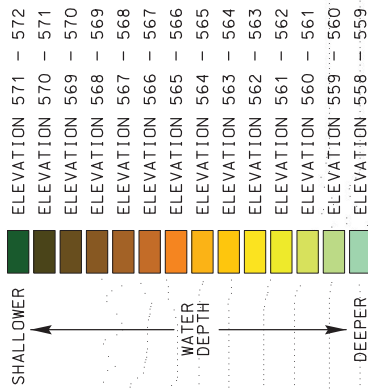

LEGEND

□ CAP DESIGN PLACEMENT LIMITS

- NOTES:**
1. 400 KILBERTZ (442) MULTI-BEAM HYDROGRAPHIC SURVEY PERFORMED BY J.F. BERGMAN CO., 19, 2016. DATE OF SURVEY: OCTOBER 18 - 19, 2016.
 2. THE HORIZONTAL CONTROL IS REFERENCED TO THE NAD83 WISCONSIN STATE PLANE COORDINATE SYSTEM (WISCONSIN CENTRAL ZONE). THE VERTICAL CONTROL IS REFERENCED TO NAVD 88.
 3. DESIGN CAP PLACEMENT LIMITS DERIVED FROM DESIGN FILES PROVIDED BY TETRA TECH EC, INC.

LOWER FOX RIVER REMEDIATION LLC.

FIGURE 12B
 LOWER FOX RIVER - Q14
 2016 TOP OF CAP ELEVATIONS
 ISOMETRIC VIEW



VERTICAL SCALE
 FOR ILLUSTRATION
 PURPOSES ONLY.
 NOT TO SCALE.

Date: DECEMBER, 2016	Revision Date:
Drawn By: JRB2	Checked By: TMK1
Scope: 16L029	



LEGEND


- CAP DESIGN PLACEMENT LIMITS
- 170' GRID LINES USED FOR POLING LOCATIONS
- ACTUAL CAP POLING/PROBING LOCATION AND IDENTIFICATION WITH MEASURED SEDIMENT THICKNESS

LOWER FOX RIVER REMEDIATION LLC.


FIGURE 12C

LOWER FOX RIVER - OUI4
ISOPACH MAP BETWEEN THE 2014
& 2016 POST-CAPPING SURVEYS


Date: DECEMBER, 2016 | Revision Date:
Drawn By: JRB2 | Checked By: TMT1 | Scope: 16L029

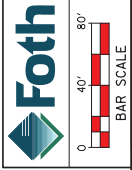

COLOR ELEVATION CHART
COLOR ISOPACH CONTOURS SHOWN REPRESENT DEPTH CHANGE FROM NOVEMBER 13-14, 2014 TO OCTOBER 18 - 19, 2016 SURVEYS

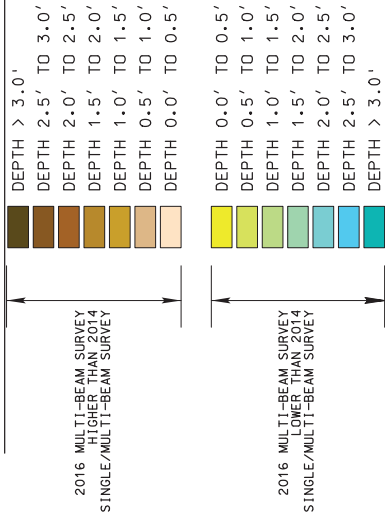

- NOTES:**
1. 400 KILOHERTZ (KHZ) MULTI-BEAM HYDROGRAPHIC SURVEY PERFORMED BY J.F. BRENNAN, CO. DATE OF SURVEY: OCTOBER 18 - 19, 2016.
 2. THE HORIZONTAL CONTROL IS REFERENCED TO THE NAD83 WISCONSIN STATE PLANE COORDINATE SYSTEM (WISCONSIN CENTRAL ZONE). THE VERTICAL CONTROL IS REFERENCED TO NAVD 88.
 3. ORTHO PHOTO SUPPLIED BY BROWN COUNTY LAND INFORMATION OFFICE. COMPILED IN NOVEMBER 2010.
 4. DESIGN CAP PLACEMENT LIMITS DERIVED FROM DESIGN FILES PROVIDED BY TETRA TECH EC, INC.
 5. MATCH LINES REPRESENT DUPLICATE LOCATIONS ON CONSECUTIVE FIGURES.
 6. CAP POLING/PROBING PERFORMED BY FOTH ON NOVEMBER 3 - 4, 2016.

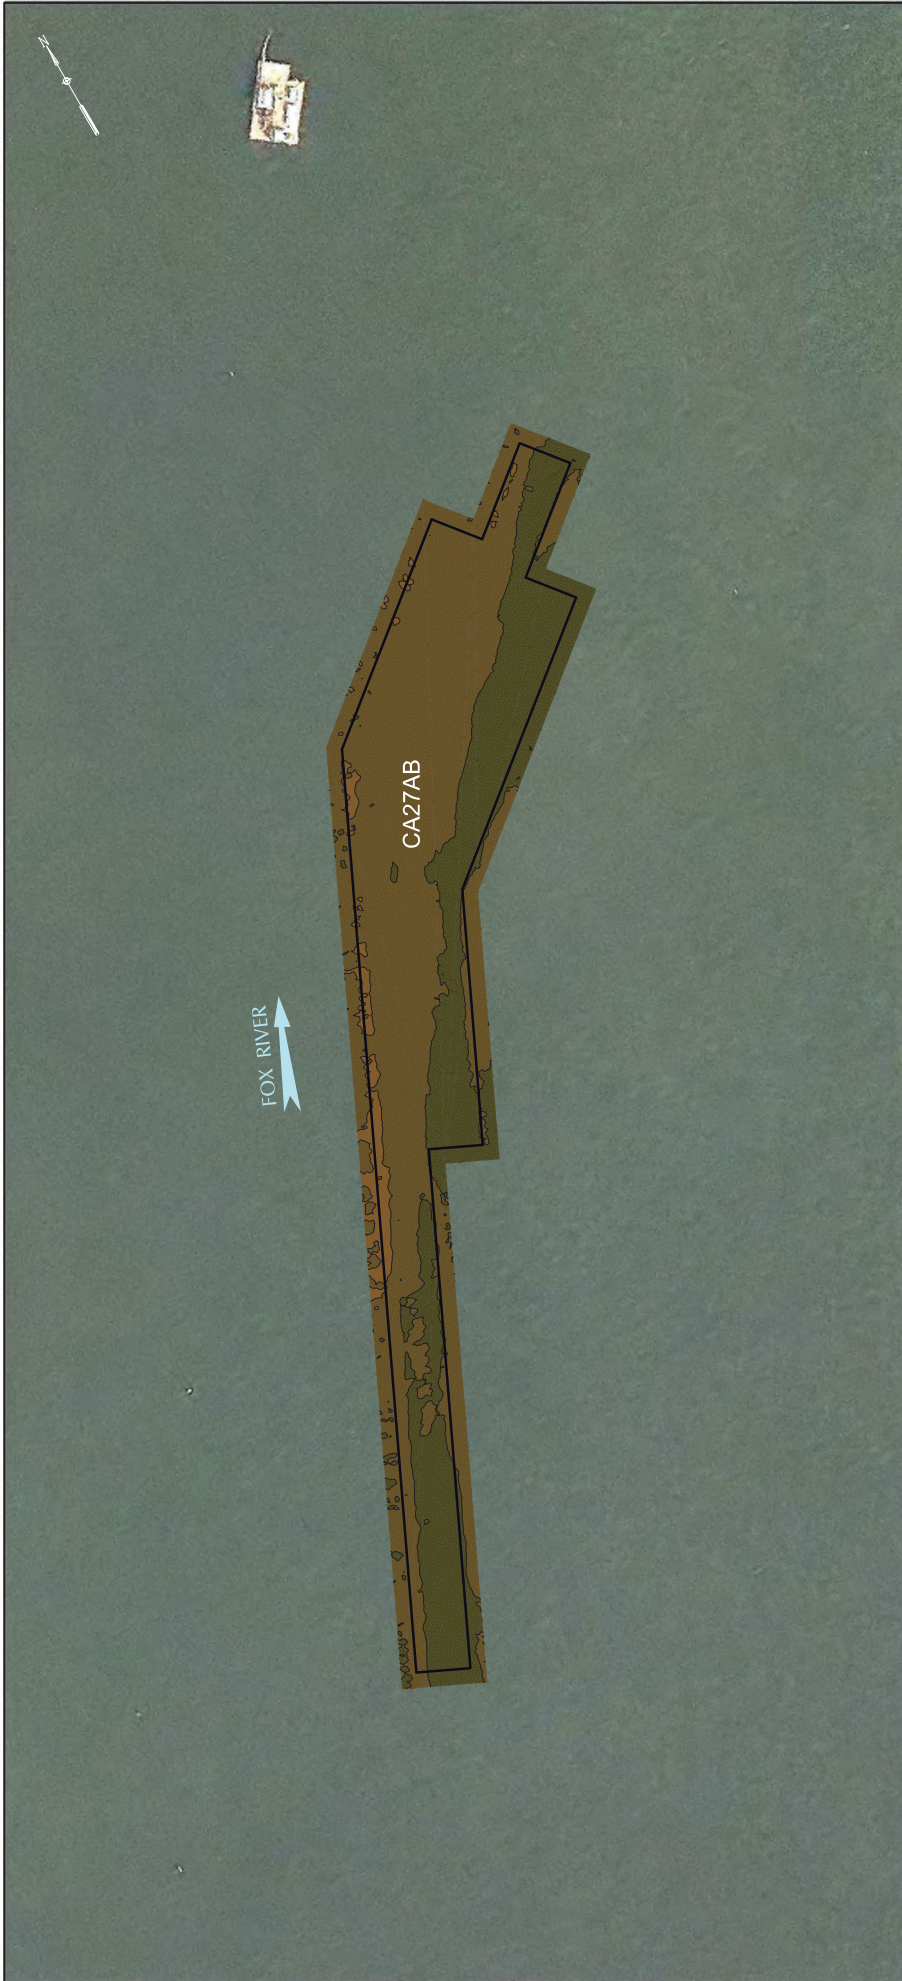

FOX RIVER

CA27AB


COLOR ELEVATION CHART
 COLOR CONTOURS SHOWN REPRESENT OCTOBER 18 - 19, 2016 TOP OF ENGINEERED CAP ELEVATIONS. AVERAGE TIDE ELEVATION DURING TIME OF SURVEY WAS -580.00'.

SHALLOWER	ELEVATION 571 - 572
↑	ELEVATION 570 - 571
WATER DEPTH	ELEVATION 569 - 570
↓	ELEVATION 568 - 569
DEEPER	ELEVATION 567 - 568
	ELEVATION 566 - 567

LEGEND

□ CAP DESIGN PLACEMENT LIMITS

- NOTES:**
1. 400 KILOHERTZ (KHz) MULTI-BEAM HYDROGRAPHIC SURVEY PERFORMED BY J.F. BRENNAN, CO. DATE OF SURVEY: APRIL 14, APRIL 20 AND MAY 3, 2016.
 2. THE HORIZONTAL CONTROL IS REFERENCED TO THE NAD83 WISCONSIN STATE PLANE COORDINATE SYSTEM (WISCONSIN CENTRAL ZONE). THE VERTICAL CONTROL IS REFERENCED TO NAVD 88.
 3. ORTHO PHOTO SUPPLIED BY BROWN COUNTY LAND INFORMATION OFFICE. COMPILED IN NOVEMBER 2010.
 4. DESIGN CAP PLACEMENT LIMITS DERIVED FROM DESIGN FILES PROVIDED BY TETRA TECH EC, INC.
 5. MATCH LINES REPRESENT DUPLICATE LOCATIONS ON CONSECUTIVE FIGURES.

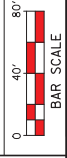

LOWER FOX RIVER REMEDIATION LLC.	
FIGURE 13A	
LOWER FOX RIVER - OU4	
2016 TOP OF CAP ELEVATIONS	
PLAN VIEW	
Date: DECEMBER, 2016	Revision Date:
Drawn By: JRB2	Checked By: TMK1
Scope: 16L029	



COLOR ELEVATION CHART
 COLOR CONTOURS SHOWN REPRESENT OCTOBER 18 - 19, 2016 TOP OF ENGINEERED CAP ELEVATIONS, AVERAGE TIDE ELEVATION DURING TIME OF SURVEY WAS ~580.00'.

SHALLOWER	ELEVATION 571 - 572
	ELEVATION 570 - 571
WATER DEPTH	ELEVATION 569 - 570
	ELEVATION 568 - 569
DEEPER	ELEVATION 567 - 568
	ELEVATION 566 - 567

LEGEND

□ CAP DESIGN PLACEMENT LIMITS

NOTES:

1. 400 KILGERTZ (442) MULTI-BEAM HYDROGRAPHIC SURVEY PERFORMED BY J.F. BERGMAN, CO., 19, 2016. DATE OF SURVEY: OCTOBER 18 - 19, 2016.
2. THE HORIZONTAL CONTROL IS REFERENCED TO THE NAD83 WISCONSIN STATE PLANE COORDINATE SYSTEM (WISCONSIN CENTRAL ZONE). THE VERTICAL CONTROL IS REFERENCED TO NAVD 88.
3. DESIGN CAP PLACEMENT LIMITS DERIVED FROM DESIGN FILES PROVIDED BY TETRA TECH EC, INC.



VERTICAL SCALE
 FOR ILLUSTRATION
 PURPOSES ONLY.
 NOT TO SCALE.

LOWER FOX RIVER REMEDIATION LLC.

FIGURE 13B


LOWER FOX RIVER - QUA
 2016 TOP OF CAP ELEVATIONS
 ISOMETRIC VIEW

Date: DECEMBER, 2016	Revision Date:
Drawn By: JRB2	Checked By: TMK3
Scope: 16L029	



COLOR ELEVATION CHART

COLOR ISOPACH CONTOURS SHOWN REPRESENT DEPTH CHANGE FROM NOVEMBER 13-14, 2014 TO OCTOBER 18 - 19, 2016 SURVEYS

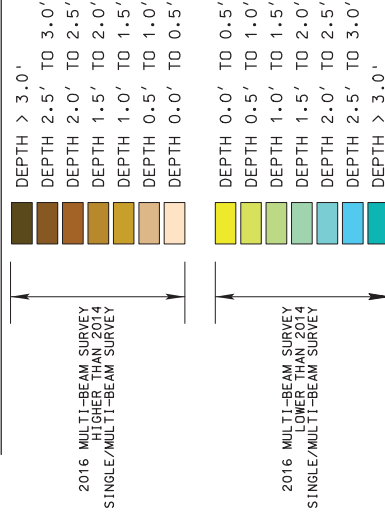

LEGEND

- CAP DESIGN PLACEMENT LIMITS
- 170' GRID LINES USED FOR POLING LOCATIONS
- ACTUAL CAP POLING/PROBING LOCATION AND IDENTIFICATION WITH MEASURED SEDIMENT THICKNESS

NOTES:

1. 400 KILOHERTZ (KHZ) MULTI-BEAM HYDROGRAPHIC SURVEY PERFORMED BY J.F. BRENNAN, CO. DATE OF SURVEY: OCTOBER 18 - 19, 2016.
2. THE HORIZONTAL CONTROL IS REFERENCED TO THE NAD83 WISCONSIN STATE PLANE COORDINATE SYSTEM (WISCONSIN GENERAL ZONE). THE VERTICAL CONTROL IS REFERENCED TO NAVD 88.
3. ORTHO PHOTO SUPPLIED BY BROWN COUNTY LAND INFORMATION OFFICE. COMPILED IN NOVEMBER 2010.
4. DESIGN CAP PLACEMENT LIMITS DERIVED FROM DESIGN FILES PROVIDED BY TETRA TECH EC, INC.
5. CAP POLING/PROBING PERFORMED BY FOTH ON NOVEMBER 3 - 4, 2016.

LOWER FOX RIVER REMEDIATION LLC.	
FIGURE 13C	
LOWER FOX RIVER - OUA	
ISOPACH MAP BETWEEN THE 2014	
& 2016 POST-CAPPING SURVEYS	
Date: DECEMBER, 2016	Revision Date:
Drawn By: JRB2	Checked By: TMK1
Scope: 16L029	



COLOR ELEVATION CHART

COLOR CONTOURS SHOWN REPRESENT DECEMBER 1, 2016 TOP OF ENGINEERED CAP ELEVATIONS. AVERAGE TIDE ELEVATION DURING TIME OF SURVEY WAS ~580.00'.


SHALLOWER	ELEVATION 571 - 572
↑	ELEVATION 570 - 571
WATER DEPTH	ELEVATION 569 - 570
↓	ELEVATION 568 - 569
DEEPER	ELEVATION 567 - 568
	ELEVATION 566 - 567

NOTES:


1. 400 KILOHERTZ (KHz) MULTI-BEAM HYDROGRAPHIC SURVEY PERFORMED BY J.F. BRENNAN, CO. DATE OF SURVEY: APRIL 11, APRIL 20 AND MAY 3, 2016.
2. THE HORIZONTAL CONTROL IS REFERENCED TO THE NAD83 WISCONSIN STATE PLANE COORDINATE SYSTEM (WISCONSIN CENTRAL ZONE). THE VERTICAL CONTROL IS REFERENCED TO NAVD 88.
3. ORTHO PHOTO SUPPLIED BY BROWN COUNTY LAND INFORMATION OFFICE. COMPILED IN NOVEMBER 2010.
4. DESIGN CAP PLACEMENT LIMITS DERIVED FROM DESIGN FILES PROVIDED BY TETRA TECH EC, INC.
5. MATCH LINES REPRESENT DUPLICATE LOCATIONS ON CONSECUTIVE FIGURES.

LEGEND

 CAP DESIGN PLACEMENT LIMITS

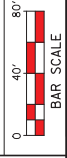

LOWER FOX RIVER REMEDIATION LLC.	
FIGURE 14A	
LOWER FOX RIVER - Q14	
2016 TOP OF CAP ELEVATIONS	
PLAN VIEW	
Date: DECEMBER, 2016	Revision Date:
Drawn By: JRB2	Checked By: TMT1
Scope: 16L029	

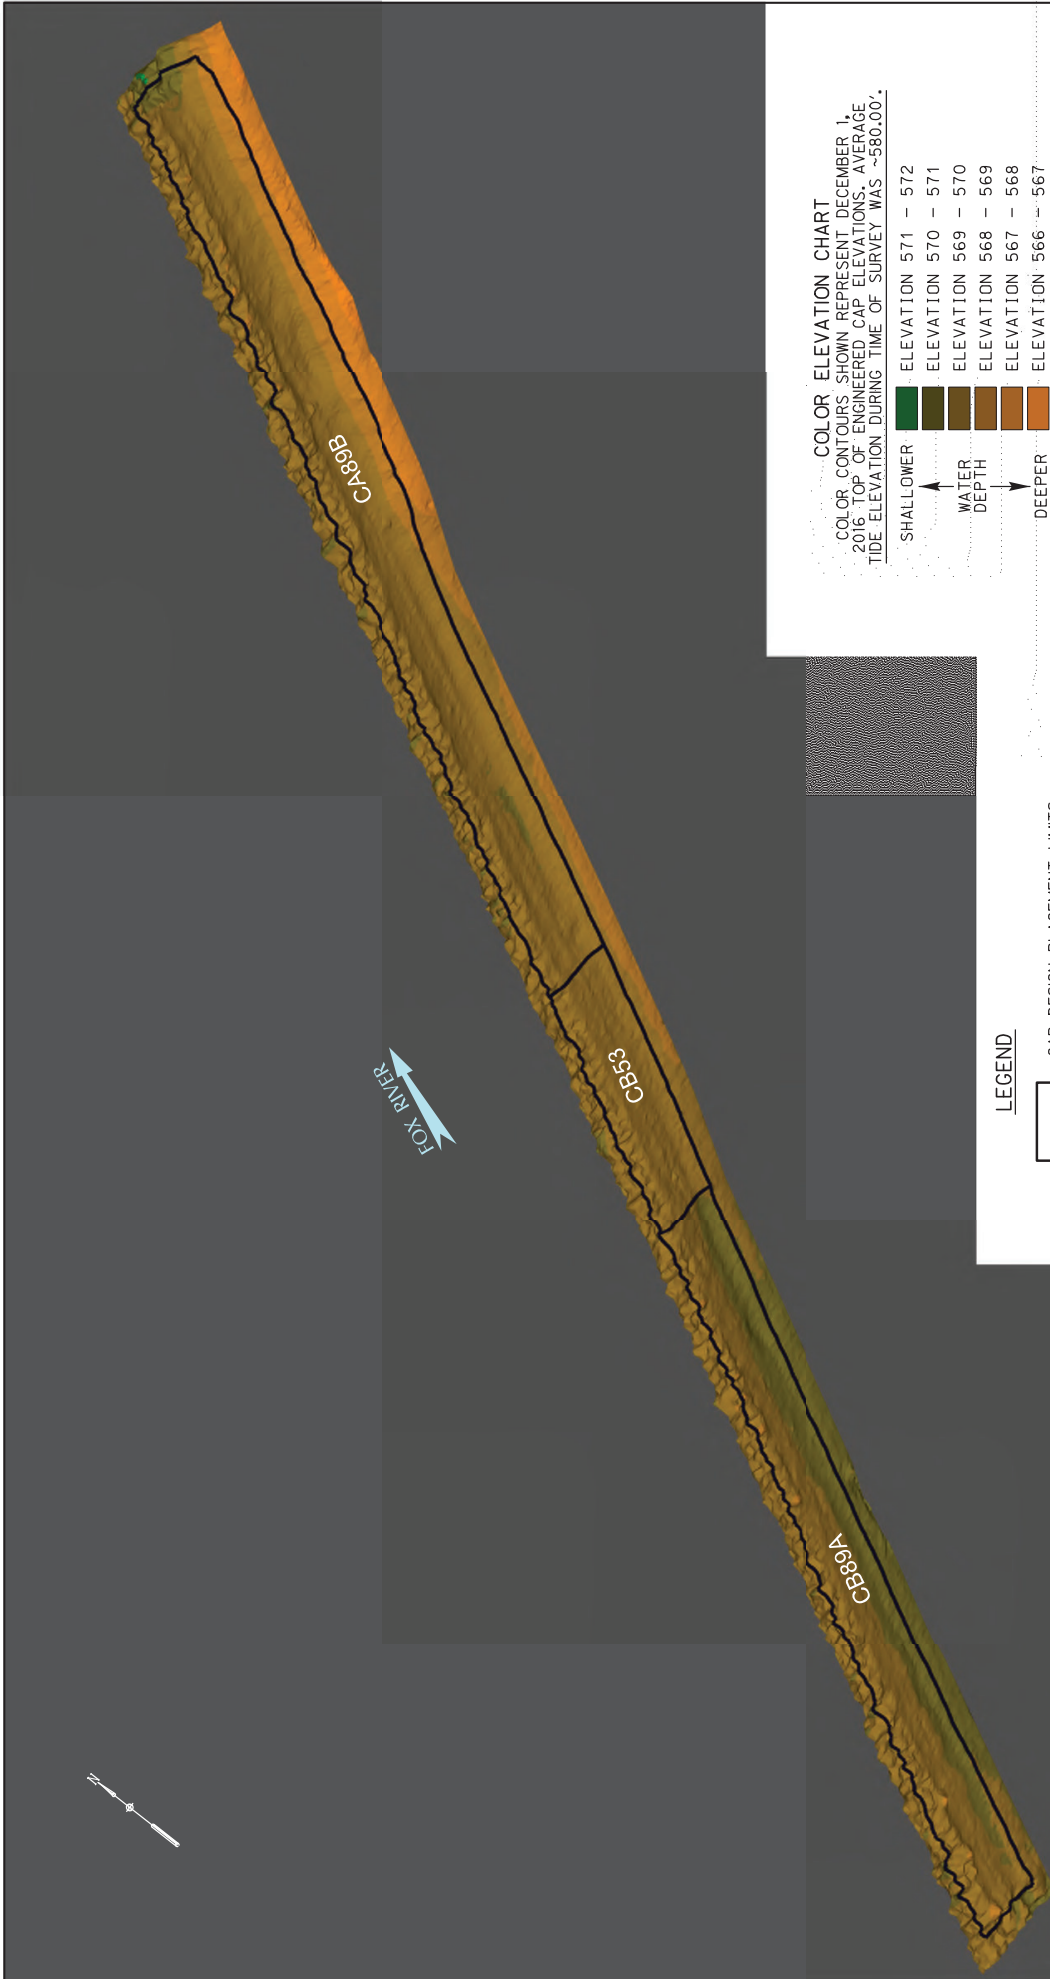

COLOR ELEVATION CHART
 COLOR CONTOURS SHOWN REPRESENT DECEMBER 1,
 2016 TOP OF ENGINEERED CAP ELEVATIONS, AVERAGE
 TIDE ELEVATION DURING TIME OF SURVEY WAS ~580.00'

SHALLOWER	ELEVATION 571 - 572
	ELEVATION 570 - 571
WATER DEPTH	ELEVATION 569 - 570
	ELEVATION 568 - 569
DEEPER	ELEVATION 567 - 568
	ELEVATION 566 - 567

LEGEND

□ CAP DESIGN PLACEMENT LIMITS

NOTES:

1. 400 KILBERTZ (442) MULTI-BEAM HYDROGRAPHIC SURVEY PERFORMED BY J.F. BERNAN, CO. DATE OF SURVEY: DECEMBER 4, 2016.
2. THE HORIZONTAL CONTROL IS REFERENCED TO THE NAD83 WISCONSIN STATE PLANE COORDINATE SYSTEM (WISCONSIN CENTRAL ZONE). THE VERTICAL CONTROL IS REFERENCED TO NAVD 88.
3. DESIGN CAP PLACEMENT LIMITS DERIVED FROM DESIGN FILES PROVIDED BY TETRA TECH EC, INC.




VERTICAL SCALE FOR ILLUSTRATION PURPOSES ONLY. NOT TO SCALE.

LOWER FOX RIVER REMEDIATION LLC.	
FIGURE 14B	
LOWER FOX RIVER - QUA	
2016 TOP OF CAP ELEVATIONS	
ISOMETRIC VIEW	
Date: DECEMBER, 2016	Revision Date:
Drawn By: JRB2	Checked By: TMK3
Scope:	16L029



COLOR ELEVATION CHART

COLOR ISOPACH CONTOURS SHOWN REPRESENT DEPTH CHANGE FROM NOVEMBER 13-14, 2014 TO DECEMBER 1, 2016 SURVEYS

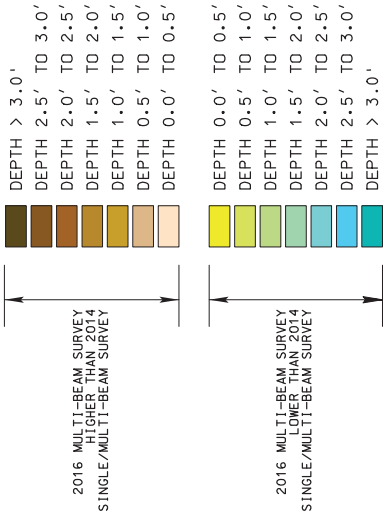

LEGEND


- CAP DESIGN PLACEMENT LIMITS
- 170' GRID LINES USED FOR POLING LOCATIONS
- ACTUAL CAP POLING/PROBING LOCATION AND IDENTIFICATION WITH MEASURED SEDIMENT THICKNESS

NOTES:
 1. 400 KILOHERTZ (KHZ) MULTI-BEAM HYDROGRAPHIC SURVEY PERFORMED BY J.F. BRENNAN, CO. DATE OF SURVEY: DECEMBER 1, 2016.
 2. THE HORIZONTAL CONTROL IS REFERENCED TO THE NAD83 WISCONSIN STATE PLANE COORDINATE SYSTEM (WISCONSIN CENTRAL ZONE). THE VERTICAL CONTROL IS REFERENCED TO NAVD 88.
 3. ORTHO PHOTO SUPPLIED BY BROWN COUNTY LAND INFORMATION OFFICE. COMPILED IN NOVEMBER 2010.
 4. DESIGN CAP PLACEMENT LIMITS DERIVED FROM DESIGN FILES PROVIDED BY TETRA TECH EC, INC.
 5. CAP POLING/PROBING PERFORMED BY FOTH ON NOVEMBER 3 - 4, 2016.

0 40' 80'
 BAR SCALE


LOWER FOX RIVER REMEDIATION LLC.	
FIGURE 14C	
LOWER FOX RIVER - OUA ISOPACH MAP BETWEEN THE 2014 & 2016 POST-CAPPING SURVEYS	
Date: DECEMBER, 2016	Revision Date:
Drawn By: JRB2	Checked By: TMT1
Scope: 16L029	

Boxplot Distributions of Survey Differences for 2016 Minus 2014 (400 kHz Multi-Beam⁽¹⁾)

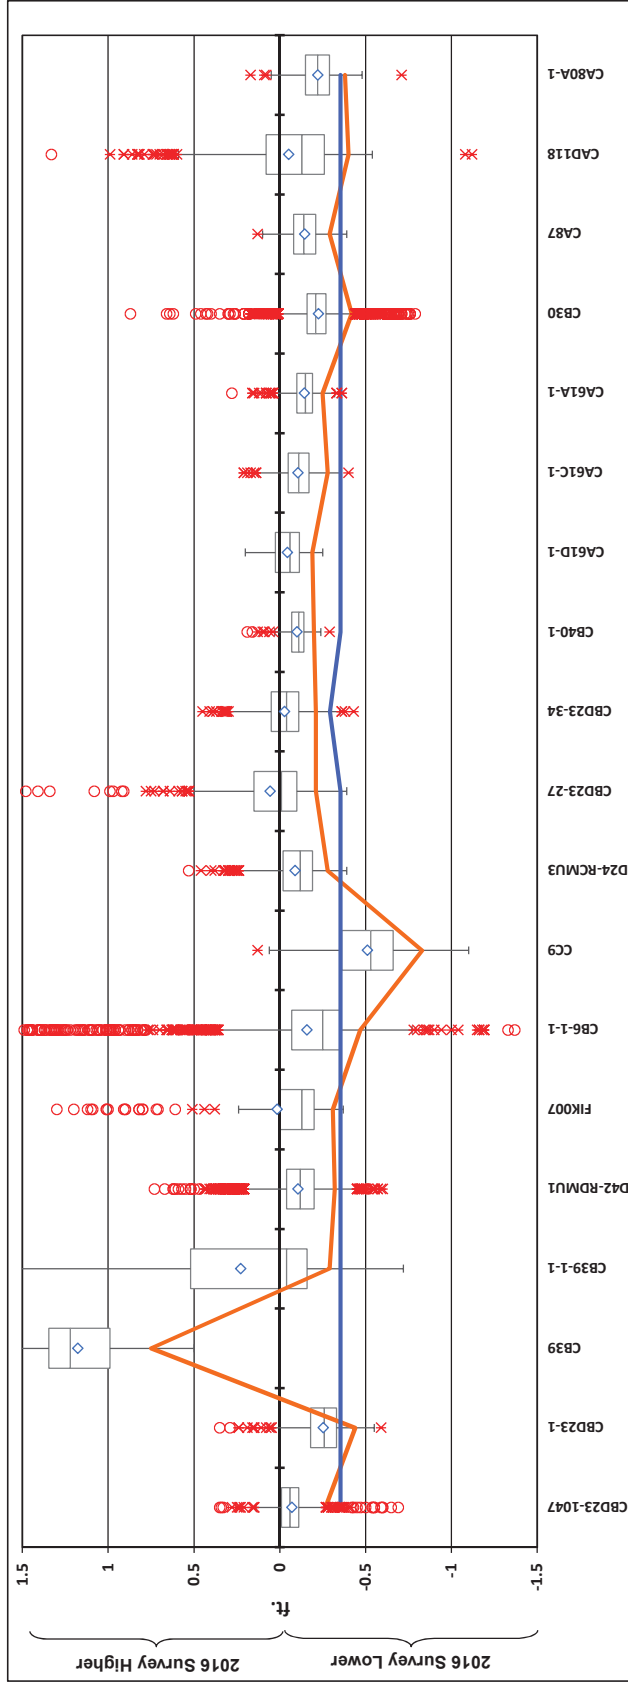

	n ⁽²⁾	826	3604	141	7416	838	681	804	1228	250	136	207	576	10244	394	715	264
5 th Percentile:	-0.27	-0.44	-0.29	-0.32	-0.31	-0.47	-0.28	-0.21	-0.21	-0.20	-0.19	-0.28	-0.25	-0.42	-0.29	-0.40	-0.38
50 th Percentile:	-0.06	-0.26	-0.04	-0.12	-0.13	-0.25	-0.12	-0.01	-0.04	-0.11	-0.06	-0.11	-0.15	-0.21	-0.14	-0.13	-0.22
95 th Percentile:	0.07	-0.05	1.56	0.24	1.01	0.27	0.21	0.46	0.20	0.01	0.13	0.12	-0.02	-0.07	0.01	0.59	-0.07
Vertical Error ⁽³⁾ :	-0.35	-0.35	-0.35	-0.35	-0.35	-0.35	-0.35	-0.35	-0.29	-0.35	-0.35	-0.35	-0.35	-0.35	-0.35	-0.35	-0.35

Boxplot Legend:

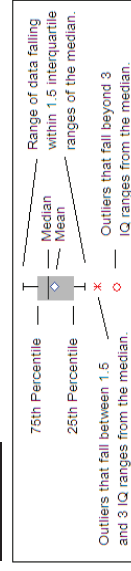

Notes: ⁽¹⁾Localized portions of CBD23-DMU27, CAD118 and CB33 had less than 3 feet of water in 2014, and a single beam echo sounder was used in place of the multi-beam. The 200 kHz single beam was utilized for the 2014 CBD23-DMU34 survey.

⁽²⁾The number of readings (n) which comprise the boxplot datasets are comprised of survey nodes taken along a 5-foot modeled grid.

⁽³⁾Combined vertical error estimate using propagation of errors formula $\sqrt{(\text{Error}_{\text{Survey}}^2 + \text{Error}_{\text{Survey}}^2)}$ applying the manufacturers vertical error estimate of 0.25 ft. for the 400 kHz multi-beam survey and 0.15 ft. for the 200 kHz single beam survey.

Cap areas are shown in order from upstream to downstream.




LOWER FOX RIVER REMEDIATION LLC

FIGURE 15A
DISTRIBUTIONS OF SURVEY DIFFERENCES
FOR 2016 AND 2014


Date: DECEMBER 2016	Revision Date:
Drawn By: SGL	Checked By: TMMK1
Sopper: 16L029	

Boxplot Distributions of Survey Differences for 2016 Minus 2014 (400 kHz Multi-Beam⁽¹⁾)

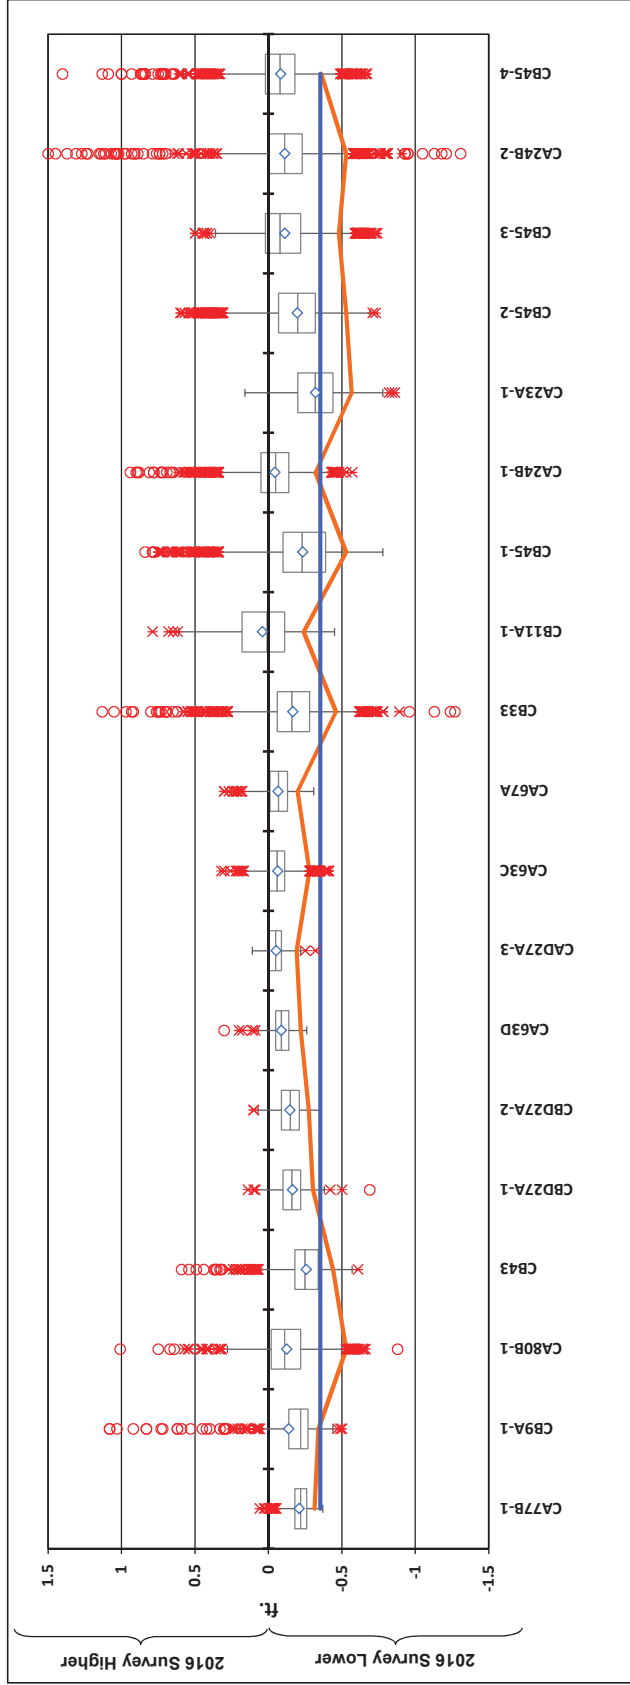

	n ⁽²⁾ :	270	528	7904	1091	227	269	152	757	1045	4726	1329	6051	2386	526	4165	5622	2783	4694
5 th Percentile:	-0.31	-0.34	-0.53	-0.44	-0.30	-0.28	-0.22	-0.19	-0.28	-0.20	-0.46	-0.24	-0.53	-0.32	-0.57	-0.53	-0.48	-0.53	-0.36
50 th Percentile:	-0.22	-0.22	-0.11	-0.25	-0.16	-0.15	-0.09	-0.05	-0.06	-0.07	-0.16	0.01	-0.23	-0.05	-0.32	-0.20	-0.08	-0.11	-0.08
95 th Percentile:	-0.03	0.43	0.26	-0.07	-0.04	0.02	0.04	0.08	0.10	0.09	0.12	0.41	0.10	0.24	-0.05	0.13	0.17	0.21	0.16
Vertical Error ⁽³⁾ :	-0.35	-0.35	-0.35	-0.35	-0.35	-0.35	-0.35	-0.35	-0.35	-0.35	-0.35	-0.35	-0.35	-0.35	-0.35	-0.35	-0.35	-0.35	-0.35

Boxplot Legend:

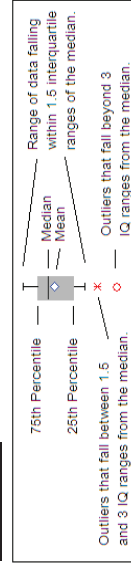

Notes: ⁽¹⁾Localized portions of CBD23-DMU27, CAD118 and CB33 had less than 3 feet of water in 2014, and a single beam echo sounder was used in place of the multi-beam. The 200 kHz single beam was utilized for the 2014 CBD23-DMU34 survey.

⁽²⁾The number of readings (n) which comprise the boxplot datasets are comprised of survey nodes taken along a 5-foot modeled grid.

⁽³⁾Combined vertical error estimate using propagation of errors formula $\sqrt{(\text{Error}_{\text{Survey}}^2 + \text{Error}_{\text{Survey}}^2)}$ applying the manufacturers vertical error estimate of 0.25 ft. for the 400 kHz multi-beam survey and 0.15 ft. for the 200 kHz single beam survey.

Cap areas are shown in order from upstream to downstream.


LOWER FOX RIVER REMEDIATION LLC

FIGURE 15B
DISTRIBUTIONS OF SURVEY DIFFERENCES
FOR 2016 AND 2014

Date: DECEMBER 2016 | Revision Date:
Drawn By: SGL | Checked By: TMMK1 | Sopper: 16L029




Boxplot Distributions of Survey Differences for 2016 Minus 2014 (400 kHz Multi-Beam⁽¹⁾)

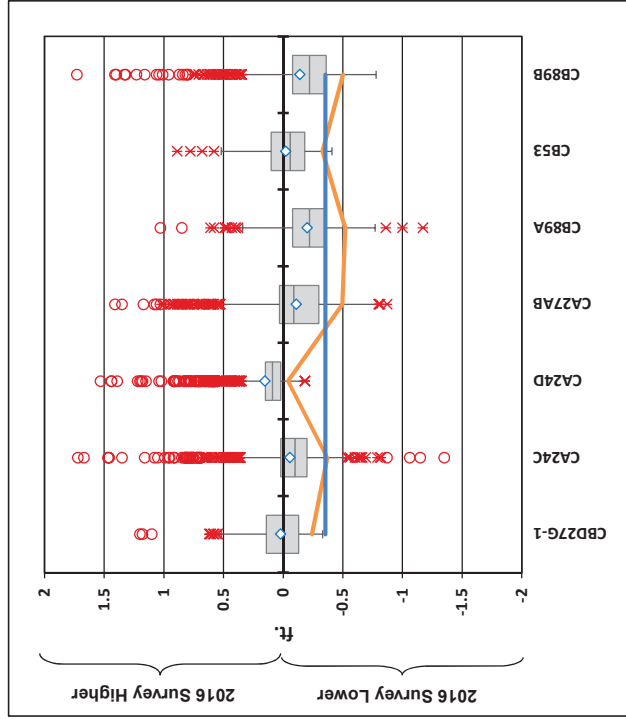

n⁽²⁾:	465	1290	973	1925	459	156	574
5th Percentile:	-0.24	-0.37	-0.04	-0.50	-0.52	-0.33	-0.50
50th Percentile:	-0.01	-0.10	0.09	-0.09	-0.22	-0.06	-0.22
95th Percentile:	0.44	0.51	0.65	0.35	0.27	0.49	0.61
Vertical Error⁽³⁾:	-0.35	-0.35	-0.35	-0.35	-0.35	-0.35	-0.35

Boxplot Legend:

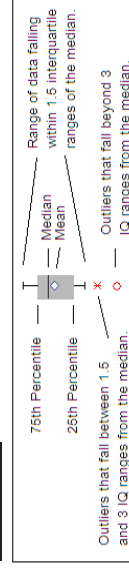

Notes: ⁽¹⁾Localized portions of CBD23-DMU27, CAD118 and CB33 had less than 3 feet of water in 2014, and a single beam echo sounder was used in place of the multi-beam. The 200 kHz single beam was utilized for the 2014 CBD23-DMU34 survey.

⁽²⁾The number of readings (n) which comprise the boxplot datasets are comprised of survey nodes taken along a 5-foot modeled grid.

⁽³⁾Combined vertical error estimate using propagation of errors formula $\sqrt{(\text{Error}_{\text{Survey}}^2 + \text{Error}_{\text{Survey}}^2)}$ applying the manufacturers vertical error estimate of 0.25 ft. for the 400 kHz multi-beam survey and 0.15 ft. for the 200 kHz single beam survey.

Cap areas are shown in order from upstream to downstream.



LOWER FOX RIVER REMEDIATION LLC

FIGURE 15C
DISTRIBUTIONS OF SURVEY DIFFERENCES
FOR 2016 AND 2014

Date: DECEMBER 2016 | Revision Date:

Drawn By: SGL | Checked By: TMMK1

Scope: 16L029

Attachment A

NOAA Monthly Water Elevation Data for Green Bay Station No. 9087079

NOAA/NOS/CO-OPS
 Verified Monthly Means at 9087079, Green Bay WI
 From 2014/03/01 00:00 LST to 2016/12/18 23:59 LST



— Verified — Preliminary

Options for

9087079 Green Bay, WI

From: Mar 1 2014

To: Dec 18 2016

Shift dates

Back 1 Month Forward 1 Month

Interval

6 min 1 hr H/L Day Month

Update

Plot Data Only

Units

Feet

Timezone

LST

Datum

IGLD

Water Elevations at NOAA Station No. 9087079

Year	Month	Highest Monthly Water Elevation (feet IGLD)	Verified Monthly Mean Water Elevation (feet IGLD)	Lowest Monthly Water Elevation (feet IGLD)
2014	3	578.320	577.418	576.572
2014	4	579.800	577.903	576.926
2014	5	579.409	578.508	577.562
2014	6	579.787	578.863	577.707
2014	7	580.190	578.990	578.087
2014	8	579.987	579.182	578.540
2014	9	581.211	579.202	577.408
2014	10	581.549	579.303	577.887
2014	11	581.568	579.099	577.582
2014	12	580.272	579.192	577.703
2015	1	580.000	579.051	577.379
2015	2	580.069	579.099	577.651
2015	3	579.813	579.092	577.881
2015	4	580.423	579.368	578.071
2015	5	580.896	579.522	578.488
2015	6	581.450	579.866	579.249
2015	7	581.348	579.867	579.058
2015	8	581.033	579.770	578.855
2015	9	580.833	579.858	578.907
2015	10	581.030	579.454	578.258
2015	11	580.768	579.107	577.188
2015	12	582.631	579.348	577.516
2016	1	581.125	579.243	578.002
2016	2	580.856	579.335	577.785
2016	3	582.251	579.671	577.615
2016	4	581.959	580.267	578.937
2016	5	581.437	580.295	579.534
2016	6	581.348	580.325	579.459
2016	7	581.335	580.243	579.419
2016	8	581.184	580.161	579.301
2016	9	581.096	580.089	578.724
2016	10	581.266	579.846	578.730

Data from NOAA: <https://www.cops.nos.noaa.gov/waterlevels.html?id=9087079>

Attachment B

Foth Field Notes for:

October 18-19, 2016 and December 1, 2016 Multi-Beam Year 2 Surveys; October 25, 2016 Single Beam Year 2 Survey; and November 3-4, 2016 Poling/Probing Survey

Table 1 – OU4 Year 2 Poling/Probing Deposition Measurements



Owner: Lower Fox River Remediation LLC
 Project: Lower Fox River OU2-5 RA
 Prepared by: Brad Kussman
 Checked by: Jim Buchberger

Project #: 16L029
 Date: 11-28-16
 Date: 11-29-16

Hydrographic Survey Audit Form

Date of Survey: 10-18-16

HYPACK Project Name: OU4 Long Term Monitoring Multi-beam Survey

Area(s) Surveyed: 161018 OU4 2014 Cap Areas

Captain: Ryan Sands
 Technicians: Brad Kussman
 Boat Name: 7749
 Trimble RTK: Trimble R5
 GPS Equipment:
 Type of Survey:

Pre-Dredge Post-Dredge
 Pre-Sand/Cap Post-Sand/Cap

Weather Conditions				
Time	Wave Heights	Wind Spd/Dir	Temp °F	Cloud Cover
1000	0-1'	5-10 W/NW	60	Partly

Control Data			
Pt. Name	Northing	Easting	Elevation
OU4-05A	247914.012	2482665.352	591.131
OU4-05A	247913.998	2482665.377	591.117

Minimum of 2 control points to be checked at both Start and End.	Check IN (at start)	Check OUT (at end)
Time	10:24	16:57
Point Name	OU4-05A	OU4-05A
Δ Horizontal:	0.036	0.065
V. Vertical:	0.005	0.009
Vertical and Horizontal within 0.13 ft. of published value		
Tide Elevation:	579.35	580.08
Time:	10:31	16:52

Sonic Sounder Calibration/Bar Check Information
Sounder # 2020
Transducer at <u>400</u> Hz

Latency: <u>0</u>	Date: <u>10-18-16</u>
Vertical Offset: <u>NA</u>	Draft: <u>1.10</u>

Plan Lines for Cross Lines: (check when added)

	Bar Check			
	(at start)		(at end)	
	Bar at	Fathometer (0.1 ft)	Bar at	Fathometer (0.1 ft)
Min. 2 ft below transducer (ft)	2	2	2	2
Min. 5 ft below transducer (ft)	5	5	5	5
Min 10 ft below transducer (ft)	10	10	10	10
Min 15 ft below transducer (ft)				
Min 20 ft below transducer (ft)				
Nearest ft. to bottom (ft)				
Speed of Sound Velocity Reading (ft/sec)	4816		4816	
Time when bar check made (hrs)	10:54		16:40	

Poling points to be evenly distributed within the area of survey.	Polings		
	Area:		
	Pt. #	Pole Depth (0.1 ft)	Fathometer
Pre-Dredge Surveys - Min. 1 poling per hour Post-Dredge Surveys - Min. of 3 polings required per certification unit or per day or more depending on specific project requirements.	1	13.0	13.0
	2	11.7	11.7
	3	11.1	11.1
	4	9.0	9.0
	5	11.1	11.1
	6		
	7		
	8		
	9		

Additional Notes:



Owner: Lower Fox River Remediation LLC
 Project: Lower Fox River OU2-5 RA
 Prepared by: Brad Kussman
 Checked by: Jim Buchberger

Project #: 16L029
 Date: 11-28-16
 Date: 11-29-16

Hydrographic Survey Audit Form

Date of Survey: 10-19-16

HYPACK Project Name: OU4 Long Term Monitoring Multi-beam Survey

Area(s) Surveyed: 161019 OU4 2014 Cap Areas

Captain: Ryan Sands
 Technicians: Brad Kussman
 Boat Name: 7749
 Trimble RTK: Trimble R5
 GPS Equipment:
 Type of Survey:

Pre-Dredge Post-Dredge
 Pre-Sand/Cap Post-Sand/Cap

Weather Conditions				
Time	Wave Heights	Wind Spd/Dir	Temp °F	Cloud Cover
1000	0-1'	2-7 W	60	Partly

Control Data			
Pt. Name	Northing	Easting	Elevation
OU4-05A	247913.988	2482665.365	591.117
OU4-05A	247913.971	2482665.355	591.10

Minimum of 2 control points to be checked at both Start and End.	Check IN (at start)	Check OUT (at end)
Time	11:39	16:43
Point Name	OU4-05A	OU4-05A
Δ Horizontal:	0.062	0.069
V. Vertical:	0.009	0.022
Vertical and Horizontal within 0.13 ft. of published value		
Tide Elevation:	579.94	580.21
Time:	11:44	16:39

Sonic Sounder Calibration/Bar Check Information
Sounder # 2020
Transducer at 400 Hz

Latency: <u>0</u>	Date: <u>10-19-16</u>
Vertical Offset: <u>NA</u>	Draft: <u>1.10</u>

Plan Lines for Cross Lines: (check when added)

	Bar Check			
	(at start)		(at end)	
	Bar at	Fathometer (0.1 ft)	Bar at	Fathometer (0.1 ft)
Min. 2 ft below transducer (ft)	2	2	2	2
Min. 5 ft below transducer (ft)	5	5	5	5
Min 10 ft below transducer (ft)	10	10	10	10
Min 15 ft below transducer (ft)				
Min 20 ft below transducer (ft)				
Nearest ft. to bottom (ft)				
Speed of Sound Velocity Reading (ft/sec)	4823		4823	
Time when bar check made (hrs)	12:00		16:30	

Polings	Area:		
	Pt. #	Pole Depth (0.1 ft)	Fathometer
Pre-Dredge Surveys - Min. 1 poling per hour	1	11.1	11.1
	2	12.4	12.4
Post-Dredge Surveys - Min. of 3 polings required per certification unit or per day or more depending on specific project requirements.	3	9.2	9.2
	4	10.3	10.3
	5		
	6		
	7		
	8		
	9		

Additional Notes:



Owner: Lower Fox River Remediation LLC
 Project: Lower Fox River OU2-5 RA
 Prepared by: SAM FRISBIE
 Checked by: Jim Buchberger

Project #: 16L029
 Date: 10/25/16
 Date: 12-5-16

Hydrographic Survey Audit Form

Date of Survey: 10/25/16
 HYPACK Project Name: 004 LTM SBES FOLL IN
 Area(s) Surveyed: LTM AREAS

Captain: J. WILK
 Technicians: " "
 Boat Name: JFB 7750
 Trimble RTK: R5 UNIT
 GPS Equipment:
 Type of Survey:

Pre-Dredge Post-Dredge
 Pre-Sand/Cap Post-Sand/Cap (LTM)

Minimum of 2 control points to be checked at both Start and End.	Check IN (at start)	Check OUT (at end)
Time	1241	1811
Point Name	004-05A	004-05A
Δ Horizontal:	0.026	0.035
V. Vertical:	-0.027	-0.004
Vertical and Horizontal within 0.13 ft. of published value		
Tide Elevation:	579.739	580.223
Time:	1246	1805

Weather Conditions				
Time	Wave Heights	Wind Spd/Dir	Temp °F	Cloud Cover
1505	CALM	4-7 mph NE	50	CLEAR

Control Data			
Pt. Name	Northing	Easting	Elevation
004-05A	247914.025	2482665.345	591.099
004-05A	247914.018	2482665.353	591.122

Sonic Sounder Calibration/Bar Check Information
Sounder # 320
Transducer at 200/20 Hz w/ beam width of 9.0°

Latency: -	Date: -
Vertical Offset: 8.19'	Draft: 0.41

Plan Lines for Cross Lines: (check when added)

	Bar Check			
	(at start)		(at end)	
	Bar at	Fathometer (0.1 ft)	Bar at	Fathometer (0.1 ft)
Min. 2 ft below transducer (ft)	5	5	5	5
Min. 5 ft below transducer (ft)	10	10	10	10
Min 10 ft below transducer (ft)	15	15	15	15
Min 15 ft below transducer (ft)	-	-	19	19
Min 20 ft below transducer (ft)	-	-	-	-
Nearest ft. to bottom (ft)	15	15	19	19
Speed of Sound Velocity Reading (ft/sec)	4779		4779	
Time when bar check made (hrs)	1252		1745	

Poling points to be evenly distributed within the area of survey.	Polings		
	Pt. #	Pole Depth (0.1 ft)	Fathometer
Pre-Dredge Surveys -- Min. 1 poling per hour Post-Dredge Surveys -- Min. of 3 polings required per certification unit or per day or more depending on specific project requirements.	Area: LTM		
	1	4.5	4.5
	2	7.0	7.0
	3	7.8	7.8
	4	9.2	9.2
	5	8.1	8.1
	6	4.3	4.3
	7	8.9	8.9
	8	3.8	3.8
9	4.2	4.2	

Additional Notes:



Client: Lower Fox River Remediation LLC
 Project: Lower Fox River OU 2-5 RA
 Prepared by: SAM ERISBIE
 Checked by: Jim Buchberger

Project #: 16L029
 Page: 1 of 1
 Date: 10/25/16
 Date: 12-5-16

Survey Audit Activity Log (Additional Polings)

Polings			
Poling points to be evenly distributed within the area of survey. Post-Dredge Surveys - Min. of 3 polings required per certification unit or per day or more depending on specific project requirements. Pre-Dredge Surveys - Min. 1 poling per hour	AREA:		
	Pt. #	Pole Depth (0.1 ft)	Fathometer
	1	3.1	3.1
	2	4.8	4.8
	3	5.3	5.3
	4	4.1	4.1
	5	4.0	4.0
6	3.6	3.6	

Polings			
Poling points to be evenly distributed within the area of survey. Post-Dredge Surveys - Min. of 3 polings required per certification unit or per day or more depending on specific project requirements. Pre-Dredge Surveys - Min. 1 poling per hour	AREA:		
	Pt. #	Pole Depth (0.1 ft)	Fathometer
	1	4.0	
	2	3.6	
	3	8.7	
	4		
	5		
6			

Polings			
Poling points to be evenly distributed within the area of survey. Post-Dredge Surveys - Min. of 3 polings required per certification unit or per day or more depending on specific project requirements. Pre-Dredge Surveys - Min. 1 poling per hour	AREA:		
	Pt. #	Pole Depth (0.1 ft)	Fathometer
	1		
	2		
	3		
	4		
	5		
6			



Owner: Lower Fox River Remediation LLC
 Project: Lower Fox River OU2-5 RA
 Prepared by: Brad Kussman
 Checked by: Jim Buchberger

Project #: 16L029
 Date: 12-1-16
 Date: 12-2-16

Hydrographic Survey Audit Form

Date of Survey: 12-1-16

HYPACK Project Name: OU4 Long Term Monitoring Multi-beam Survey

Area(s) Surveyed: 161201 OU4 2014 Cap Areas

Captain: Ryan Sands
 Technicians: Brad Kussman
 Boat Name: 7749
 Trimble RTK: Trimble R5
 GPS Equipment:
 Type of Survey:

Pre-Dredge Post-Dredge
 Pre-Sand/Cap Post-Sand/Cap

Weather Conditions				
Time	Wave Heights	Wind Spd/Dir	Temp °F	Cloud Cover
1000	0-1'	2-5 NW	38	Partly

Control Data			
Pt. Name	Northing	Easting	Elevation
OU4-05A	247914.015	2482665.337	591.12
OU4-05A	247913.989	2482665.349	591.12

Minimum of 2 control points to be checked at both Start and End.	Check IN (at start)	Check OUT (at end)
Time	10:05	11:34
Point Name	OU4-05A	OU4-05A
Δ Horizontal:	0.023	0.050
V. Vertical:	0.004	0.005
Vertical and Horizontal within 0.13 ft. of published value		
Tide Elevation:	579.34	579.55
Time:	10:10	11:29

Sonic Sounder Calibration/Bar Check Information
Sounder # 2020
Transducer at 400 Hz

Latency: <u>0</u>	Date: <u>12-1-16</u>
Vertical Offset: <u>NA</u>	Draft: <u>1.10</u>

Plan Lines for Cross Lines: (check when added)

	Bar Check			
	(at start)		(at end)	
	Bar at	Fathometer (0.1 ft)	Bar at	Fathometer (0.1 ft)
Min. 2 ft below transducer (ft)	2	2	2	2
Min. 5 ft below transducer (ft)	5	5	5	5
Min 10 ft below transducer (ft)	10	10	10	10
Min 15 ft below transducer (ft)	12	12		
Min 20 ft below transducer (ft)				
Nearest ft. to bottom (ft)				
Speed of Sound Velocity Reading (ft/sec)	4697		4697	
Time when bar check made (hrs)	10:10		11:12	

Poling points to be evenly distributed within the area of survey.	Polings		
	Area:		
	Pt. #	Pole Depth (0.1 ft)	Fathometer
Pre-Dredge Surveys - Min. 1 poling per hour Post-Dredge Surveys - Min. of 3 polings required per certification unit or per day or more depending on specific project requirements.	1	9.3	9.2
	2	10.1	10.1
	3	10.1	10.1
	4		
	5		
	6		
	7		
	8		
	9		

Additional Notes:



Client: Lower Fox River Remediation LLC

Project #: 16L029

Project: Lower Fox River OU4 COMMP

Page: 1 of 1

Prepared by: Brad Kussman

Date: 11/3/2016

Checked by: Tara Van Hoof

Date: 12/6/2016

Field Activity Observation Report

RA Activity OU4 COMMP Sediment Thickness Measurement/Cap Integrity Assessment

Location OU4 2014 Cap Areas

WEATHER	Temp (° F)		Sky Cond.	Precip. (in.)		Site Conditions (describe)	
	Low	High		Rain	Snow	Dry	Muddy
	40	58	M. Cloudy	-	-	-	-

Wind 2-5 West

Contractors on site (include no. of personnel per contractor)

Brad Kussman (BLK)

Sampling Crew

Brandon Wotachek (BJW1)

Sampling Crew

Sam Frisbie (SXF)

Sampling Crew

Other personnel on site:

Purpose:

Andrew Millspaugh - NRT

Oversight

Work observation report, comments:

0700 – Team arrived at the Riverway Marina and boarded the Foth sampling vessel.

0710 – Team departed the Riverway Marina for the Brown County Boat Launch to control point.

0725 – Team arrived at the Brown County boat launch and began preparing the sampling vessel for poling in OU4.

0829 – BLK checked into control point OU4-01R.

Northing: 234115.115

Easting: 2472856.724

Elevation: 586.032

Δ Horizontal: 0.050

Δ Vertical: 0.010

0842 – BLK surveyed tide elevation (580.074’).

0845-1640 – The team visited 100 poling locations, armor stone was confirmed.

1655 – The team arrived back at the Brown County boat launch.

1700 – BLK surveyed tide elevation (579.781’).



Client: Lower Fox River Remediation LLC
Project: Lower Fox River OU4 COMMP
Prepared by: Brad Kussman
Checked by: Tara Van Hoof

Project #: 16L029
Page: 2 of 1
Date: 11/3/2016
Date: 12/6/2016

Field Activity Observation Report

1712 – BLK checked out at control point OU4-01R.

Northing: 234115.078
Easting: 2472856.704
Elevation: 586.035
 Δ Horizontal: 0.038
 Δ Vertical: 0.007

1725 – The sampling team arrived at the Riverway Marina and secured the boat for future activities.

1730 – The sampling team departed the Riverway Marina for the Foth garage.

1745 – The sampling team arrived at the Foth garage, unloaded survey equipment and departed for the day.



Client: Lower Fox River Remediation LLC

Project #: 16L029

Project: Lower Fox River OU4 COMMP

Page: 1 of 1

Prepared by: Brad Kussman

Date: 11/4/2016

Checked by: Tara Van Hoof

Date: 12/6/2016

Field Activity Observation Report

RA Activity OU4 COMMP Sediment Thickness Measurement/Cap Integrity Assessment

Location OU4 2014 Cap Areas

WEATHER	Temp (° F)		Sky Cond.	Precip. (in.)		Site Conditions (describe)	
	Low	High		Rain	Snow	Dry	Muddy
	35	59	Sunny	-	-	-	-

Wind 2-5 South West

Contractors on site (include no. of personnel per contractor)

Brad Kussman (BLK)

Sampling Crew

Brandon Wotachek (BJW1)

Sampling Crew

Sam Frisbie (SXF)

Sampling Crew

Other personnel on site:

Purpose:

Jennifer Hagen - NRT

Oversight

Work observation report, comments:

0720 – Foth Team arrived at the Riverway Marina and boarded the Foth sampling vessel.

0730 – Foth Team departed the Riverway Marina for the Brown County Boat Launch to control point.

0800 – Team arrived at the Brown County boat launch and began preparing the sampling vessel for poling in OU4. Jennifer Hagen arrived as well from NRT.

0846 – BLK checked into control point OU4-01R.

Northing: 234115.114

Easting: 2472856.712

Elevation: 586.046

Δ Horizontal: 0.039

Δ Vertical: 0.004

0848 – BLK surveyed tide elevation (579.840’).

0900-1535 – The team visited 62 poling locations, armor stone was confirmed.

1540 – The team arrived back at the Brown County boat launch.

1542 – BLK surveyed tide elevation (579.657’).



Client: Lower Fox River Remediation LLC
Project: Lower Fox River OU4 COMMP
Prepared by: Brad Kussman
Checked by: Tara Van Hoof

Project #: 16L029
Page: 2 of 1
Date: 11/4/2016
Date: 12/6/2016

Field Activity Observation Report

1544 – BLK checked out at control point OU4-01R.

Northing: 234115.088
Easting: 2472856.728
Elevation: 586.036
 Δ Horizontal: 0.055
 Δ Vertical: 0.006

1550 – The sampling team disassembled sampling vessel for transport back to Foth garage.

1610 – The sampling team departed the Brown County boat launch for the Foth garage.

1630 – The sampling team arrived at the Foth garage, unloaded survey equipment and departed for the day.

Table 1
OU4 Year 2 Poling/Probing Deposition Measurements

Location	Proposed Easting	Proposed Northing	Actual Easting	Actual Northing	Deck Elevation (ft)	Time	Date	Water Depth (ft)	Depth of Hard Push (ft)	Total Sediment Thickness (ft)	Offset
P1	2472995.00	230685.00	2472995.15	230682.86	582.40	8:51am	11/3/2016	12.30	12.80	0.50	2.15
P2	2473000.00	230825.00	2473000.02	230825.75	582.42	8:56am	11/3/2016	14.40	14.70	0.30	0.75
P3	2472895.00	230790.00	2472896.13	230790.85	582.37	9:01am	11/3/2016	13.10	13.30	0.20	1.41
P4	2472785.00	230840.00	2472783.58	230838.95	582.34	9:04am	11/3/2016	11.40	11.60	0.20	1.77
P5	2472610.00	231050.00	2472609.35	231048.97	582.38	9:07am	11/3/2016	14.40	15.10	0.70	1.22
P6	2472745.00	231025.00	2472743.58	231027.83	582.37	9:10am	11/3/2016	18.50	18.60	0.10	3.17
P7	2472950.00	231220.00	2472949.56	231221.80	582.40	9:15am	11/3/2016	23.50	24.40	0.90	1.85
P8 sor	2472780.00	231220.00	2472779.78	231220.78	582.42	9:18am	11/3/2016	23.40	25.50	2.10	0.81
P9 sor	2472610.00	231220.00	2472609.51	231221.01	582.43	9:21am	11/3/2016	22.70	24.30	1.60	1.12
P10 sor	2472590.00	231375.00	2472588.93	231374.96	582.43	9:25am	11/3/2016	24.10	26.30	2.20	1.07
P11 sog	2472700.00	231355.00	2472701.14	231354.35	582.36	10:20am	11/4/2016	24.60	28.00	3.40	1.31
P12 sog	2472780.00	231390.00	2472781.96	231389.33	582.31	10:44am	11/4/2016	26.70	28.10	1.40	2.07
P13	2472950.00	231390.00	2472948.93	231391.58	582.10	10:53am	11/4/2016	29.00	29.80	0.80	1.91
P14 sog	2472695.00	231455.00	2472694.00	231456.69	582.34	10:39am	11/4/2016	25.60	27.80	2.20	1.96
P15	2472950.00	231560.00	2472951.30	231563.50	582.40	10:57am	11/4/2016	27.10	27.30	0.20	3.73
P16	2472780.00	231560.00	2472778.66	231562.33	582.17	10:33am	11/4/2016	29.20	29.90	0.70	2.69
P17	2472890.00	231720.00	2472890.55	231720.32	582.13	11:05am	11/4/2016	26.40	27.40	1.00	0.64
P18 sor	2473110.00	231620.00	2473110.26	231622.06	582.11	11:15am	11/4/2016	25.00	26.80	1.80	2.08
P19 sor	2473460.00	231470.00	2473462.55	231469.20	582.22	11:32am	11/4/2016	18.60	19.40	0.80	2.67
P20	2473570.00	231465.00	2473568.92	231464.97	582.24	11:37am	11/4/2016	15.10	15.20	0.10	1.08
P21 sor	2473600.00	231550.00	2473597.30	231550.46	582.17	15:31pm	11/4/2016	17.00	18.00	1.00	2.74
P22	2473460.00	231560.00	2473461.95	231559.41	582.15	11:30am	11/4/2016	15.00	15.00	0.00	2.04
P23	2473290.00	231560.00	2473297.87	231563.98	581.99	11:20am	11/4/2016	25.60	25.60	0.00	8.82
P24	2473385.00	231590.00	2473384.48	231591.98	582.12	11:25am	11/4/2016	24.20	25.00	0.80	2.05
P25	2473530.00	231655.00	2473527.12	231654.25	582.24	11:41am	11/4/2016	13.00	13.10	0.10	2.98
P26	2473460.00	231730.00	2473460.05	231728.40	582.05	12:24pm	11/4/2016	13.30	13.30	0.00	1.60
P27	2473630.00	231730.00	2473632.49	231727.96	582.20	12:16pm	11/4/2016	16.90	17.40	0.50	3.22
P28	2473625.00	231875.00	2473625.00	231874.24	582.50	9:42am	11/3/2016	13.40	13.40	0.00	0.76
P29	2473465.00	231865.00	2473462.44	231865.40	582.16	12:21pm	11/4/2016	12.70	12.80	0.10	2.59
P30	2473315.00	231945.00	2473313.93	231944.44	582.70	9:59am	11/3/2016	24.60	25.00	0.40	1.21
P31	2473340.00	232000.00	2473338.60	231999.76	582.68	9:56am	11/3/2016	23.70	24.20	0.50	1.42
P32	2473440.00	231985.00	2473439.98	231982.35	582.65	9:53am	11/3/2016	13.80	13.80	0.00	2.65
P33 sog	2473495.00	232035.00	2473494.46	232036.69	582.62	9:51am	11/3/2016	15.60	16.80	1.20	1.77

Table 1
OU4 Year 2 Poling/Probing Deposition Measurements

Location	Proposed		Actual		Deck Elevation (ft)	Time	Date	Water Depth (ft)	Depth of Hard Push (ft)	Total Sediment Thickness (ft)	Offset
	Easting	Northing	Easting	Northing							
P34	2473630.00	232070.00	2473631.22	232068.62	582.58	9:49am	11/3/2016	12.80	12.80	0.00	1.84
P35	2473780.00	231985.00	2473781.08	231982.92	582.52	9:45am	11/3/2016	12.00	12.40	0.40	2.34
P36	2473435.00	232125.00	2473433.85	232124.41	582.72	10:01am	11/3/2016	21.60	21.90	0.30	1.29
P37	2473380.00	232125.00	2473379.09	232124.81	582.75	10:03am	11/3/2016	24.50	24.70	0.20	0.93
P38	2471600.00	233210.00	2471601.60	233209.24	582.10	10:15am	11/4/2016	8.80	8.80	0.00	1.77
P39	2471700.00	233280.00	2471694.42	233280.22	582.09	10:10am	11/4/2016	9.40	9.40	0.00	5.58
P40	2471655.00	233305.00	2471657.31	233306.42	582.13	10:13am	11/4/2016	7.10	7.40	0.30	2.71
P41	2472200.00	233415.00	2472201.70	233414.76	582.20	10:07am	11/4/2016	6.70	6.70	0.00	1.72
P42	2472170.00	233505.00	2472168.98	233507.28	582.20	10:04am	11/4/2016	8.10	8.20	0.10	2.50
P43	2472320.00	233505.00	2472322.82	233506.39	582.25	10:00am	11/4/2016	7.30	7.40	0.10	3.14
P44	2474175.00	233405.00	2474176.99	233406.97	582.28	12:30pm	11/4/2016	26.10	26.50	0.40	2.80
P45	2474240.00	233375.00	2474239.93	233376.65	582.07	12:38pm	11/4/2016	25.60	25.70	0.10	1.65
P46	2474220.00	233430.00	2474222.24	233429.69	582.17	12:34pm	11/4/2016	26.40	26.50	0.10	2.26
P47	2474345.00	233535.00	2474347.32	233536.17	582.13	12:42pm	11/4/2016	26.00	26.60	0.60	2.60
P48	2474480.00	233660.00	2474481.91	233660.46	582.13	12:46pm	11/4/2016	17.20	17.40	0.20	1.96
P49	2474530.00	233770.00	2474532.30	233771.24	582.25	12:50pm	11/4/2016	22.40	22.60	0.20	2.61
P50	2474625.00	233980.00	2474625.68	233981.14	582.15	12:55pm	11/4/2016	24.30	24.80	0.50	1.33
P51	2474580.00	234125.00	2474580.96	234124.50	582.85	10:11am	11/3/2016	20.70	21.00	0.30	1.08
P52	2474650.00	234110.00	2474651.69	234109.21	582.90	10:15am	11/3/2016	24.70	24.90	0.20	1.87
P53	2474650.00	234280.00	2474649.92	234280.17	582.88	10:18am	11/3/2016	16.60	16.60	0.00	0.19
P54	2474820.00	234280.00	2474822.92	234281.00	582.95	10:22am	11/3/2016	24.80	24.80	0.00	3.09
P55	2474820.00	234450.00	2474822.09	234449.10	582.95	10:24am	11/3/2016	21.70	22.00	0.30	2.28
P56	2474990.00	234450.00	2474991.00	234450.57	582.95	10:26am	11/3/2016	24.20	24.20	0.00	1.15
P57	2475075.00	234505.00	2475076.40	234506.18	582.95	10:35am	11/3/2016	18.10	18.10	0.00	1.83
P58	2475080.00	234585.00	2475080.04	234585.41	582.90	10:38am	11/3/2016	24.00	24.20	0.20	0.41
P59	2474990.00	234620.00	2474989.25	234621.41	582.90	10:41am	11/3/2016	24.50	24.90	0.40	1.60
P60	2474950.00	234715.00	2474951.06	234714.26	582.88	10:44am	11/3/2016	19.60	19.60	0.00	1.29
P61	2475145.00	234700.00	2475147.86	234700.56	582.17	13:00pm	11/4/2016	23.50	23.50	0.00	2.91
P62	2475220.00	234665.00	2475218.26	234666.03	582.05	13:03pm	11/4/2016	19.00	19.30	0.30	2.02
P63	2475160.00	234790.00	2475162.93	234792.22	582.10	13:06pm	11/4/2016	25.10	25.40	0.30	3.68
P64	2474990.00	234790.00	2474990.19	234789.50	582.83	10:46am	11/3/2016	21.20	21.20	0.00	0.53
P65	2475000.00	234830.00	2475000.83	234830.52	582.85	10:49am	11/3/2016	18.80	18.80	0.00	0.98
P66	2474925.00	234850.00	2474923.47	234848.89	582.70	10:52am	11/3/2016	14.90	14.90	0.00	1.89

Table 1
OU4 Year 2 Poling/Probing Deposition Measurements

Location	Proposed Easting	Proposed Northing	Actual Easting	Actual Northing	Deck Elevation (ft)	Time	Date	Water Depth (ft)	Depth of Hard Push (ft)	Total Sediment Thickness (ft)	Offset
P67	2474915.00	234920.00	2474913.74	234919.70	582.70	10:55am	11/3/2016	13.40	13.40	0.00	1.30
P68	2474820.00	234960.00	2474818.89	234958.69	582.70	10:58am	11/3/2016	7.70	8.00	0.30	1.72
P69	2475030.00	234890.00	2475030.55	234891.37	582.67	11:02am	11/3/2016	14.50	14.50	0.00	1.48
P70	2475040.00	234940.00	2475040.76	234937.59	582.65	11:04am	11/3/2016	13.80	14.00	0.20	2.53
P71	2475160.00	234960.00	2475162.81	234961.03	582.55	11:10am	11/3/2016	20.00	20.00	0.00	2.99
P72	2475205.00	235035.00	2475206.63	235037.35	582.18	13:10pm	11/4/2016	16.90	17.10	0.20	2.86
P73	2475245.00	235135.00	2475244.80	235134.92	582.48	11:28am	11/3/2016	15.10	15.10	0.00	0.22
P74	2475280.00	235270.00	2475281.79	235268.99	582.56	11:31am	11/3/2016	11.00	11.00	0.00	2.06
P75	2475380.00	235280.00	2475380.00	235282.79	582.52	11:35am	11/3/2016	19.30	19.50	0.20	2.79
P76	2475380.00	235030.00	2475382.14	235028.51	582.60	11:22am	11/3/2016	22.70	22.70	0.00	2.61
P77	2475440.00	235120.00	2475439.42	235120.30	582.55	11:25am	11/3/2016	23.20	23.20	0.00	0.65
P78	2475435.00	234990.00	2475436.44	234990.93	582.53	11:19am	11/3/2016	21.40	21.40	0.00	1.71
P79	2475455.00	235080.00	2475455.31	235080.59	582.62	11:16am	11/3/2016	22.40	22.40	0.00	0.67
P80	2475480.00	235300.00	2475480.03	235298.97	582.53	11:41am	11/3/2016	23.90	24.00	0.10	1.03
P81	2475395.00	235360.00	2475394.30	235359.12	582.44	11:37am	11/3/2016	19.90	19.90	0.00	1.12
P82	2475500.00	235512.00	2475498.73	235512.42	582.90	12:14pm	11/3/2016	17.60	17.60	0.00	1.34
P83	2475570.00	235470.00	2475569.25	235470.09	583.01	12:17pm	11/3/2016	23.60	23.60	0.00	0.76
P84	2475670.00	235640.00	2475672.44	235639.33	582.28	13:15pm	11/4/2016	21.60	21.70	0.10	2.53
P85	2475690.00	235755.00	2475691.96	235754.15	582.19	13:19pm	11/4/2016	21.50	21.60	0.10	2.14
P86	2475805.00	235835.00	2475807.51	235834.33	582.25	13:21pm	11/4/2016	21.60	21.80	0.20	2.60
P87	2475810.00	235905.00	2475809.80	235904.56	582.20	13:24pm	11/4/2016	23.00	23.00	0.00	0.48
P88	2475895.00	236035.00	2475893.94	236037.45	582.20	13:26pm	11/4/2016	23.50	23.50	0.00	2.67
P89	2476010.00	235980.00	2476011.18	235980.98	582.11	13:30pm	11/4/2016	23.00	23.50	0.50	1.53
P90	2475955.00	236135.00	2475955.22	236133.87	582.37	13:39pm	11/4/2016	23.10	23.50	0.40	1.15
P91	2476010.00	236150.00	2476010.89	236150.73	582.30	13:35pm	11/4/2016	22.80	23.20	0.40	1.15
P92	2476180.00	236150.00	2476181.74	236150.16	582.32	13:42pm	11/4/2016	23.00	23.50	0.50	1.75
P93	2476045.00	236305.00	2476046.84	236303.08	582.35	13:47pm	11/4/2016	21.60	21.90	0.30	2.66
P94	2476180.00	236320.00	2476179.66	236320.82	582.20	13:45pm	11/4/2016	23.30	23.30	0.00	0.89
P95	2476120.00	236410.00	2476117.79	236409.82	583.15	12:25pm	11/3/2016	22.40	22.60	0.20	2.22
P96	2476340.00	236465.00	2476341.85	236464.04	582.40	13:51pm	11/4/2016	24.00	24.00	0.00	2.08
P97	2477130.00	237905.00	2477130.89	237904.35	583.04	12:33pm	11/3/2016	18.50	18.80	0.30	1.10
P98	2477200.00	238020.00	2477201.43	238021.70	583.05	12:35pm	11/3/2016	22.90	23.10	0.20	2.22
P99	2477230.00	238130.00	2477231.93	238130.21	583.05	12:39pm	11/3/2016	20.40	20.60	0.20	1.94

Table 1
OU4 Year 2 Poling/Probing Deposition Measurements

Location	Proposed Easting	Proposed Northing	Actual Easting	Actual Northing	Deck Elevation (ft)	Time	Date	Water Depth (ft)	Depth of Hard Push (ft)	Total Sediment Thickness (ft)	Offset
P100	2477210.00	238260.00	2477210.56	238261.47	583.00	12:42pm	11/3/2016	22.90	23.10	0.20	1.57
P101	2477080.00	238380.00	2477080.14	238379.55	583.00	12:47pm	11/3/2016	18.80	18.90	0.10	0.47
P102	2476985.00	238495.00	2476983.80	238497.87	582.95	12:50pm	11/3/2016	11.80	11.80	0.00	3.11
P103	2476880.00	238545.00	2476879.93	238544.38	582.99	12:52pm	11/3/2016	8.20	8.50	0.30	0.62
P104	2476730.00	238670.00	2476729.81	238669.21	582.93	12:55pm	11/3/2016	6.40	6.40	0.00	0.81
P105	2476665.00	238665.00	2476665.71	238664.90	582.88	12:58pm	11/3/2016	6.80	6.80	0.00	0.72
P106	2476545.00	238705.00	2476545.29	238705.48	582.99	13:00pm	11/3/2016	6.90	7.00	0.10	0.56
P107	2477200.00	238530.00	2477198.19	238532.77	582.85	13:04pm	11/3/2016	22.40	22.40	0.00	3.31
P108 soft	2477195.00	238700.00	2477196.47	238700.28	582.70	13:08pm	11/3/2016	21.70	23.70	2.00	1.50
P108A gravel	2477221.45	238712.67	2477221.45	238712.67	582.6	13:31pm	11/3/2016	22.4	N/A	N/A	27.88
p108b gravel	2477249.55	238728.56	2477249.55	238728.56	582.4	13:40pm	11/3/2016	22.4	N/A	N/A	60.14
P109	2477275.00	238760.00	2477274.85	238759.73	582.65	13:51pm	11/3/2016	22.30	22.40	0.10	0.31
P110	2477370.00	238870.00	2477369.51	238870.78	582.63	14:04pm	11/3/2016	21.90	22.20	0.30	0.92
P111	2477325.00	238975.00	2477322.77	238975.67	582.63	14:15pm	11/3/2016	20.40	20.40	0.00	2.33
P112	2477495.00	238740.00	2477496.04	238742.36	582.62	13:57pm	11/3/2016	23.20	23.60	0.40	2.58
P113	2477540.00	238870.00	2477538.76	238873.32	582.62	14:09pm	11/3/2016	23.80	24.30	0.50	3.54
P114	2477370.00	239040.00	2477374.50	239039.43	582.64	14:19pm	11/3/2016	18.20	18.30	0.10	4.54
P115	2477585.00	239070.00	2477582.96	239071.35	582.65	14:24pm	11/3/2016	24.20	24.40	0.20	2.45
P116	2477445.00	239190.00	2477446.67	239192.00	582.65	14:29pm	11/3/2016	21.90	22.80	0.90	2.61
P117	2477540.00	239210.00	2477541.56	239211.36	582.72	14:33pm	11/3/2016	23.60	23.80	0.20	2.07
P118	2477745.00	239145.00	2477745.01	239148.27	582.78	14:38pm	11/3/2016	20.70	21.10	0.40	3.27
P119	2477710.00	239210.00	2477708.36	239210.77	582.71	14:44pm	11/3/2016	24.70	24.70	0.00	1.81
P120	2477780.00	239265.00	2477781.16	239266.74	582.75	14:47pm	11/3/2016	23.00	23.20	0.20	2.09
P121	2477820.00	239325.00	2477820.25	239326.51	582.80	14:51pm	11/3/2016	22.30	22.80	0.50	1.53
P122	2477880.00	239380.00	2477879.85	239378.91	582.63	14:57pm	11/3/2016	22.20	22.50	0.30	1.10
P123	2477710.00	239380.00	2477710.56	239379.56	582.26	14:03pm	11/4/2016	25.30	25.60	0.30	0.71
P124	2477540.00	239380.00	2477540.73	239381.69	582.83	15:06pm	11/3/2016	17.40	17.60	0.20	1.84
P125	2477415.00	239330.00	2477415.80	239332.06	582.77	15:10pm	11/3/2016	12.40	12.60	0.20	2.21
P126	2477614.00	239550.00	2477614.77	239549.52	582.35	14:10pm	11/4/2016	17.10	17.40	0.30	0.91
P127	2477710.00	239550.00	2477711.92	239551.57	582.21	14:07pm	11/4/2016	25.00	25.00	0.00	2.48
P128	2477880.00	239550.00	2477880.60	239549.45	582.25	14:19pm	11/4/2016	25.70	25.80	0.10	0.81
P129	2477805.00	239605.00	2477805.04	239603.48	582.33	14:16pm	11/4/2016	25.70	26.00	0.30	1.52
P130	2477710.00	239720.00	2477710.55	239719.40	582.25	14:13pm	11/4/2016	15.80	15.80	0.00	0.81

Table 1
OU4 Year 2 Poling/Probing Deposition Measurements

Location	Proposed Easting	Proposed Northing	Actual Easting	Actual Northing	Deck Elevation (ft)	Time	Date	Water Depth (ft)	Depth of Hard Push (ft)	Total Sediment Thickness (ft)	Offset
P131	2477880.00	239720.00	2477878.24	239720.00	582.30	14:23pm	11/4/2016	25.60	25.90	0.30	1.76
P132	2478060.00	239680.00	2478061.41	239679.71	582.34	14:59pm	11/4/2016	19.20	19.20	0.00	1.44
P133	2477880.00	239890.00	2477880.69	239889.10	582.36	14:28pm	11/4/2016	24.70	25.00	0.30	1.13
P134	2478050.00	239890.00	2478050.59	239890.80	582.25	14:51pm	11/4/2016	24.30	24.30	0.00	0.99
P135	2478215.00	239930.00	2478217.21	239929.84	582.33	14:44pm	11/4/2016	18.30	18.30	0.00	2.22
P136	2478220.00	240060.00	2478222.33	240059.83	582.55	16:40pm	11/3/2016	21.20	21.20	0.00	2.34
P137	2478050.00	240060.00	2478051.33	240059.32	582.36	14:41pm	11/4/2016	24.10	24.40	0.30	1.49
P138	2477880.00	240060.00	2477882.13	240059.41	582.38	14:33pm	11/4/2016	14.40	14.60	0.20	2.21
P139	2478005.00	240195.00	2478005.64	240194.86	582.38	14:36pm	11/4/2016	14.70	15.20	0.50	0.66
P140	2478285.00	240190.00	2478287.06	240190.61	582.50	16:36pm	11/3/2016	22.90	22.90	0.00	2.15
P141	2478275.00	240290.00	2478275.59	240291.80	582.55	16:31pm	11/3/2016	20.90	21.30	0.40	1.89
P142	2478065.00	240320.00	2478065.19	240321.26	582.54	16:28pm	11/3/2016	14.10	14.10	0.00	1.27
P143 sor	2478080.00	240355.00	2478079.92	240353.56	582.54	16:23pm	11/3/2016	17.70	19.20	1.50	1.44
P144	2478235.00	240680.00	2478235.99	240680.52	582.46	16:15pm	11/3/2016	14.00	14.00	0.00	1.12
P145	2478340.00	240850.00	2478338.43	240851.41	582.47	16:13pm	11/3/2016	12.90	13.20	0.30	2.11
P146	2478415.00	241015.00	2478414.22	241014.27	582.50	16:11pm	11/3/2016	13.10	13.20	0.10	1.07
P147	2478510.00	240785.00	2478510.23	240785.78	582.45	16:19pm	11/3/2016	15.80	16.00	0.20	0.81
P148	2478625.00	241045.00	2478626.13	241046.34	582.48	16:08pm	11/3/2016	13.90	13.90	0.00	1.75
P149	2478730.00	241250.00	2478729.80	241248.37	582.52	16:05pm	11/3/2016	13.20	13.30	0.10	1.64
P150	2478935.00	241590.00	2478934.22	241589.55	582.58	16:01pm	11/3/2016	11.90	12.20	0.30	0.90
P151	2479052.00	241862.00	2479050.71	241861.35	582.58	15:59pm	11/3/2016	13.00	13.20	0.20	1.44
P152	2479141.00	242020.00	2479138.20	242021.75	582.62	15:57pm	11/3/2016	12.70	13.20	0.50	3.30
P153	2479240.00	242100.00	2479238.51	242100.53	582.62	15:54pm	11/3/2016	12.80	13.20	0.40	1.58
P154	2479585.00	242455.00	2479584.82	242454.75	582.50	15:51pm	11/3/2016	12.30	12.60	0.30	0.31
P155	2479720.00	242560.00	2479721.65	242562.26	582.53	15:48pm	11/3/2016	11.70	11.80	0.10	2.80
P156	2479805.00	242655.00	2479807.74	242654.05	582.60	15:45pm	11/3/2016	13.20	13.60	0.40	2.90
P157	2479905.00	242720.00	2479905.37	242719.55	582.60	15:43pm	11/3/2016	12.60	12.60	0.00	0.58
P158	2479975.00	242780.00	2479976.68	242780.09	582.58	15:40pm	11/3/2016	12.60	12.90	0.30	1.68
P159	2480150.00	242920.00	2480148.97	242917.29	582.67	15:36pm	11/3/2016	12.80	13.00	0.20	2.90


sog = soft over gravel
sor = soft over rock

Prepared by: BLIK
Checked by: TM/K1

Attachment C

**USGS Flow Data for Station No. 040851385 –
Fox River Oil Tank Depot at Green Bay, WI**

FIGURE 1
OU4 USGS 040851385 Fox River Oil Tank Depot at Green Bay, WI

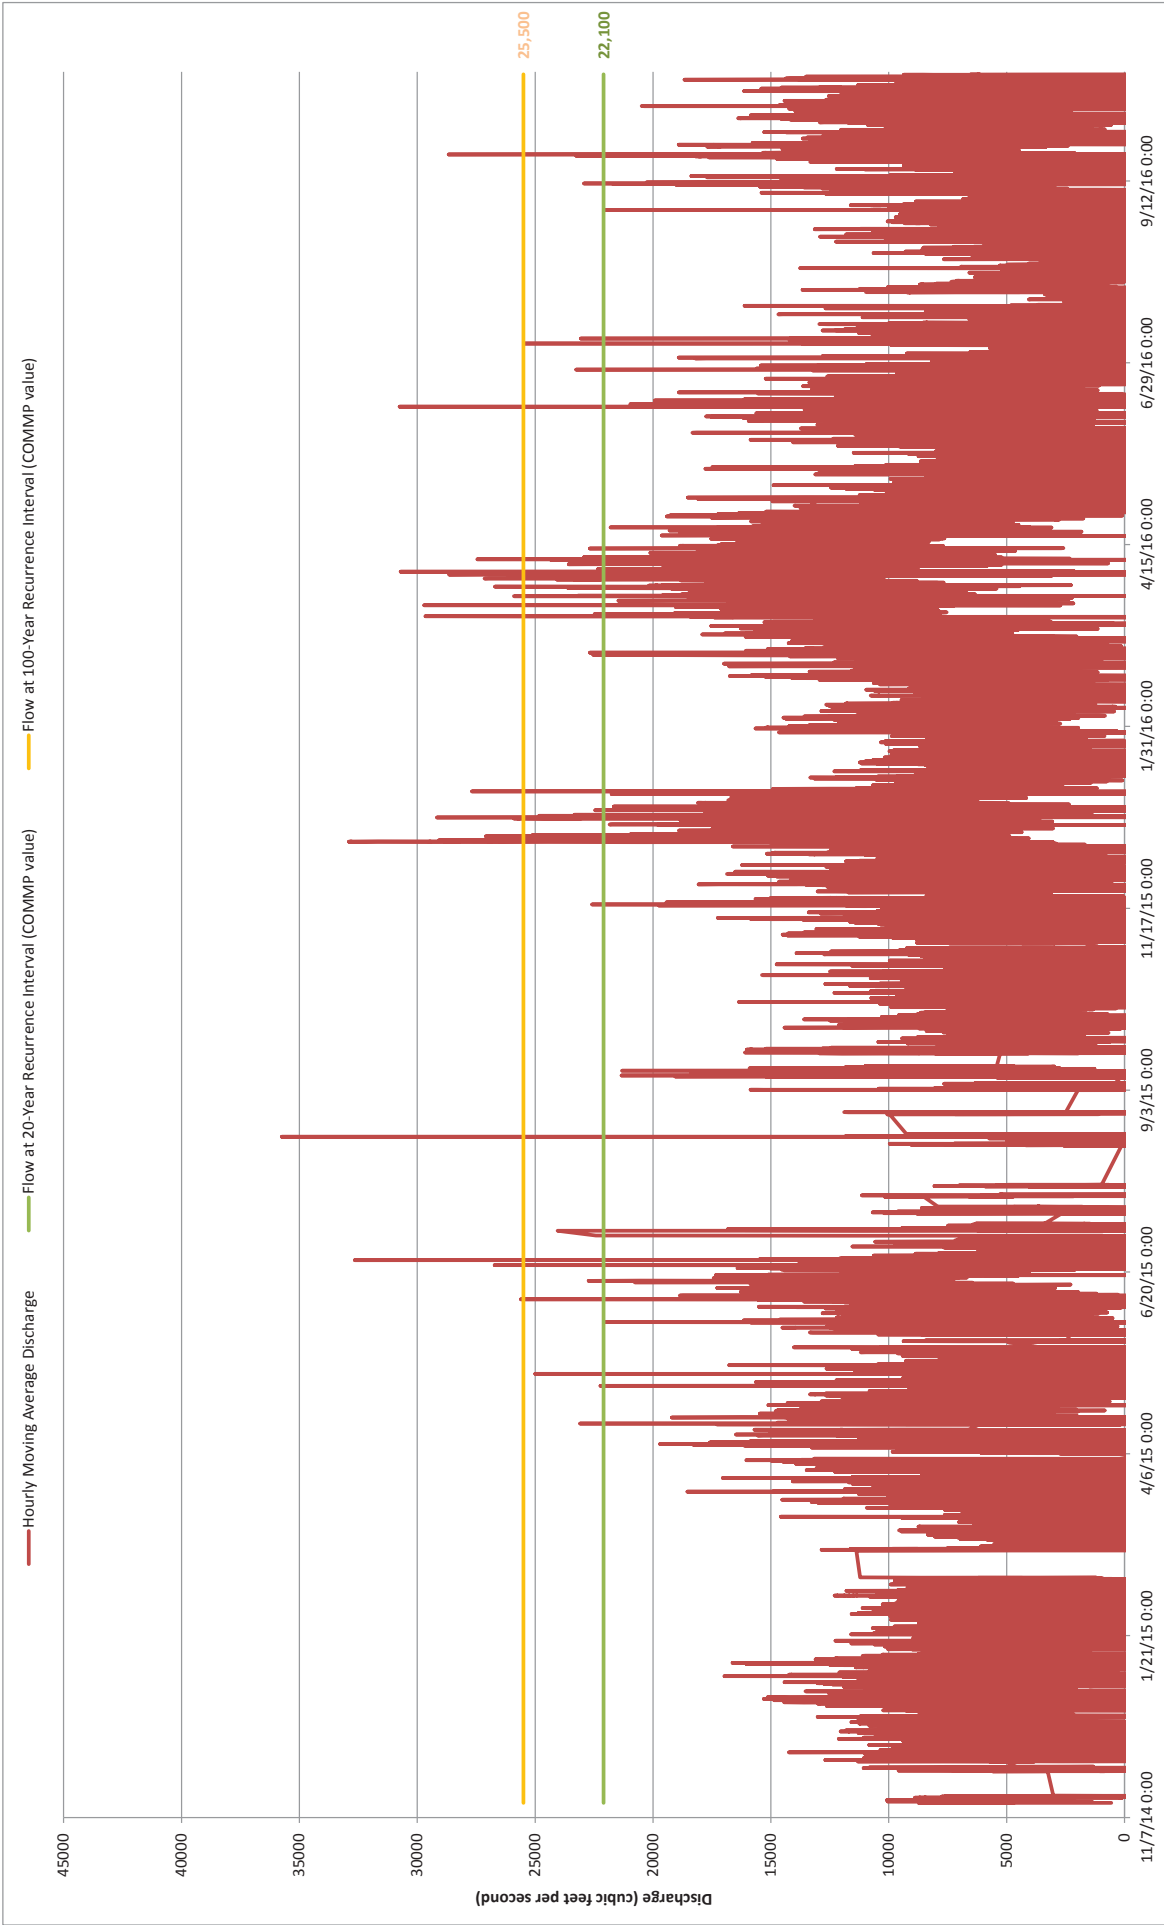

Hourly Average Flows Exceeding 20-Year (22,100 cfs) and 100-Year (25,500 cfs) Recurrence Intervals

Date and Time	Flows Exceeding Recurrence Intervals		Date and Time	Flows Exceeding Recurrence Intervals		Date and Time	Flows Exceeding Recurrence Intervals	
	20-Year (cfs)	100-Year (cfs)		20-Year (cfs)	100-Year (cfs)		20-Year (cfs)	100-Year (cfs)
4/18/15 11:05 AM	22542	23081	6/24/15 8:40 PM	32542	32542	12/14/15 8:15 AM	26483	26483
4/18/15 11:10 AM	22867	26453	6/24/15 8:45 PM	31992	31992	12/14/15 8:20 AM	26417	26417
4/18/15 11:15 AM	23042	29392	6/24/15 8:50 PM	31425	31425	12/14/15 8:25 AM	26400	26400
4/18/15 11:20 AM	23092	31425	6/24/15 8:55 PM	32642	32642	12/14/15 8:30 AM	26408	26408
4/18/15 11:25 AM	22842	32642	6/24/15 9:00 PM	32542	32542	12/14/15 8:35 AM	26533	26533
4/18/15 11:30 AM	22392	32542	6/24/15 9:05 PM	31992	31992	12/14/15 8:40 AM	26567	26567
5/4/15 12:55 AM	22225	31992	6/24/15 9:10 PM	31300	31300	12/14/15 8:45 AM	26633	26633
5/4/15 1:00 AM	22200	31300	6/24/15 9:15 PM	30033	30033	12/14/15 8:50 AM	26633	26633
5/8/15 10:35 PM	23229	30033	6/24/15 9:20 PM	28208	28208	12/14/15 8:55 AM	26717	26717
5/8/15 10:40 PM	24842	28208	6/24/15 9:25 PM	26325	26325	12/14/15 9:00 AM	26933	26933
5/8/15 10:45 PM	25000	26325	6/24/15 9:30 PM	24433	24433	12/14/15 9:05 AM	26975	26975
5/8/15 10:50 PM	24483	24433	6/24/15 9:35 PM	22525	22525	12/14/15 9:10 AM	26875	26875
5/8/15 10:55 PM	23542	22525	6/24/15 9:40 PM	22421	22421	12/14/15 9:15 AM	27033	27033
5/8/15 11:00 PM	22120	22421	7/7/15 12:00 AM	24050	24050	12/14/15 9:20 AM	27292	27292
6/8/15 4:40 PM	22208	23708	7/7/15 12:05 AM	23708	23708	12/14/15 9:25 AM	27500	27500
6/8/15 4:45 PM	23583	23708	7/7/15 12:10 AM	22883	22883	12/14/15 9:30 AM	27625	27625
6/8/15 4:50 PM	24492	22883	8/14/15 5:35 PM	23903	23903	12/14/15 9:35 AM	27808	27808
6/8/15 4:55 PM	25142	23903	8/14/15 5:40 PM	27580	27580	12/14/15 9:40 AM	28000	28000
6/8/15 5:00 PM	25600	27580	8/14/15 5:45 PM	30925	30925	12/14/15 9:45 AM	28325	28325
6/8/15 5:05 PM	25217	30925	8/14/15 5:50 PM	33842	33842	12/14/15 9:50 AM	28233	28233
6/8/15 5:10 PM	24733	33842	8/14/15 5:55 PM	35250	35250	12/14/15 9:55 AM	28408	28408
6/8/15 5:15 PM	23692	35250	8/14/15 6:00 PM	35742	35742	12/14/15 10:00 AM	28467	28467
6/8/15 5:20 PM	22208	35742	8/14/15 6:05 PM	35617	35617	12/14/15 10:05 AM	28700	28700
6/16/15 8:20 AM	22400	34783	8/14/15 6:10 PM	34783	34783	12/14/15 10:10 AM	28850	28850
6/16/15 8:25 AM	22600	34783	8/14/15 6:15 PM	32239	32239	12/14/15 10:15 AM	28808	28808
6/16/15 8:30 AM	22700	32239	8/14/15 6:20 PM	29086	29086	12/14/15 10:20 AM	29025	29025
6/16/15 8:35 AM	22733	29086	8/14/15 6:25 PM	25466	25466	12/14/15 10:25 AM	29183	29183
6/16/15 8:40 AM	22733	25466	11/18/15 1:15 PM	22217	22217	12/14/15 10:30 AM	29333	29333
6/16/15 8:45 AM	22600	22217	11/18/15 1:20 PM	22567	22567	12/14/15 10:35 AM	29475	29475
6/16/15 8:50 AM	22517	22567	11/18/15 1:25 PM	22583	22583	12/14/15 10:40 AM	29500	29500
6/16/15 8:55 AM	22358	22392	11/18/15 1:30 PM	22392	22392	12/14/15 10:45 AM	29433	29433
6/16/15 9:00 AM	22117	22392	12/14/15 7:30 AM	22375	22375	12/14/15 10:50 AM	29742	29742
6/22/15 6:50 PM	22751	22375	12/14/15 7:35 AM	24175	24175	12/14/15 10:55 AM	29975	29975
6/22/15 6:55 PM	24614	23283	12/14/15 7:40 AM	24708	24708	12/14/15 11:00 AM	30183	30183
6/22/15 7:00 PM	25950	24708	12/14/15 7:45 AM	25275	25275	12/14/15 11:05 AM	30417	30417
6/22/15 7:05 PM	26508	24708	12/14/15 7:50 AM	25708	25708	12/14/15 11:10 AM	30767	30767
6/22/15 7:10 PM	26717	25275	12/14/15 7:55 AM	25683	25683	12/14/15 11:15 AM	31283	31283
6/22/15 7:15 PM	26358	25683	12/14/15 8:00 AM	25858	25858	12/14/15 11:20 AM	31508	31508
6/22/15 7:20 PM	25883	25858	12/14/15 8:05 AM	26125	26125	12/14/15 11:25 AM	31742	31742
6/22/15 7:25 PM	24492	26125	12/14/15 8:10 AM	26408	26408	12/14/15 11:30 AM	31983	31983
6/22/15 7:30 PM	22883	26408				12/14/15 11:35 AM	32167	32167

Hourly Average Flows Exceeding 20-Year (22,100 cfs) and 100-Year (25,500 cfs) Recurrence Intervals

Date and Time	Flows Exceeding Recurrence Intervals		Flows Exceeding Recurrence Intervals		Flows Exceeding Recurrence Intervals	
	100-Year (cfs)	20-Year (cfs)	100-Year (cfs)	20-Year (cfs)	100-Year (cfs)	20-Year (cfs)
12/14/15 11:45 AM	32642	32642	26608	26608	26650	26650
12/14/15 11:50 AM	32850	32850	26242	26242	26592	26592
12/14/15 11:55 AM	32775	32775	25983	25983	26417	26417
12/14/15 12:00 PM	32900	32900	25758	25758	26267	26267
12/14/15 12:05 PM	32733	32733	25683	25683	26392	26392
12/14/15 12:10 PM	32642	32642	25475	25475	26300	26300
12/14/15 12:15 PM	32417	32417	25217	25217	26392	26392
12/14/15 12:20 PM	32275	32275	24925	24925	26325	26325
12/14/15 12:25 PM	32000	32000	24858	24858	26233	26233
12/14/15 12:30 PM	31717	31717	24617	24617	26258	26258
12/14/15 12:35 PM	31433	31433	24508	24508	26308	26308
12/14/15 12:40 PM	31100	31100	24333	24333	26167	26167
12/14/15 12:45 PM	30800	30800	24242	24242	26117	26117
12/14/15 12:50 PM	30383	30383	24233	24233	26000	26000
12/14/15 12:55 PM	30092	30092	24067	24067	25975	25975
12/14/15 1:00 PM	29625	29625	23992	23992	25858	25858
12/14/15 1:05 PM	29375	29375	23883	23883	25550	25550
12/14/15 1:10 PM	29050	29050	23958	23958	25375	25375
12/14/15 1:15 PM	28808	28808	24075	24075	25100	25100
12/14/15 1:20 PM	28500	28500	24267	24267	24800	24800
12/14/15 1:25 PM	28433	28433	24292	24292	24492	24492
12/14/15 1:30 PM	28392	28392	24483	24483	24192	24192
12/14/15 1:35 PM	28417	28417	24808	24808	23875	23875
12/14/15 1:40 PM	28500	28500	25017	25017	23600	23600
12/14/15 1:45 PM	28333	28333	25342	25342	23433	23433
12/14/15 1:50 PM	28367	28367	25600	25600	23150	23150
12/14/15 1:55 PM	28283	28283	26017	26017	22967	22967
12/14/15 2:00 PM	28458	28458	26275	26275	22908	22908
12/14/15 2:05 PM	28658	28658	26625	26625	22992	22992
12/14/15 2:10 PM	28833	28833	26767	26767	23142	23142
12/14/15 2:15 PM	28692	28692	27025	27025	23342	23342
12/14/15 2:20 PM	28667	28667	27283	27283	23483	23483
12/14/15 2:25 PM	28725	28725	27475	27475	23842	23842
12/14/15 2:30 PM	28567	28567	27583	27583	24200	24200
12/14/15 2:35 PM	28408	28408	27525	27525	24308	24308
12/14/15 2:40 PM	28175	28175	27517	27517	24642	24642
12/14/15 2:45 PM	28150	28150	27383	27383	24792	24792
12/14/15 2:50 PM	28050	28050	27150	27150	25142	25142
12/14/15 2:55 PM	27908	27908	27183	27183	25283	25283
12/14/15 3:00 PM	27642	27642	27208	27208	25658	25658
12/14/15 3:05 PM	27367	27367	26975	26975	25608	25608
12/14/15 3:10 PM	26967	26967	26942	26942	25533	25533
12/14/15 3:15 PM	26800	26800	26800	26800	25542	25542

Hourly Average Flows Exceeding 20-Year (22,100 cfs) and 100-Year (25,500 cfs) Recurrence Intervals

Date and Time	Flows Exceeding Recurrence Intervals		Date and Time	Flows Exceeding Recurrence Intervals	
	20-Year (cfs)	100-Year (cfs)		20-Year (cfs)	100-Year (cfs)
12/14/15 10:30 PM	25367	26267	12/15/15 3:40 AM	24400	23058
12/14/15 10:35 PM	25042	27192	12/15/15 3:45 AM	24367	23200
12/14/15 10:40 PM	24617	27925	12/15/15 3:50 AM	24442	23408
12/14/15 10:45 PM	24142	28558	12/15/15 3:55 AM	24375	23517
12/14/15 10:50 PM	23600	28875	12/15/15 4:00 AM	24417	23617
12/14/15 10:55 PM	23375	28975	12/15/15 4:05 AM	24208	23733
12/14/15 11:00 PM	22808	29075	12/15/15 4:10 AM	23983	23975
12/14/15 11:05 PM	22225	28475	12/15/15 4:15 AM	23800	24075
12/15/15 12:35 AM	22425	27592	12/15/15 4:20 AM	23217	24183
12/15/15 12:40 AM	23325	28825	12/15/15 4:25 AM	23083	24383
12/15/15 12:45 AM	24392	29075	12/15/15 4:30 AM	22817	24675
12/15/15 12:50 AM	25408	28875	12/15/15 4:35 AM	22525	24742
12/15/15 12:55 AM	26267	28475	12/15/15 4:40 AM	22275	24783
12/15/15 1:00 AM	27192	28042	12/16/15 3:15 PM	22842	24858
12/15/15 1:05 AM	27925	27592	12/16/15 3:20 PM	24083	24950
12/15/15 1:10 AM	28558	26292	12/16/15 3:25 PM	25225	25075
12/15/15 1:15 AM	28875	25692	12/16/15 3:30 PM	26075	25208
12/15/15 1:20 AM	28925	24975	12/16/15 3:35 PM	26483	25317
12/15/15 1:25 AM	29075	2475	12/16/15 3:40 PM	26842	25333
12/15/15 1:30 AM	28875	28875	12/16/15 3:45 PM	27083	25433
12/15/15 1:35 AM	28475	28475	12/16/15 3:50 PM	26858	25592
12/15/15 1:40 AM	28042	28042	12/16/15 3:55 PM	26650	25742
12/15/15 1:45 AM	27592	27592	12/16/15 4:00 PM	26208	25667
12/15/15 1:50 AM	26858	26858	12/16/15 4:05 PM	25742	25783
12/15/15 1:55 AM	26292	26292	12/16/15 4:10 PM	25042	25892
12/15/15 2:00 AM	25692	25692	12/16/15 4:15 PM	24450	25792
12/15/15 2:05 AM	24975	24975	12/16/15 4:20 PM	23600	25650
12/15/15 2:10 AM	24175	24175	12/16/15 4:25 PM	22817	25425
12/15/15 2:15 AM	23708	23708	12/17/15 4:00 AM	22275	25233
12/15/15 2:20 AM	23433	23433	12/17/15 4:05 AM	23150	24833
12/15/15 2:25 AM	22967	22967	12/17/15 4:10 AM	23758	24425
12/15/15 2:30 AM	22558	22558	12/17/15 4:15 AM	24200	24175
12/15/15 2:35 AM	22383	22383	12/17/15 4:20 AM	24550	23667
12/15/15 2:40 AM	22350	22350	12/17/15 4:25 AM	24825	23017
12/15/15 2:45 AM	22267	22267	12/17/15 4:30 AM	25042	22383
12/15/15 2:50 AM	22358	22358	12/17/15 4:35 AM	25050	22450
12/15/15 2:55 AM	22450	22450	12/17/15 4:40 AM	25108	22433
12/15/15 3:00 AM	22592	22592	12/17/15 4:45 AM	24983	25617
12/15/15 3:05 AM	22975	22975	12/17/15 4:50 AM	24475	26608
12/15/15 3:10 AM	23425	23425	12/17/15 4:55 AM	24067	27633
12/15/15 3:15 AM	23617	23617	12/17/15 5:00 AM	23392	28308
12/15/15 3:20 AM	23900	23900	12/17/15 5:05 AM	22700	28908
12/15/15 3:25 AM	23967	23967	12/23/15 9:45 PM	22517	29158
12/15/15 3:30 AM	24133	24133	12/23/15 9:50 PM	22675	28942
12/15/15 3:35 AM	24408	24408	12/23/15 9:55 PM	22817	28667

Hourly Average Flows Exceeding 20-Year (22,100 cfs) and 100-Year (25,500 cfs) Recurrence Intervals

Date and Time	Flows Exceeding Recurrence Intervals		Flows Exceeding Recurrence Intervals		Flows Exceeding Recurrence Intervals		
	20-Year (cfs)	100-Year (cfs)	Date and Time	20-Year (cfs)	100-Year (cfs)	Date and Time	
12/24/15 11:45 AM	28117	28117	12/27/15 10:50 AM	22258	22238	3/16/16 11:15 AM	22233
12/24/15 11:50 AM	27408	27408	1/4/16 4:40 AM	23059	23059	3/16/16 1:00 PM	22633
12/24/15 11:55 AM	26733	26733	1/4/16 4:45 AM	25167	25167	3/16/16 1:05 PM	23167
12/24/15 12:00 PM	25633	25633	1/4/16 4:50 AM	26350	26350	3/16/16 1:10 PM	23625
12/24/15 12:05 PM	24733	24733	1/4/16 4:55 AM	27175	27175	3/16/16 1:15 PM	23958
12/24/15 12:10 PM	23733	23733	1/4/16 5:00 AM	27600	27600	3/16/16 1:20 PM	24108
12/24/15 12:15 PM	22717	22717	1/4/16 5:05 AM	27675	27675	3/16/16 1:25 PM	24250
12/24/15 4:10 PM	23050	23050	1/4/16 5:10 AM	27317	27317	3/16/16 1:30 PM	24183
12/24/15 4:15 PM	23517	23517	1/4/16 5:15 AM	26942	26942	3/16/16 1:35 PM	23933
12/24/15 4:20 PM	24008	24008	1/4/16 5:20 AM	26250	26250	3/16/16 1:40 PM	23442
12/24/15 4:25 PM	24450	24450	1/4/16 5:25 AM	25392	25392	3/16/16 1:45 PM	22958
12/24/15 4:30 PM	24467	24467	1/4/16 5:30 AM	24417	24417	3/16/16 1:50 PM	22242
12/24/15 4:35 PM	24383	24383	1/4/16 5:35 AM	23483	23483	3/16/16 4:00 PM	22192
12/24/15 4:40 PM	23900	23900	1/4/16 5:40 AM	22625	22625	3/16/16 4:05 PM	22467
12/24/15 4:45 PM	23525	23525	2/29/16 1:20 PM	22150	22150	3/16/16 4:10 PM	22533
12/24/15 4:50 PM	22792	22792	2/29/16 1:25 PM	22383	22383	3/16/16 4:15 PM	22392
12/24/15 4:55 PM	22142	22142	2/29/16 1:30 PM	22533	22533	3/16/16 4:20 PM	22242
12/25/15 2:20 AM	22950	22950	2/29/16 1:35 PM	22425	22425	3/17/16 7:50 AM	22358
12/25/15 2:25 AM	23633	23633	2/29/16 1:40 PM	22192	22192	3/17/16 7:55 AM	22475
12/25/15 2:30 AM	24192	24192	3/1/16 10:05 AM	22283	22283	3/17/16 8:00 AM	22442
12/25/15 2:35 AM	24325	24325	3/1/16 10:10 AM	22483	22483	3/17/16 8:05 AM	22367
12/25/15 2:40 AM	24567	24567	3/1/16 10:15 AM	22675	22675	3/17/16 8:10 AM	22183
12/25/15 2:45 AM	24717	24717	3/1/16 10:20 AM	22575	22575	3/17/16 8:15 AM	22150
12/25/15 2:50 AM	24825	24825	3/1/16 10:25 AM	22417	22417	3/20/16 11:00 PM	22727
12/25/15 2:55 AM	24575	24575	3/1/16 10:30 AM	22258	22258	3/20/16 11:05 PM	24575
12/25/15 3:00 AM	24125	24125	3/1/16 10:35 AM	22142	22142	3/20/16 11:10 PM	26267
12/25/15 3:05 AM	23808	23808	3/16/16 9:40 AM	22475	22475	3/20/16 11:15 PM	27583
12/25/15 3:10 AM	23500	23500	3/16/16 9:45 AM	24008	24008	3/20/16 11:20 PM	28333
12/25/15 3:15 AM	22983	22983	3/16/16 9:50 AM	25567	25567	3/20/16 11:25 PM	29058
12/25/15 3:20 AM	22458	22458	3/16/16 9:55 AM	26883	26883	3/20/16 11:30 PM	29558
12/25/15 3:25 AM	22150	22150	3/16/16 10:00 AM	27817	27817	3/20/16 11:35 PM	29700
12/25/15 12:45 PM	22367	22367	3/16/16 10:05 AM	28608	28608	3/20/16 11:40 PM	29233
12/25/15 12:50 PM	22692	22692	3/16/16 10:10 AM	29175	29175	3/20/16 11:45 PM	28767
12/25/15 12:55 PM	23050	23050	3/16/16 10:15 AM	29650	29650	3/20/16 11:50 PM	28075
12/25/15 1:00 PM	23208	23208	3/16/16 10:20 AM	29508	29508	3/20/16 11:55 PM	27242
12/25/15 1:05 PM	23333	23333	3/16/16 10:25 AM	29442	29442	3/21/16 12:00 AM	26042
12/25/15 1:10 PM	23242	23242	3/16/16 10:30 AM	29350	29350	3/21/16 12:05 AM	24975
12/25/15 1:15 PM	23050	23050	3/16/16 10:35 AM	28742	28742	3/21/16 12:10 AM	23725
12/25/15 1:20 PM	22800	22800	3/16/16 10:40 AM	28025	28025	3/21/16 12:15 AM	22650
12/25/15 1:25 PM	22542	22542	3/16/16 10:45 AM	27417	27417	3/24/16 4:10 PM	22850
12/25/15 1:30 PM	22192	22192	3/16/16 10:50 AM	26650	26650	3/24/16 4:15 PM	23633
12/27/15 10:30 AM	22208	22208	3/16/16 10:55 AM	25908	25908	3/24/16 4:20 PM	24275
12/27/15 10:35 AM	22250	22250	3/16/16 11:00 AM	25058	25058	3/24/16 4:25 PM	24650
12/27/15 10:40 AM	22417	22417	3/16/16 11:05 AM	24125	24125	3/24/16 4:30 PM	25208
12/27/15 10:45 AM	22450	22450	3/16/16 11:10 AM	23233	23233	3/24/16 4:35 PM	25508

Hourly Average Flows Exceeding 20-Year (22,100 cfs) and 100-Year (25,500 cfs) Recurrence Intervals

Date and Time	Flows Exceeding Recurrence Intervals		Flows Exceeding Recurrence Intervals		Flows Exceeding Recurrence Intervals		
	20-Year (cfs)	100-Year (cfs)	Date and Time	20-Year (cfs)	100-Year (cfs)	20-Year (cfs)	100-Year (cfs)
3/24/16 4:40 PM	25650	25650	3/28/16 4:05 PM	24542	24542	3/31/16 8:35 PM	23317
3/24/16 4:45 PM	25817	25817	3/28/16 4:10 PM	23700	23700	3/31/16 8:40 PM	23100
3/24/16 4:50 PM	25875	25875	3/28/16 4:15 PM	23025	23025	3/31/16 8:45 PM	22583
3/24/16 4:55 PM	25900	25900	3/28/16 4:20 PM	22108	22108	3/31/16 8:50 PM	22250
3/24/16 5:00 PM	25642	25642	3/31/16 1:40 PM	22325	22325	3/31/16 10:10 PM	22600
3/24/16 5:05 PM	25458	25458	3/31/16 1:45 PM	23025	23025	3/31/16 10:15 PM	23067
3/24/16 5:10 PM	25275	25275	3/31/16 1:50 PM	23300	23300	3/31/16 10:20 PM	23508
3/24/16 5:15 PM	24825	24825	3/31/16 1:55 PM	23708	23708	3/31/16 10:25 PM	23625
3/24/16 5:20 PM	24383	24383	3/31/16 2:00 PM	23892	23892	3/31/16 10:30 PM	23433
3/24/16 5:25 PM	24025	24025	3/31/16 2:05 PM	24075	24075	3/31/16 10:35 PM	23300
3/24/16 5:30 PM	23350	23350	3/31/16 2:10 PM	24067	24067	3/31/16 10:40 PM	22908
3/24/16 5:35 PM	22917	22917	3/31/16 2:15 PM	24008	24008	3/31/16 10:45 PM	22250
3/24/16 5:40 PM	22358	22358	3/31/16 2:20 PM	23808	23808	4/1/16 12:35 AM	22175
3/24/16 5:45 PM	22475	22475	3/31/16 2:25 PM	23508	23508	4/1/16 12:40 AM	23517
3/24/16 5:50 PM	22917	22917	3/31/16 2:30 PM	23400	23400	4/1/16 12:45 AM	24567
3/24/16 5:55 PM	23183	23183	3/31/16 2:35 PM	23092	23092	4/1/16 12:50 AM	25458
3/24/16 10:00 PM	23058	23058	3/31/16 2:40 PM	22858	22858	4/1/16 12:55 AM	26033
3/24/16 10:05 PM	22725	22725	3/31/16 2:45 PM	22583	22583	4/1/16 1:00 AM	26517
3/24/16 10:10 PM	22325	22325	3/31/16 2:50 PM	22442	22442	4/1/16 1:05 AM	26825
3/28/16 12:50 AM	22492	22492	3/31/16 2:55 PM	22308	22308	4/1/16 1:10 AM	27150
3/28/16 12:55 AM	22767	22767	3/31/16 3:00 PM	22292	22292	4/1/16 1:15 AM	26967
3/28/16 1:00 AM	22950	22950	3/31/16 3:05 PM	22333	22333	4/1/16 1:20 AM	26733
3/28/16 1:05 AM	23275	23275	3/31/16 3:10 PM	22200	22200	4/1/16 1:25 AM	26375
3/28/16 1:10 AM	23383	23383	3/31/16 3:15 PM	22400	22400	4/1/16 1:30 AM	26117
3/28/16 1:15 AM	23542	23542	3/31/16 3:20 PM	22458	22458	4/1/16 1:35 AM	25808
3/28/16 1:20 AM	23567	23567	3/31/16 3:25 PM	22667	22667	4/1/16 1:40 AM	25333
3/28/16 1:25 AM	23600	23600	3/31/16 3:30 PM	22825	22825	4/1/16 1:45 AM	24933
3/28/16 1:30 AM	23250	23250	3/31/16 3:35 PM	23042	23042	4/1/16 1:50 AM	24208
3/28/16 1:35 AM	23150	23150	3/31/16 3:40 PM	23325	23325	4/1/16 1:55 AM	23883
3/28/16 1:40 AM	22817	22817	3/31/16 3:45 PM	23358	23358	4/1/16 2:00 AM	23483
3/28/16 1:45 AM	22358	22358	3/31/16 3:50 PM	23317	23317	4/1/16 2:05 AM	23008
3/28/16 2:55 PM	22725	22725	3/31/16 3:55 PM	23242	23242	4/1/16 2:10 AM	22550
3/28/16 3:00 PM	23625	23625	3/31/16 4:00 PM	23167	23167	4/1/16 2:15 AM	22308
3/28/16 3:05 PM	24450	24450	3/31/16 4:05 PM	22767	22767	4/1/16 10:55 AM	22267
3/28/16 3:10 PM	25158	25158	3/31/16 4:10 PM	22675	22675	4/1/16 11:00 AM	22317
3/28/16 3:15 PM	25642	25642	3/31/16 4:15 PM	22350	22350	4/1/16 11:05 AM	22383
3/28/16 3:20 PM	26067	26067	3/31/16 7:50 PM	22125	22125	4/1/16 11:10 AM	22417
3/28/16 3:25 PM	26408	26408	3/31/16 7:55 PM	22358	22358	4/1/16 11:15 AM	22342
3/28/16 3:30 PM	26642	26642	3/31/16 8:00 PM	22650	22650	4/1/16 11:20 AM	22208
3/28/16 3:35 PM	26700	26700	3/31/16 8:05 PM	22875	22875	4/1/16 11:25 AM	22275
3/28/16 3:40 PM	26575	26575	3/31/16 8:10 PM	23083	23083	4/1/16 11:30 AM	22117
3/28/16 3:45 PM	26292	26292	3/31/16 8:15 PM	23300	23300	4/1/16 6:10 PM	23100
3/28/16 3:50 PM	26108	26108	3/31/16 8:20 PM	23567	23567	4/1/16 6:15 PM	23942
3/28/16 3:55 PM	25667	25667	3/31/16 8:25 PM	23650	23650	4/1/16 6:20 PM	24675
3/28/16 4:00 PM	25125	25125	3/31/16 8:30 PM	23583	23583	4/1/16 6:25 PM	25158

Hourly Average Flows Exceeding 20-Year (22,100 cfs) and 100-Year (25,500 cfs) Recurrence Intervals

Date and Time	Flows Exceeding Recurrence Intervals		Flows Exceeding Recurrence Intervals		Flows Exceeding Recurrence Intervals			
	20-Year (cfs)	100-Year (cfs)	Date and Time	20-Year (cfs)	100-Year (cfs)	Date and Time	20-Year (cfs)	100-Year (cfs)
4/1/16 6:30 PM	25733	25733	4/2/16 4:40 PM	24858	24858	4/3/16 4:00 AM	24008	24008
4/1/16 6:35 PM	26058	26058	4/2/16 4:45 PM	24333	24333	4/3/16 4:05 AM	23658	23658
4/1/16 6:40 PM	26117	26117	4/2/16 4:50 PM	23667	23667	4/3/16 4:10 AM	23158	23158
4/1/16 6:45 PM	25950	25950	4/2/16 4:55 PM	23125	23125	4/3/16 4:15 AM	22792	22792
4/1/16 6:50 PM	25958	25958	4/2/16 5:00 PM	22750	22750	4/3/16 4:20 AM	22117	22117
4/1/16 6:55 PM	25725	25725	4/2/16 5:05 PM	22442	22442	4/3/16 7:20 PM	24073	24073
4/1/16 7:00 PM	25483	25483	4/2/16 5:10 PM	22417	22417	4/3/16 7:25 PM	25967	25967
4/1/16 7:05 PM	25200	25200	4/2/16 5:15 PM	22367	22367	4/3/16 7:30 PM	27692	27692
4/1/16 7:10 PM	24758	24758	4/2/16 5:20 PM	22708	22708	4/3/16 7:35 PM	29058	29058
4/1/16 7:15 PM	24450	24450	4/2/16 5:25 PM	22875	22875	4/3/16 7:40 PM	29933	29933
4/1/16 7:20 PM	24042	24042	4/2/16 5:30 PM	22858	22858	4/3/16 7:45 PM	30475	30475
4/1/16 7:25 PM	23742	23742	4/2/16 5:35 PM	23017	23017	4/3/16 7:50 PM	30700	30700
4/1/16 7:30 PM	23200	23200	4/2/16 5:40 PM	23275	23275	4/3/16 7:55 PM	30658	30658
4/1/16 7:35 PM	22850	22850	4/2/16 5:45 PM	23408	23408	4/3/16 8:00 PM	30400	30400
4/1/16 7:40 PM	22783	22783	4/2/16 5:50 PM	23675	23675	4/3/16 8:05 PM	29783	29783
4/1/16 7:45 PM	22617	22617	4/2/16 5:55 PM	23783	23783	4/3/16 8:10 PM	29000	29000
4/1/16 7:50 PM	22367	22367	4/2/16 6:00 PM	23900	23900	4/3/16 8:15 PM	28100	28100
4/1/16 7:55 PM	22358	22358	4/2/16 6:05 PM	23875	23875	4/3/16 8:20 PM	27267	27267
4/2/16 5:45 AM	22533	22533	4/2/16 6:10 PM	23808	23808	4/3/16 8:25 PM	26367	26367
4/2/16 5:50 AM	23042	23042	4/2/16 6:15 PM	23800	23800	4/3/16 8:30 PM	25117	25117
4/2/16 5:55 AM	23717	23717	4/2/16 6:20 PM	23608	23608	4/3/16 8:35 PM	23958	23958
4/2/16 6:00 AM	24067	24067	4/2/16 6:25 PM	23342	23342	4/3/16 8:40 PM	23050	23050
4/2/16 6:05 AM	24408	24408	4/2/16 6:30 PM	23108	23108	4/4/16 9:50 PM	22167	22167
4/2/16 6:10 AM	24667	24667	4/2/16 6:35 PM	22925	22925	4/4/16 9:55 PM	22267	22267
4/2/16 6:15 AM	24775	24775	4/2/16 6:40 PM	22675	22675	4/4/16 10:00 PM	22325	22325
4/2/16 6:20 AM	24775	24775	4/2/16 6:45 PM	22425	22425	4/4/16 10:05 PM	22233	22233
4/2/16 6:25 AM	24542	24542	4/2/16 6:50 PM	22125	22125	4/4/16 10:10 PM	22117	22117
4/2/16 6:30 AM	24275	24275	4/3/16 2:30 AM	22200	22200	4/6/16 9:50 PM	22108	22108
4/2/16 6:35 AM	23725	23725	4/3/16 2:35 AM	22650	22650	4/6/16 9:55 PM	22592	22592
4/2/16 6:40 AM	23525	23525	4/3/16 2:40 AM	23008	23008	4/6/16 10:00 PM	22858	22858
4/2/16 6:45 AM	22808	22808	4/3/16 2:45 AM	23400	23400	4/6/16 10:05 PM	23075	23075
4/2/16 6:50 AM	22192	22192	4/3/16 2:50 AM	23892	23892	4/6/16 10:10 PM	23300	23300
4/2/16 3:35 PM	22731	22731	4/3/16 2:55 AM	24383	24383	4/6/16 10:15 PM	23492	23492
4/2/16 3:40 PM	24775	24775	4/3/16 3:00 AM	24592	24592	4/6/16 10:20 PM	23575	23575
4/2/16 3:45 PM	26150	26150	4/3/16 3:05 AM	24983	24983	4/6/16 10:25 PM	23525	23525
4/2/16 3:50 PM	27492	27492	4/3/16 3:10 AM	25108	25108	4/6/16 10:30 PM	23433	23433
4/2/16 3:55 PM	28225	28225	4/3/16 3:15 AM	25108	25108	4/6/16 10:35 PM	23408	23408
4/2/16 4:00 PM	28642	28642	4/3/16 3:20 AM	25308	25308	4/6/16 10:40 PM	23183	23183
4/2/16 4:05 PM	28633	28633	4/3/16 3:25 AM	25333	25333	4/6/16 10:45 PM	23067	23067
4/2/16 4:10 PM	28308	28308	4/3/16 3:30 AM	25450	25450	4/6/16 10:50 PM	22792	22792
4/2/16 4:15 PM	28058	28058	4/3/16 3:35 AM	25325	25325	4/6/16 10:55 PM	22392	22392
4/2/16 4:20 PM	27317	27317	4/3/16 3:40 AM	25208	25208	4/6/16 11:00 PM	22183	22183
4/2/16 4:25 PM	26650	26650	4/3/16 3:45 AM	25017	25017	4/7/16 6:55 AM	22158	22158
4/2/16 4:30 PM	26117	26117	4/3/16 3:50 AM	24750	24750	4/7/16 7:00 AM	22158	22158
4/2/16 4:35 PM	25442	25442	4/3/16 3:55 AM	24433	24433	4/8/16 6:45 PM	22200	22200

Hourly Average Flows Exceeding 20-Year (22,100 cfs) and 100-Year (25,500 cfs) Recurrence Intervals

Date and Time	Flows Exceeding Recurrence Intervals		Date and Time	Flows Exceeding Recurrence Intervals		Date and Time	Flows Exceeding Recurrence Intervals	
	20-Year (cfs)	100-Year (cfs)		20-Year (cfs)	100-Year (cfs)		20-Year (cfs)	100-Year (cfs)
4/8/16 6:50 PM	23267	26067	4/9/16 7:25 PM	22575	25886	9/10/16 11:00 PM	22508	28667
4/8/16 6:55 PM	24000	26642	4/9/16 7:30 PM	22325	28302	9/22/16 7:05 AM	22625	28550
4/8/16 7:00 PM	24333	26950	4/9/16 7:35 PM	22175	29925	9/22/16 7:10 AM	23242	27975
4/8/16 7:05 PM	24200	27250	4/13/16 9:55 AM	22325	30558	9/22/16 7:15 AM	23250	26975
4/8/16 7:10 PM	23850	27442	4/13/16 10:00 AM	22450	30750	9/22/16 7:20 AM	22700	25633
4/8/16 7:15 PM	23242	27400	4/13/16 10:05 AM	22608	29942	9/22/16 1:00 PM	22133	24225
4/8/16 7:20 PM	22750	27250	4/13/16 10:10 AM	22633	29217	9/22/16 10:00 PM	23408	22483
4/8/16 10:00 PM	22308	26067	4/13/16 10:15 AM	22675	25886	9/22/16 10:05 PM	25550	27617
4/8/16 10:05 PM	23150	26642	4/13/16 10:20 AM	22550	28302	9/22/16 10:10 PM	26925	25800
4/8/16 10:10 PM	24083	27250	4/13/16 10:25 AM	22192	29925	9/22/16 10:15 PM	28033	23488
4/8/16 10:15 PM	24775	27442	6/10/16 8:30 PM	22915	30558	9/22/16 10:20 PM	28567	22367
4/8/16 10:20 PM	25458	27400	6/10/16 8:35 PM	25886	30750	9/22/16 10:25 PM	28667	23150
4/8/16 10:25 PM	26067	27250	6/10/16 8:40 PM	28302	29942	9/22/16 10:30 PM	28550	23258
4/8/16 10:30 PM	26642	26067	6/10/16 8:45 PM	29925	29217	9/22/16 10:35 PM	27975	23167
4/8/16 10:35 PM	26950	26642	6/10/16 8:50 PM	30558	25886	9/22/16 10:40 PM	26975	25442
4/8/16 10:40 PM	27250	26950	6/10/16 8:55 PM	30750	25442	9/22/16 10:45 PM	25633	25333
4/8/16 10:45 PM	27442	27400	6/10/16 9:00 PM	29942	24700	9/22/16 10:50 PM	24225	24700
4/8/16 10:50 PM	27400	27250	6/10/16 9:05 PM	29217	23700	9/22/16 10:55 PM	22700	23700
4/8/16 10:55 PM	27250	27025	6/10/16 9:10 PM	27617	22542	9/22/16 10:55 PM	22925	22892
4/8/16 11:00 PM	27025	26708	6/10/16 9:15 PM	25800	23067	9/22/16 10:55 PM	22925	23067
4/8/16 11:05 PM	26708	26708	6/10/16 9:20 PM	23488	23033	9/22/16 10:55 PM	22742	23033
4/8/16 11:10 PM	26075	26075	6/26/16 4:30 AM	22367	22792	9/22/16 10:55 PM	22792	22792
4/8/16 11:15 PM	25692	26075	6/26/16 4:35 AM	23150	22333	9/22/16 10:55 PM	22333	22333
4/8/16 11:20 PM	25042	25692	6/26/16 4:40 AM	23258	22333	9/22/16 10:55 PM	22333	22333
4/8/16 11:25 PM	24400	25042	6/26/16 4:45 AM	23167	22633	9/22/16 10:55 PM	22633	22633
4/8/16 11:30 PM	23917	24400	6/26/16 4:50 AM	22808	22900	9/22/16 10:55 PM	22900	22900
4/8/16 11:35 PM	23275	23917	6/26/16 4:55 AM	22108	22792	9/22/16 10:55 PM	22792	22792
4/8/16 11:40 PM	22625	23275	7/6/16 10:25 PM	23922	22692	9/22/16 10:55 PM	22692	22692
4/9/16 9:40 AM	22267	22625	7/6/16 10:30 PM	24933	22625	9/22/16 10:55 PM	22625	22625
4/9/16 9:45 AM	22442	22267	7/6/16 10:35 PM	25442	22625	9/22/16 10:55 PM	22625	22625
4/9/16 9:50 AM	22558	22442	7/6/16 10:40 PM	25333	22625	9/22/16 10:55 PM	22625	22625
4/9/16 9:55 AM	22617	22558	7/6/16 10:45 PM	24700	22625	9/22/16 10:55 PM	22625	22625
4/9/16 10:00 AM	22667	22617	7/6/16 10:50 PM	23700	22625	9/22/16 10:55 PM	22625	22625
4/9/16 10:05 AM	22700	22667	7/6/16 10:55 PM	22242	22625	9/22/16 10:55 PM	22625	22625
4/9/16 10:10 AM	22567	22700	7/8/16 11:50 PM	22542	22625	9/22/16 10:55 PM	22625	22625
4/9/16 10:15 AM	22417	22567	7/8/16 11:55 PM	22892	22625	9/22/16 10:55 PM	22625	22625
4/9/16 10:20 AM	22125	22417	7/9/16 12:00 AM	23067	22625	9/22/16 10:55 PM	22625	22625
4/9/16 6:45 PM	22350	22125	7/9/16 12:05 AM	23033	22625	9/22/16 10:55 PM	22625	22625
4/9/16 6:50 PM	22800	22350	7/9/16 12:10 AM	22792	22625	9/22/16 10:55 PM	22625	22625
4/9/16 6:55 PM	22925	22800	7/9/16 12:15 AM	22333	22625	9/22/16 10:55 PM	22625	22625
4/9/16 7:00 PM	22883	22925	9/10/16 10:35 PM	22333	22625	9/22/16 10:55 PM	22625	22625
4/9/16 7:05 PM	22900	22883	9/10/16 10:40 PM	22633	22625	9/22/16 10:55 PM	22625	22625
4/9/16 7:10 PM	22792	22900	9/10/16 10:45 PM	22900	22625	9/22/16 10:55 PM	22625	22625
4/9/16 7:15 PM	22692	22792	9/10/16 10:50 PM	22925	22625	9/22/16 10:55 PM	22625	22625
4/9/16 7:20 PM	22625	22692	9/10/16 10:55 PM	22742	22625	9/22/16 10:55 PM	22625	22625

Data from <http://waterdata.usgs.gov/nwis/> for the U.S. Oil Tank Depot (USGS gauging station 040851385).

cfs = cubic feet per second



USGS 040851385 FOX RIVER AT OIL TANK DEPOT AT GREEN BAY, WI

