

**OU4  
2013 DREDGE AREAS AND  
RESIDUAL DREDGE AREAS 1 OF 6**

**LEGEND**

- 2013 DREDGE AREA
- 2013 RESIDUAL DREDGE AREA
- 2013 DREDGE AREA
- 2012 DREDGE AREA
- DMU BOUNDARY
- DMU NUMBER

**SCALE (1" = 300')**



**SITE NOTES**


1. HORIZONTAL CONTROL IS REFERENCED TO THE NAD83 WISCONSIN STATE PLANE COORDINATE SYSTEM (WISCONSIN CENTRAL ZONE)
2. VERTICAL DATUM IS REFERENCED TO NAVD 88.
3. AREAS SHOWN REPRESENT THE DREDGE LIMITS DERIVED FROM THE DESIGN FILES FROM ANCHOR QEA.

THIS DOCUMENT IS THE PROPERTY OF LOWER FOX RIVER PRP GROUP PREPARED BY TETRA TECH EC, INC. (TTEC), AND IS PROVIDED UPON THE CONDITION THAT IT WILL NOT BE REPRODUCED, COPIED, OR ISSUED TO A THIRD PARTY. IT IS PROVIDED TO BE USED SOLELY FOR THE ORIGINAL INTENDED PURPOSE, AND SOLELY FOR THE EXECUTION OR REVIEW OF THE ENGINEERING AND CONSTRUCTION OF THE SUBJECT PROJECT.

**TETRA TECH EC, INC.**  
 1611 STATE STREET  
 GREEN BAY, WI 54304  
 TEL: (920) 445 - 0720 FAX: (920) 445 - 0719

CAD FILE: 2013 RA Summary.dwg  
 DRAWN BY: WALTER.BOWLES  
 DATE: January 9, 2014  
 LAST REVISED: January 23, 2014  
 CHECKED BY: RG



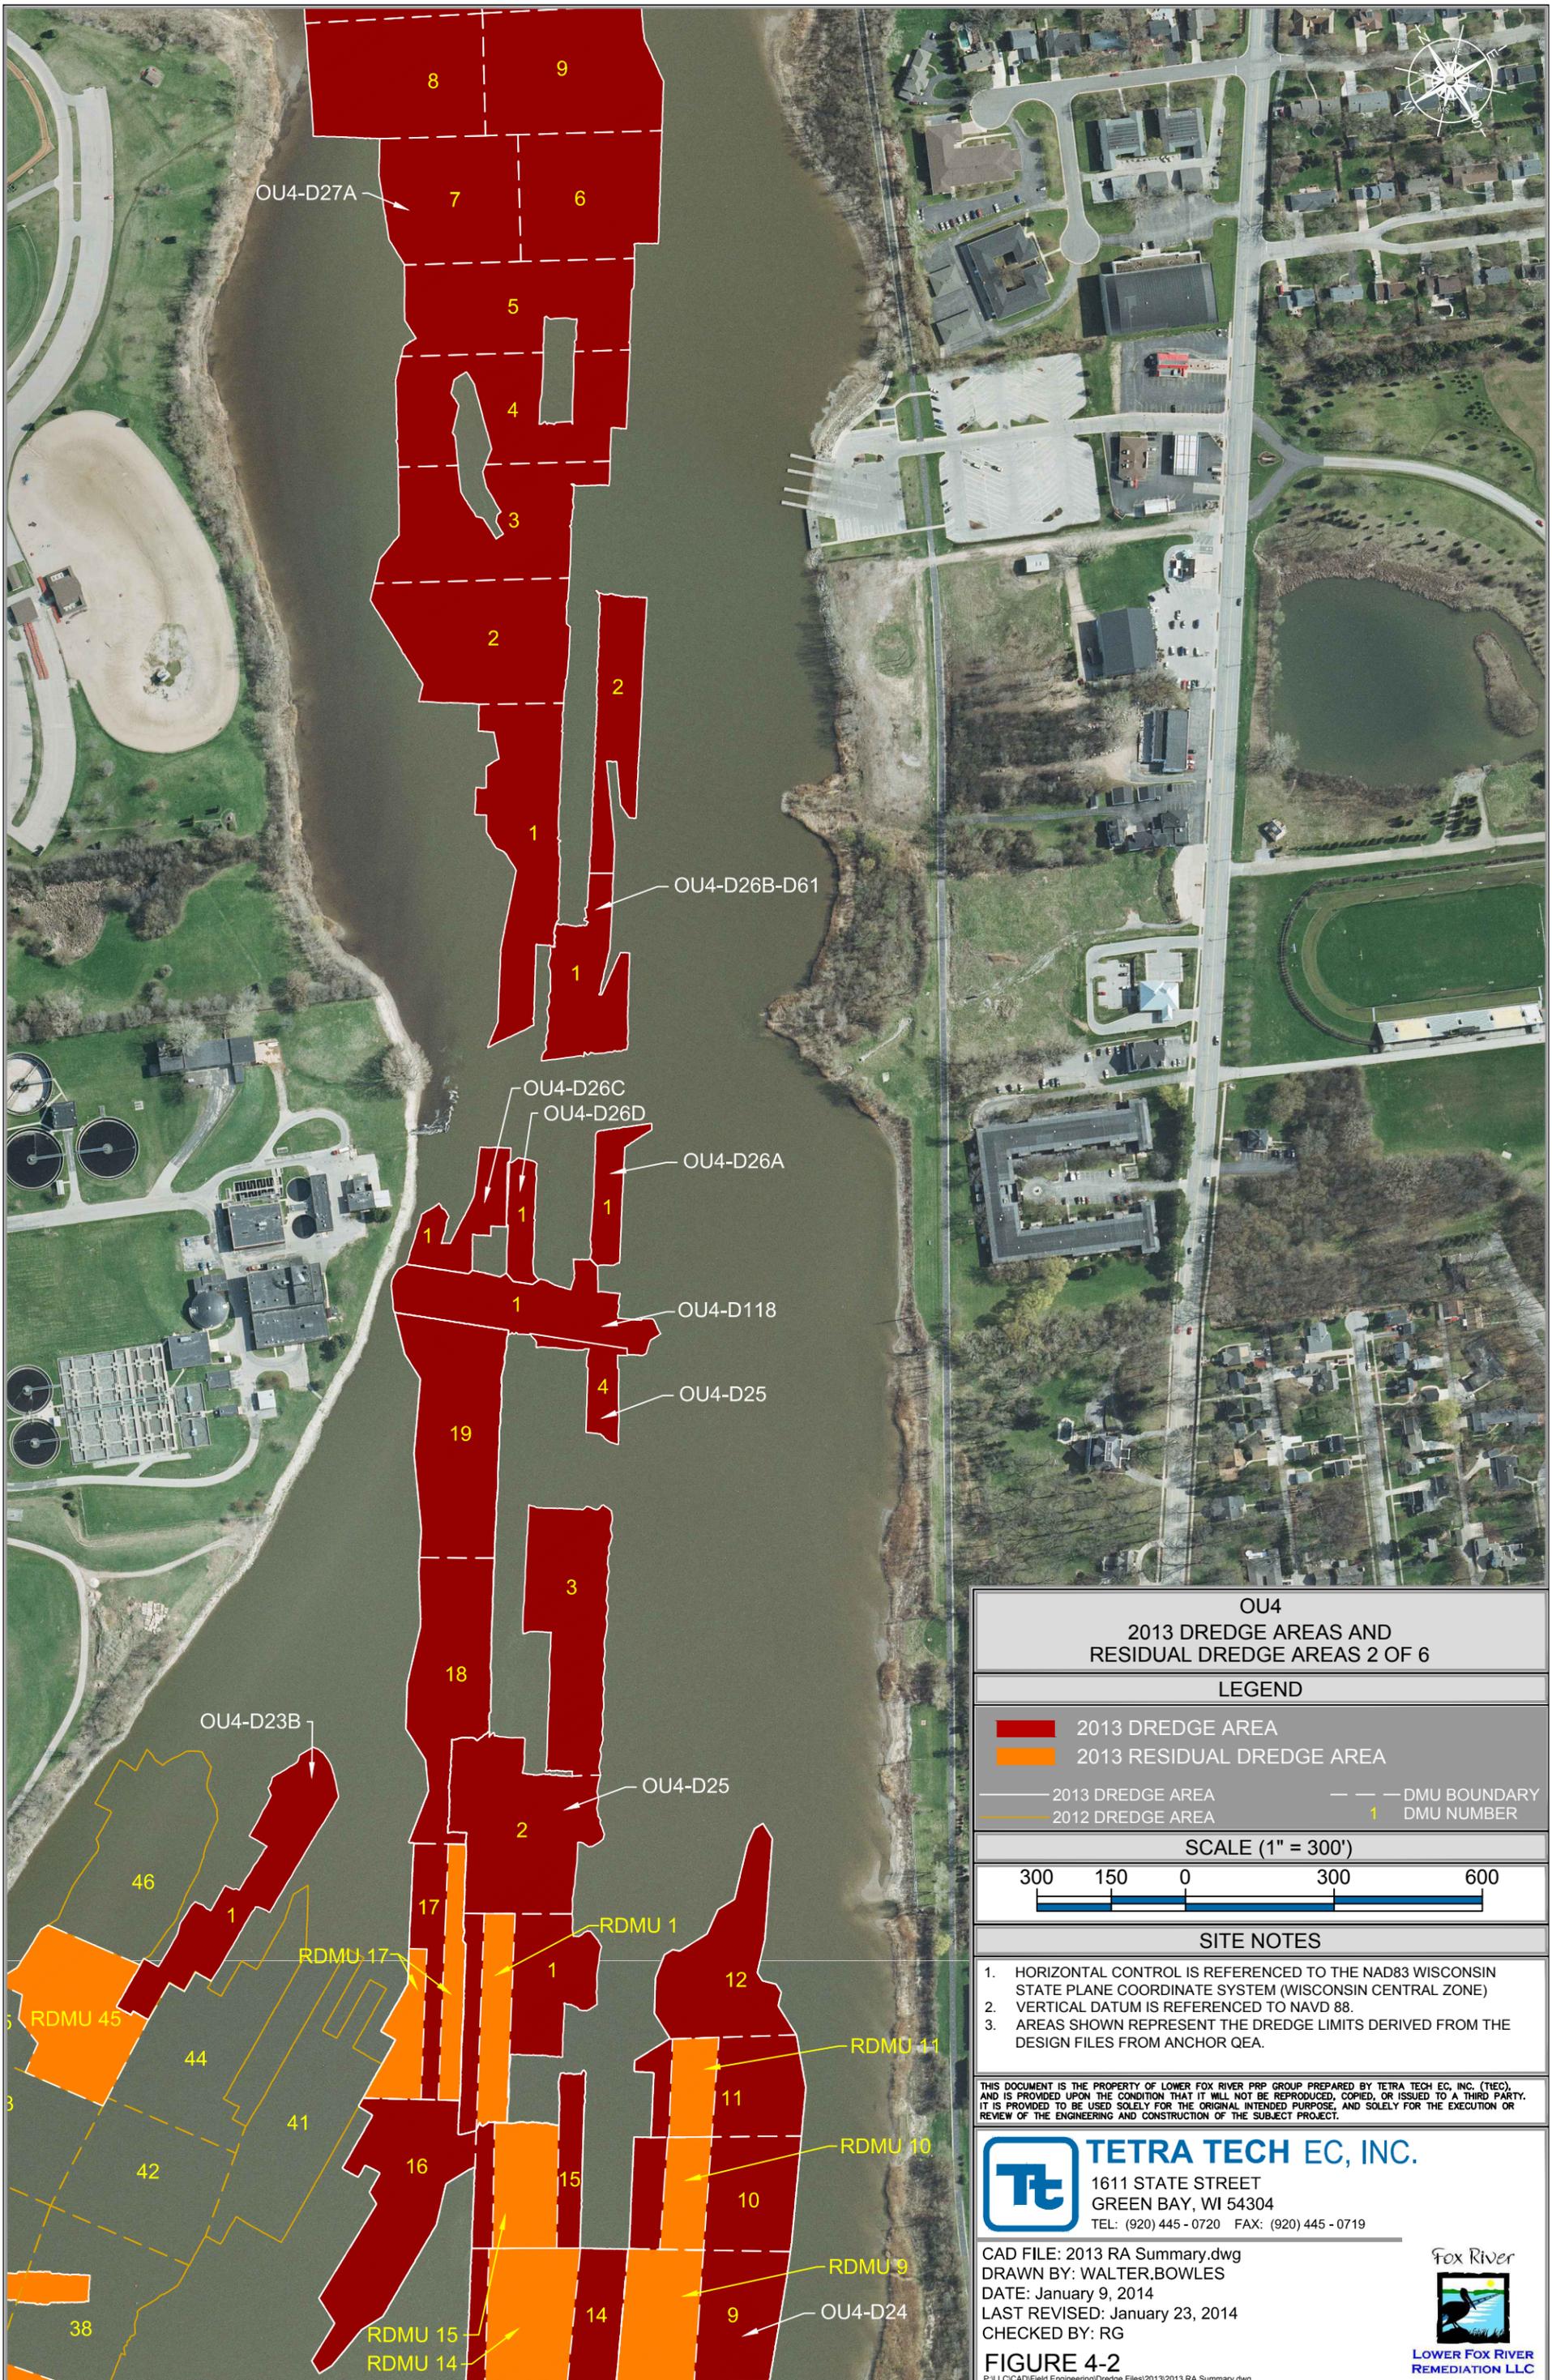

**OU4  
2013 DREDGE AREAS AND  
RESIDUAL DREDGE AREAS 2 OF 6**

**LEGEND**

<span style="display:inline-block; width:15px; height:10px; background-color:red; border:1px solid black;"></span>	2013 DREDGE AREA	<span style="display:inline-block; width:15px; height:10px; background-color:orange; border:1px solid black;"></span>	2013 RESIDUAL DREDGE AREA
<span style="display:inline-block; width:15px; border-bottom:1px dashed black;"></span>	2013 DREDGE AREA	<span style="display:inline-block; width:15px; border-bottom:1px dashed black;"></span>	DMU BOUNDARY
<span style="display:inline-block; width:15px; border-bottom:1px solid black;"></span>	2012 DREDGE AREA	<span style="display:inline-block; width:15px; text-align:center;">1</span>	DMU NUMBER

**SCALE (1" = 300')**



**SITE NOTES**


- HORIZONTAL CONTROL IS REFERENCED TO THE NAD83 WISCONSIN STATE PLANE COORDINATE SYSTEM (WISCONSIN CENTRAL ZONE)
- VERTICAL DATUM IS REFERENCED TO NAVD 88.
- AREAS SHOWN REPRESENT THE DREDGE LIMITS DERIVED FROM THE DESIGN FILES FROM ANCHOR QEA.

THIS DOCUMENT IS THE PROPERTY OF LOWER FOX RIVER PRP GROUP PREPARED BY TETRA TECH EC, INC. (TTEC), AND IS PROVIDED UPON THE CONDITION THAT IT WILL NOT BE REPRODUCED, COPIED, OR ISSUED TO A THIRD PARTY. IT IS PROVIDED TO BE USED SOLELY FOR THE ORIGINAL INTENDED PURPOSE, AND SOLELY FOR THE EXECUTION OR REVIEW OF THE ENGINEERING AND CONSTRUCTION OF THE SUBJECT PROJECT.

**TETRA TECH EC, INC.**  
 1611 STATE STREET  
 GREEN BAY, WI 54304  
 TEL: (920) 445 - 0720 FAX: (920) 445 - 0719

CAD FILE: 2013 RA Summary.dwg  
 DRAWN BY: WALTER.BOWLES  
 DATE: January 9, 2014  
 LAST REVISED: January 23, 2014  
 CHECKED BY: RG



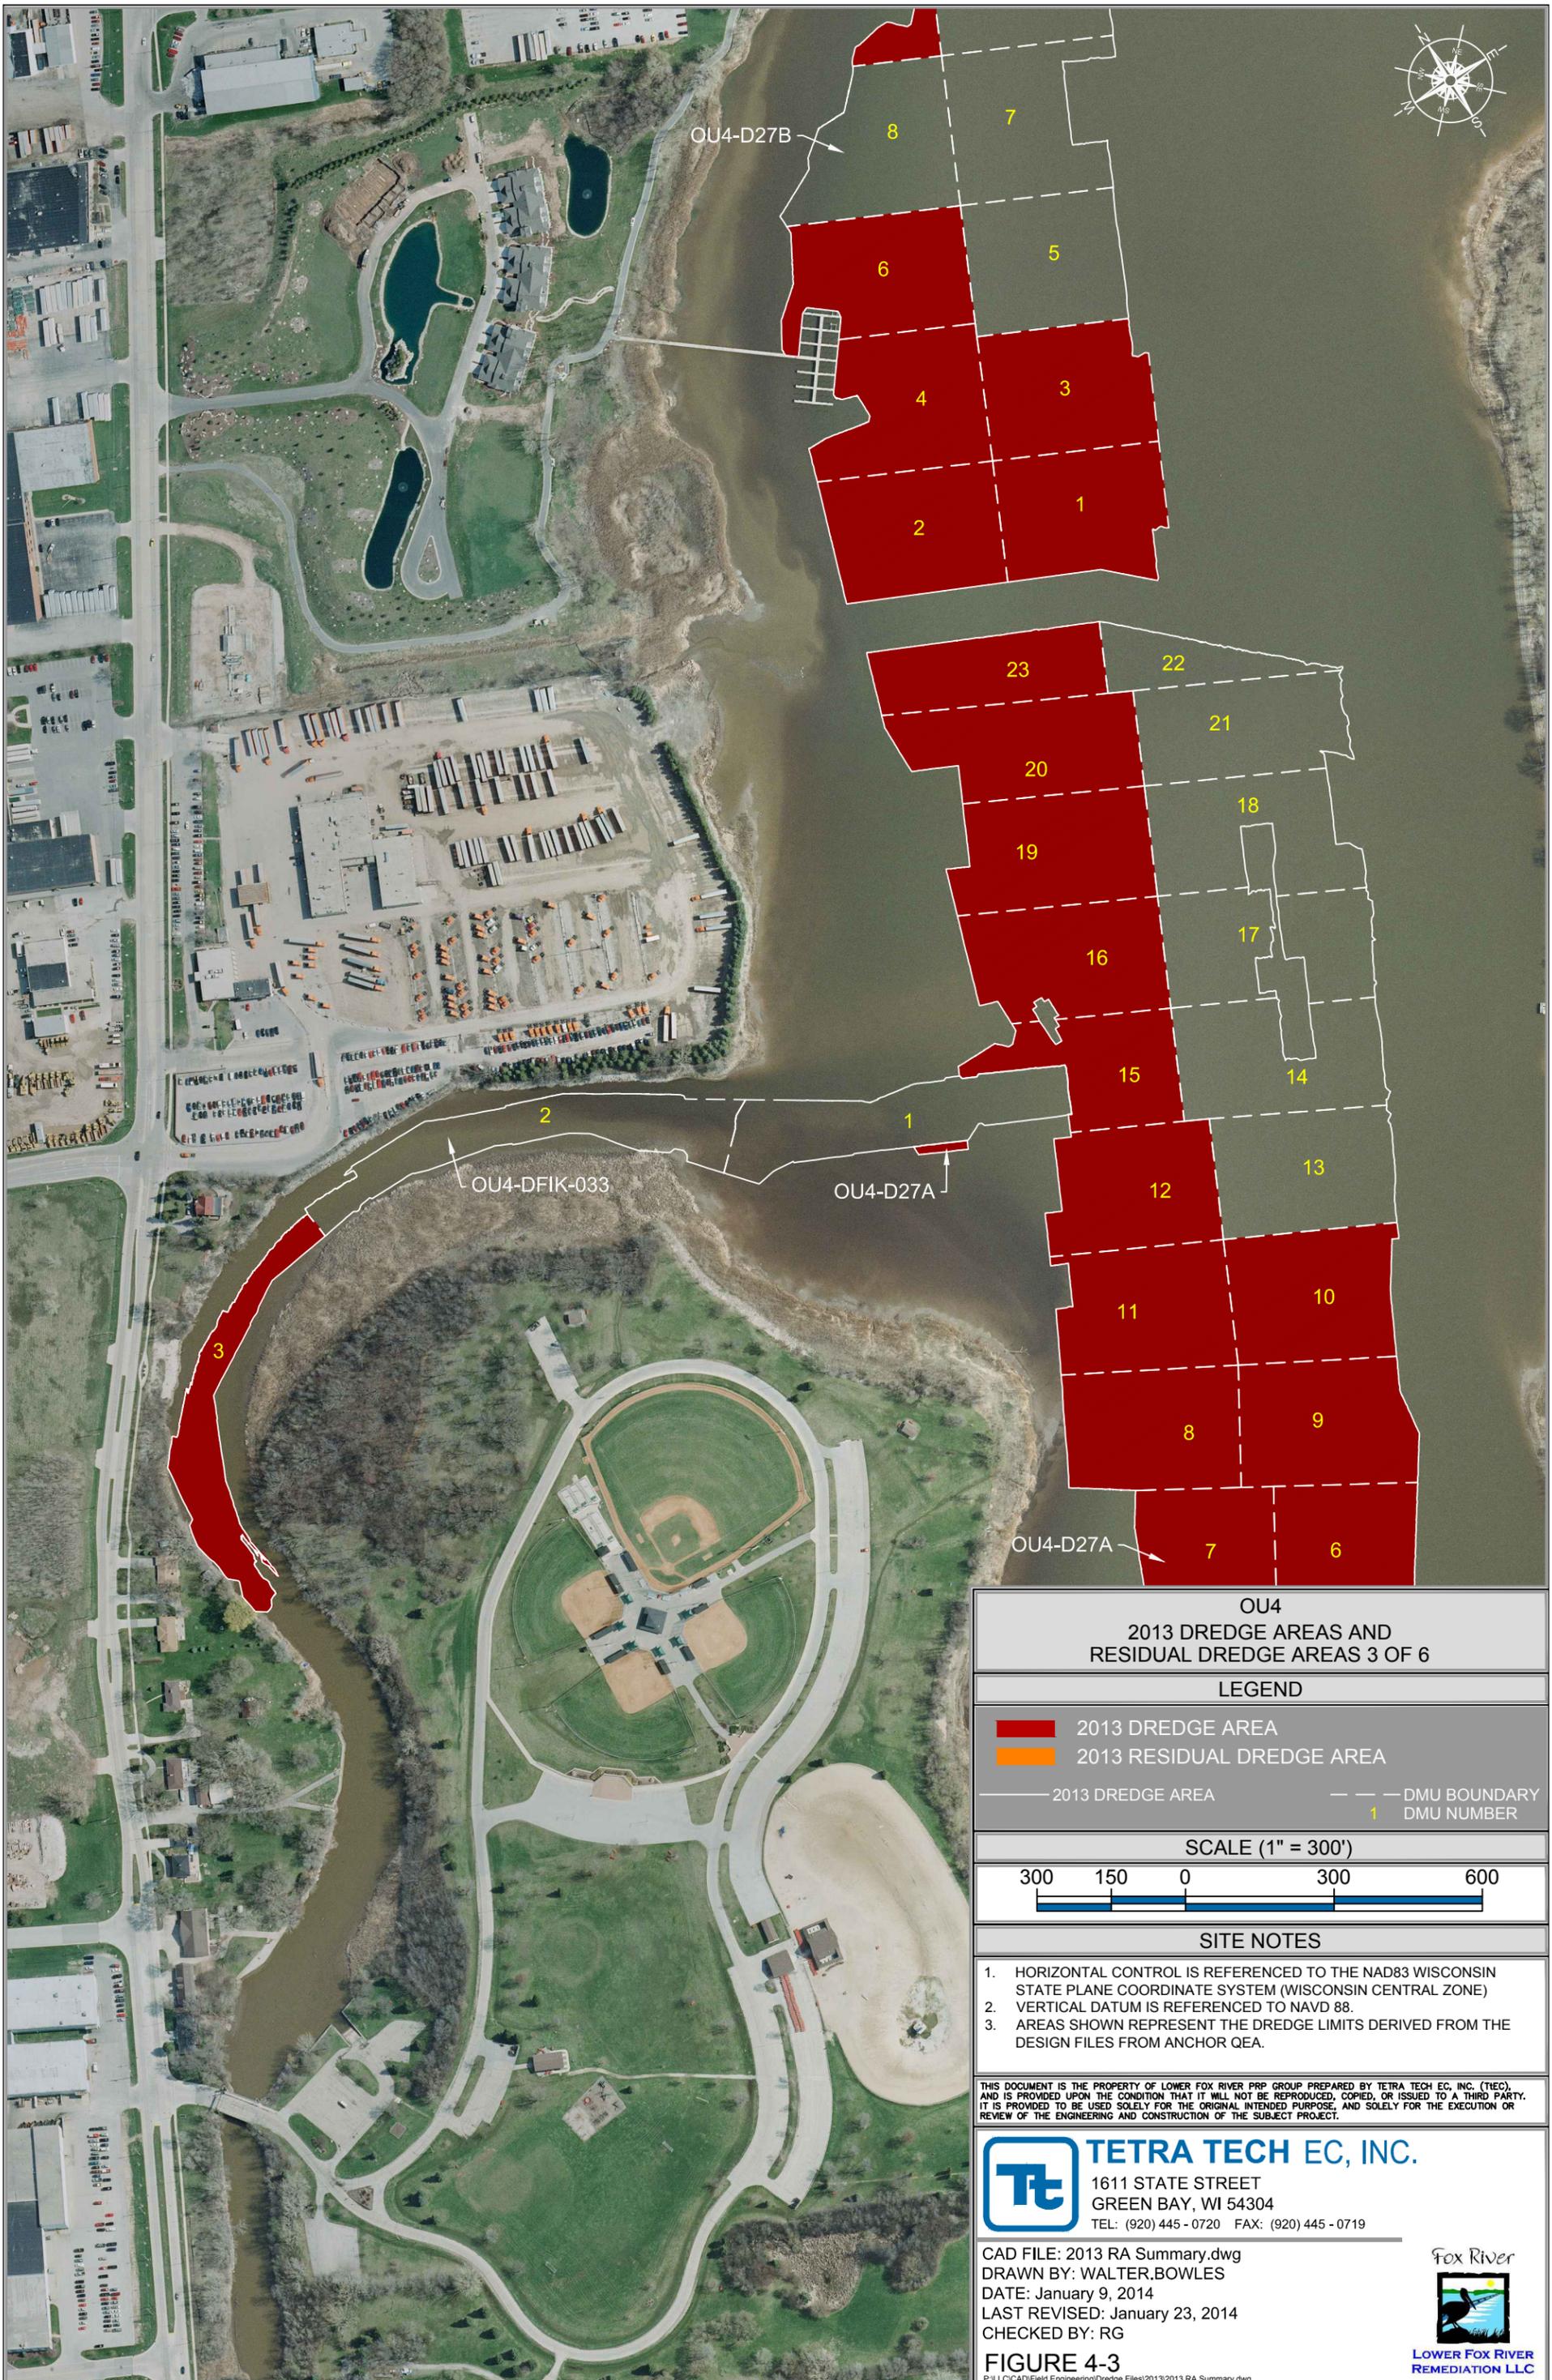

**OU4  
2013 DREDGE AREAS AND  
RESIDUAL DREDGE AREAS 3 OF 6**

**LEGEND**

- 2013 DREDGE AREA
- 2013 RESIDUAL DREDGE AREA
- 2013 DREDGE AREA
- DMU BOUNDARY
- DMU NUMBER

**SCALE (1" = 300')**



**SITE NOTES**


1. HORIZONTAL CONTROL IS REFERENCED TO THE NAD83 WISCONSIN STATE PLANE COORDINATE SYSTEM (WISCONSIN CENTRAL ZONE)
2. VERTICAL DATUM IS REFERENCED TO NAVD 88.
3. AREAS SHOWN REPRESENT THE DREDGE LIMITS DERIVED FROM THE DESIGN FILES FROM ANCHOR QEA.

THIS DOCUMENT IS THE PROPERTY OF LOWER FOX RIVER PRP GROUP PREPARED BY TETRA TECH EC, INC. (TTEC), AND IS PROVIDED UPON THE CONDITION THAT IT WILL NOT BE REPRODUCED, COPIED, OR ISSUED TO A THIRD PARTY. IT IS PROVIDED TO BE USED SOLELY FOR THE ORIGINAL INTENDED PURPOSE, AND SOLELY FOR THE EXECUTION OR REVIEW OF THE ENGINEERING AND CONSTRUCTION OF THE SUBJECT PROJECT.

**TETRA TECH EC, INC.**  
 1611 STATE STREET  
 GREEN BAY, WI 54304  
 TEL: (920) 445 - 0720 FAX: (920) 445 - 0719

CAD FILE: 2013 RA Summary.dwg  
 DRAWN BY: WALTER.BOWLES  
 DATE: January 9, 2014  
 LAST REVISED: January 23, 2014  
 CHECKED BY: RG



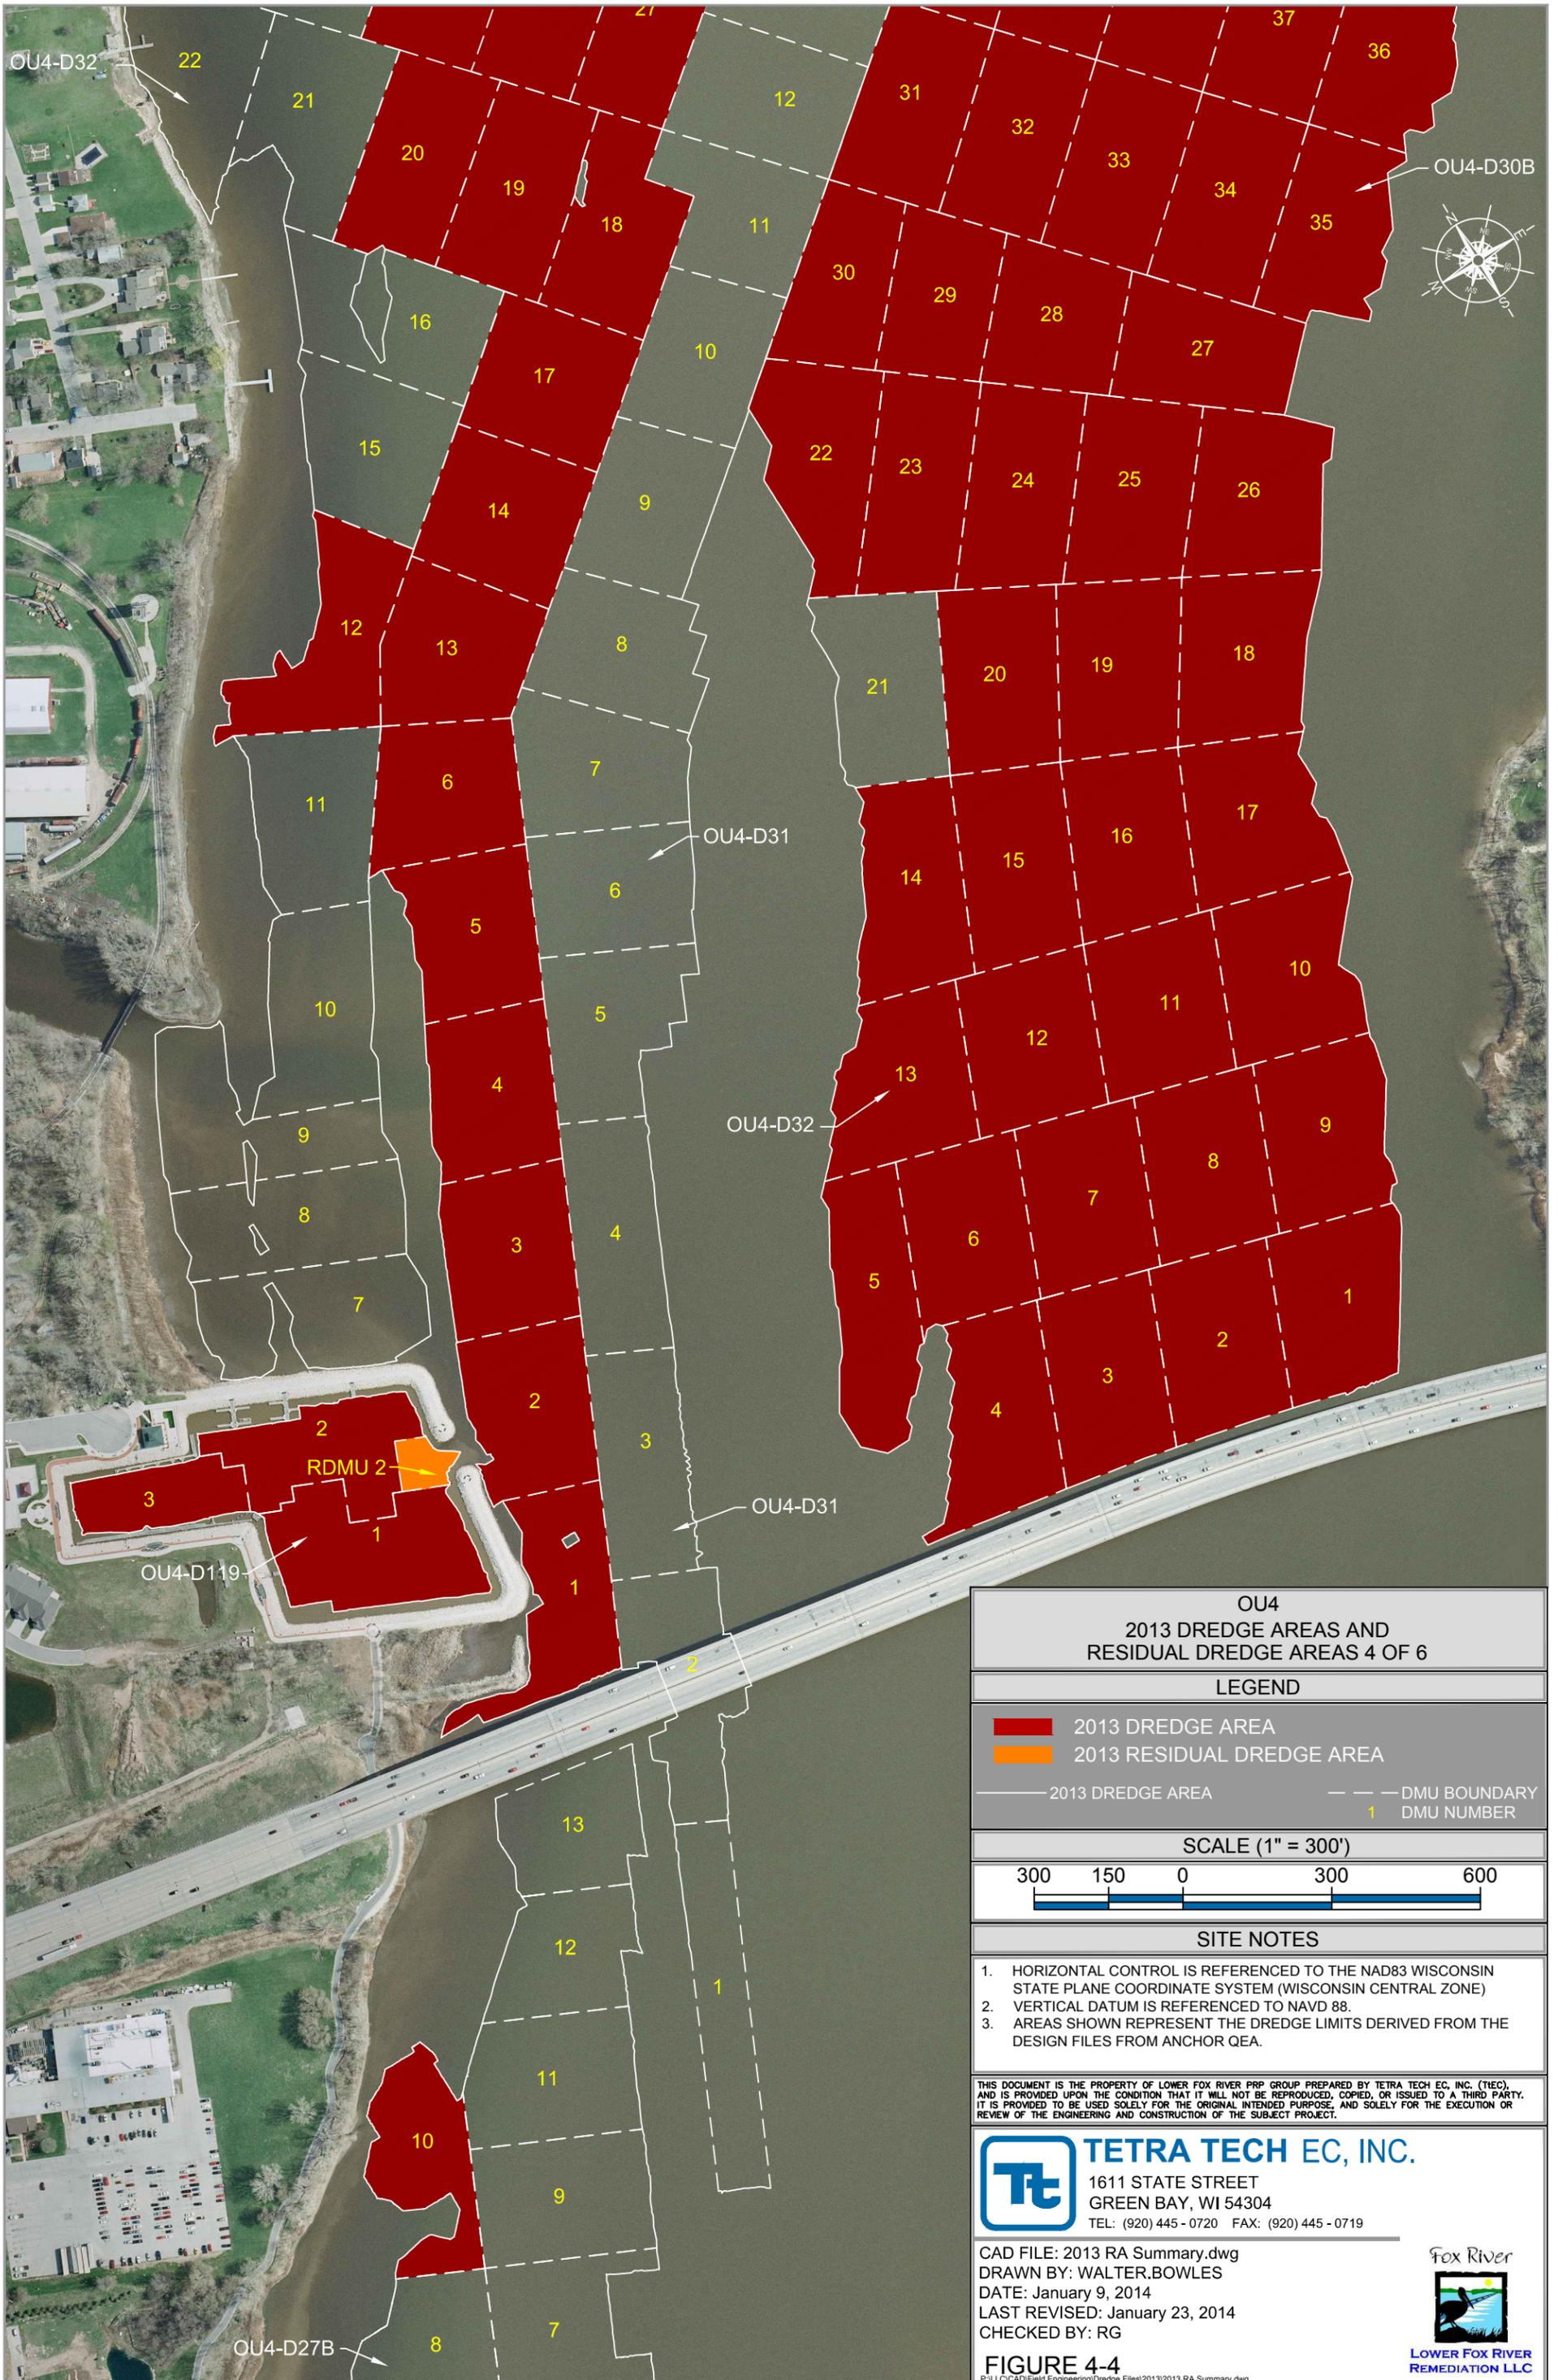

**OU4  
2013 DREDGE AREAS AND  
RESIDUAL DREDGE AREAS 4 OF 6**

**LEGEND**

- 2013 DREDGE AREA
- 2013 RESIDUAL DREDGE AREA
- 2013 DREDGE AREA
- DMU BOUNDARY
- DMU NUMBER

**SCALE (1" = 300')**



**SITE NOTES**


1. HORIZONTAL CONTROL IS REFERENCED TO THE NAD83 WISCONSIN STATE PLANE COORDINATE SYSTEM (WISCONSIN CENTRAL ZONE)
2. VERTICAL DATUM IS REFERENCED TO NAVD 88.
3. AREAS SHOWN REPRESENT THE DREDGE LIMITS DERIVED FROM THE DESIGN FILES FROM ANCHOR QEA.


THIS DOCUMENT IS THE PROPERTY OF LOWER FOX RIVER PPP GROUP PREPARED BY TETRA TECH EC, INC. (TTEC), AND IS PROVIDED UPON THE CONDITION THAT IT WILL NOT BE REPRODUCED, COPIED, OR ISSUED TO A THIRD PARTY. IT IS PROVIDED TO BE USED SOLELY FOR THE ORIGINAL INTENDED PURPOSE, AND SOLELY FOR THE EXECUTION OR REVIEW OF THE ENGINEERING AND CONSTRUCTION OF THE SUBJECT PROJECT.

**TETRA TECH EC, INC.**  
 1611 STATE STREET  
 GREEN BAY, WI 54304  
 TEL: (920) 445-0720 FAX: (920) 445-0719

CAD FILE: 2013 RA Summary.dwg  
 DRAWN BY: WALTER.BOWLES  
 DATE: January 9, 2014  
 LAST REVISED: January 23, 2014  
 CHECKED BY: RG



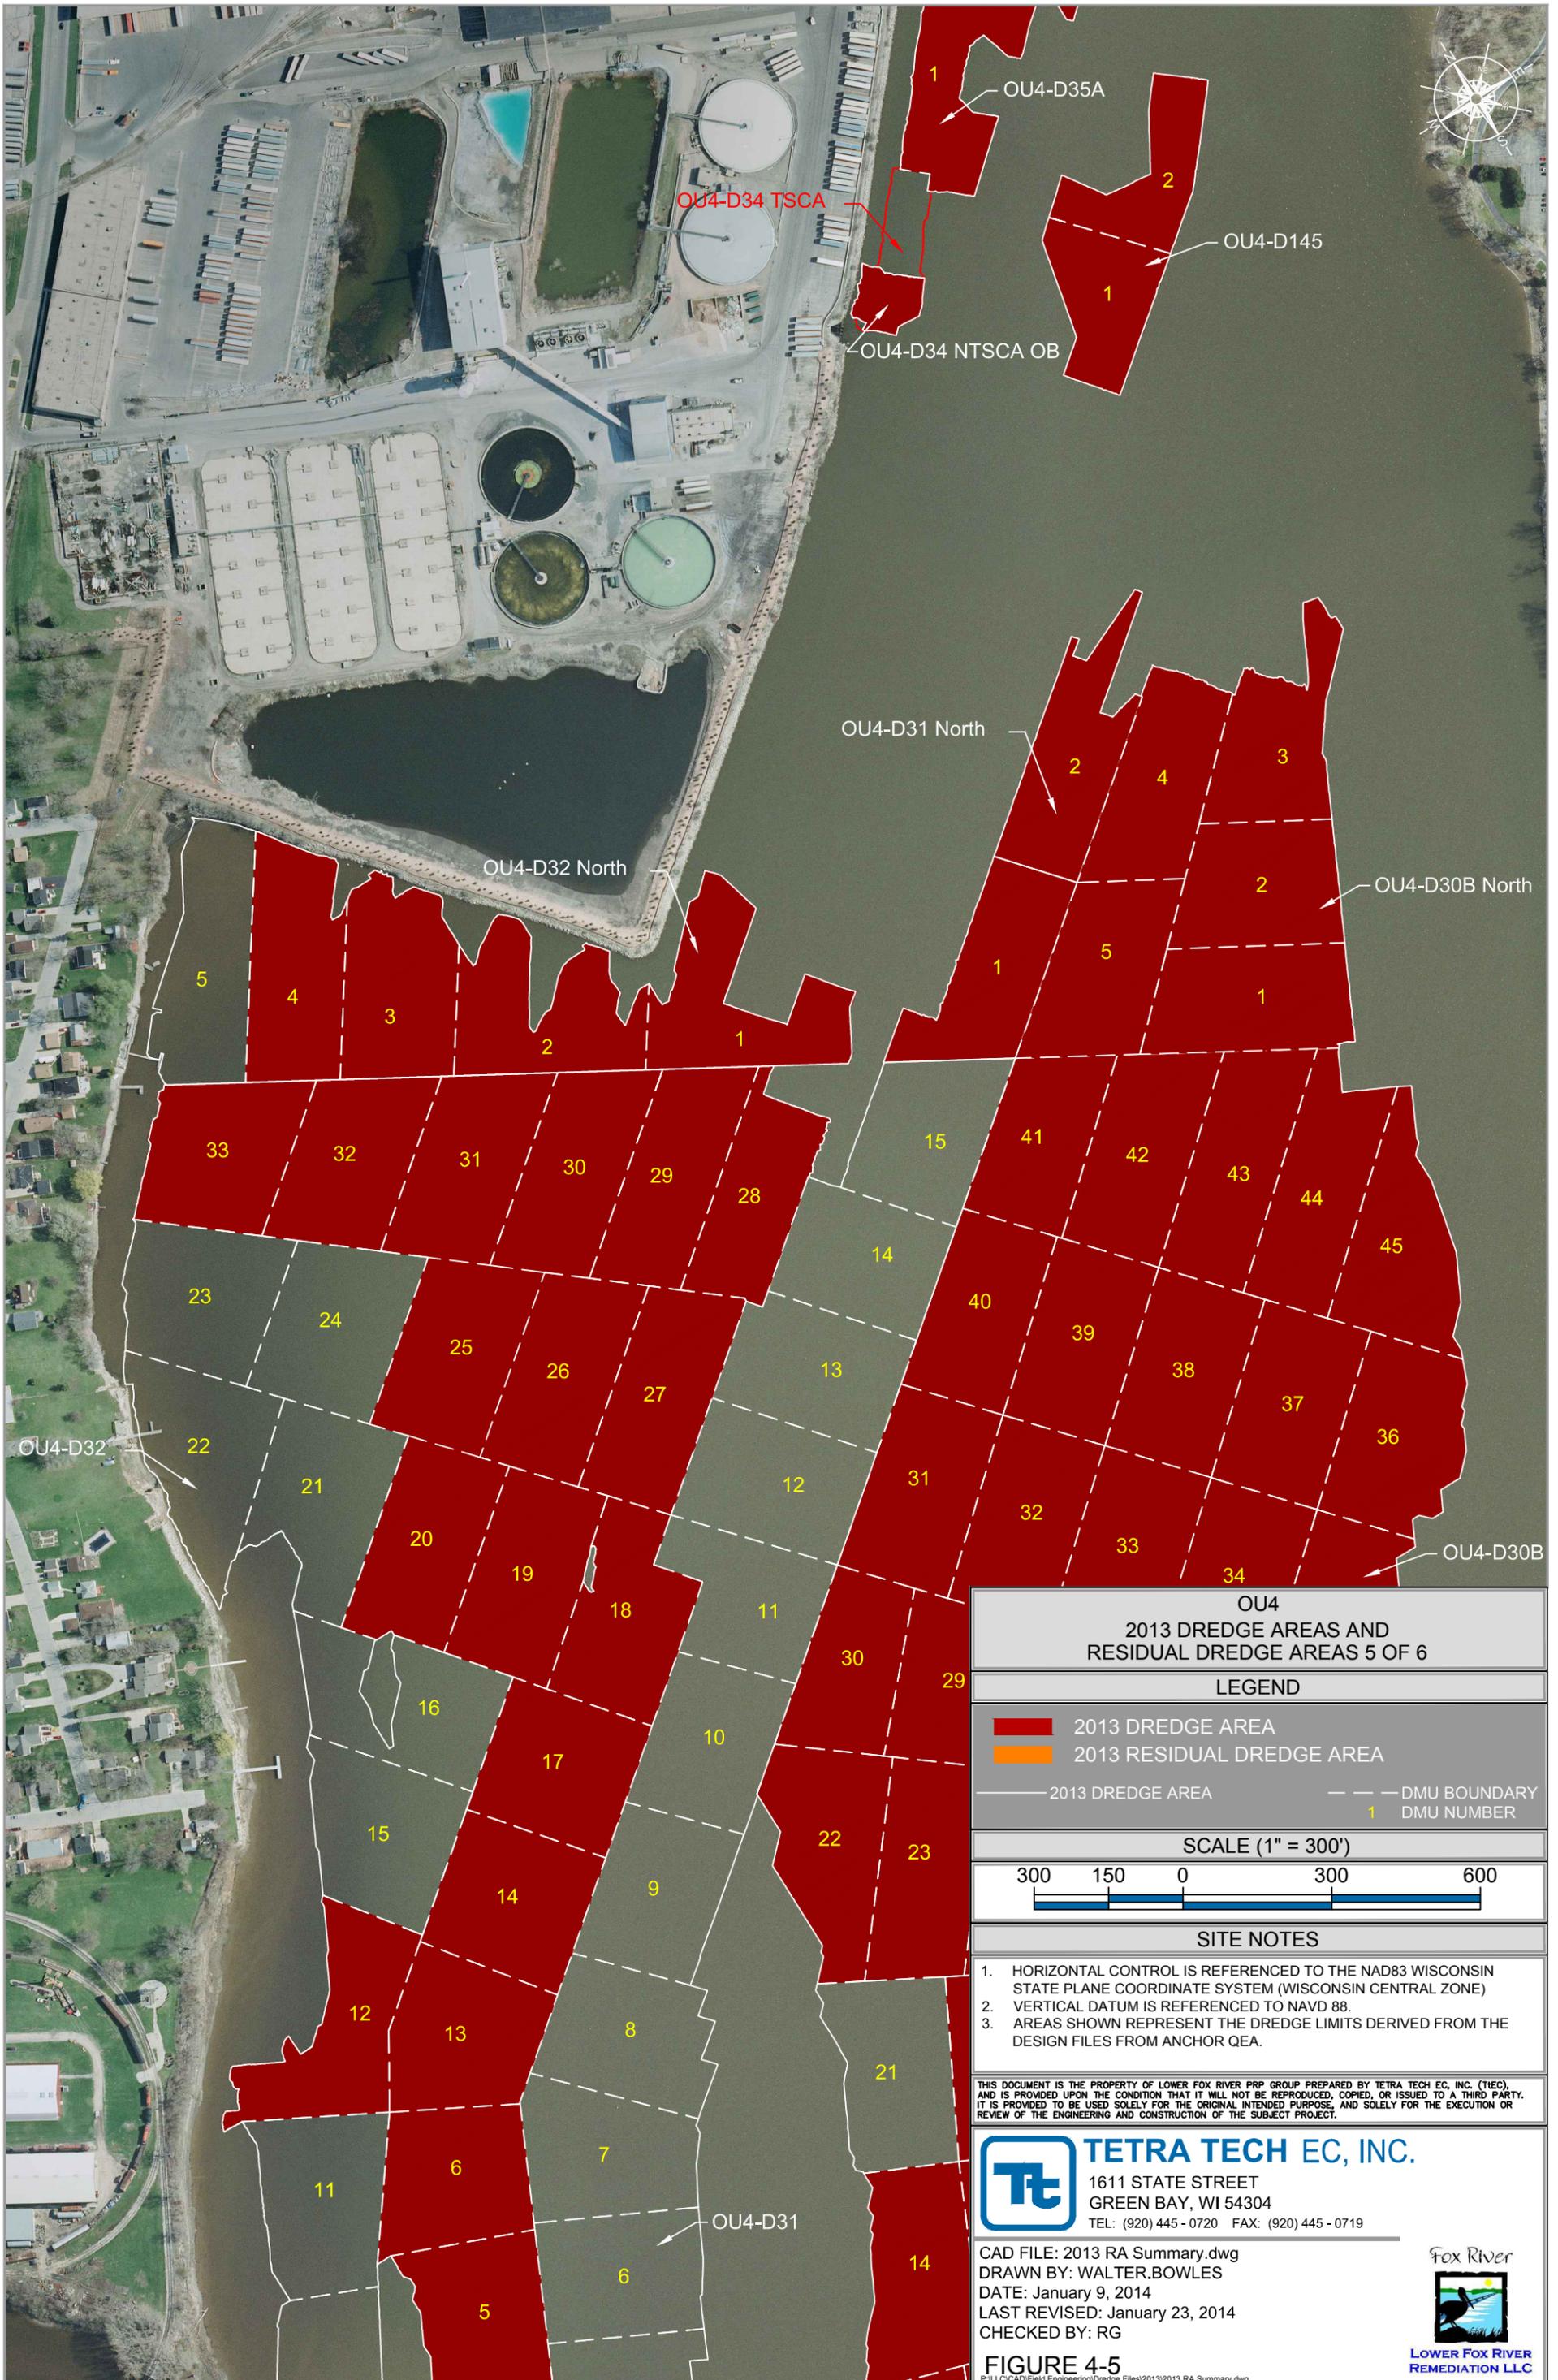


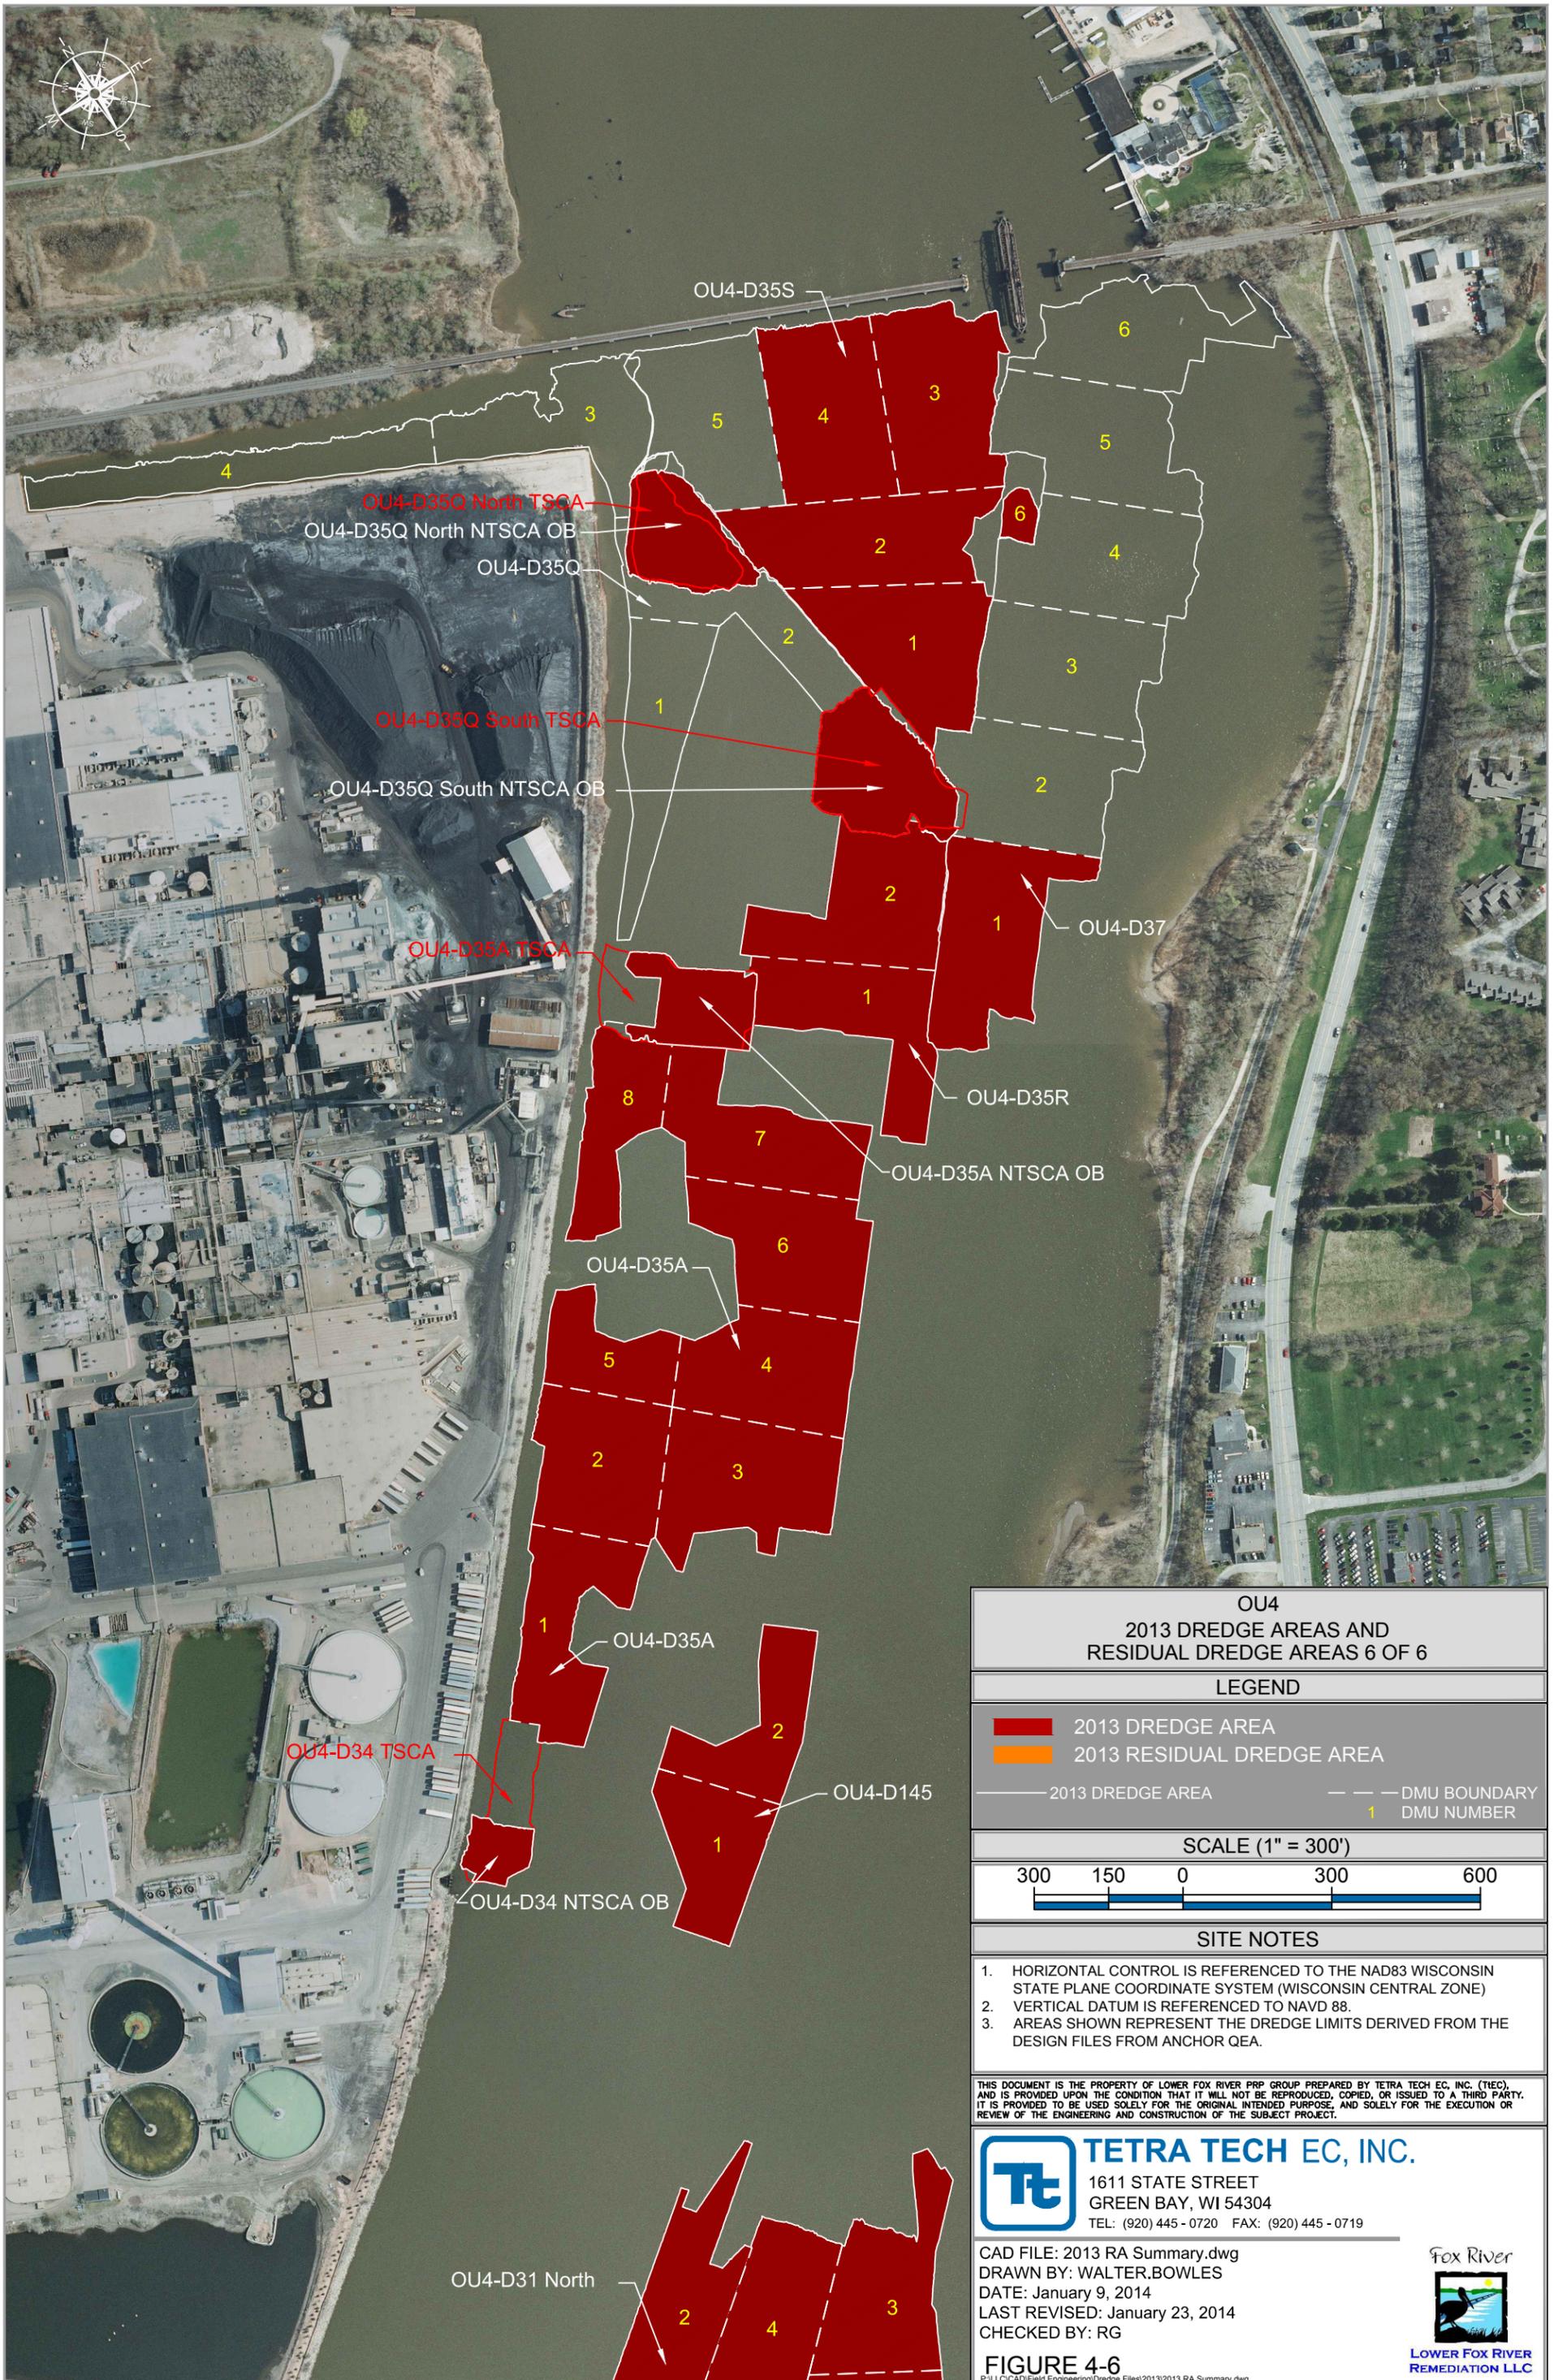

**OU4  
2013 DREDGE AREAS AND  
RESIDUAL DREDGE AREAS 6 OF 6**

**LEGEND**

- 2013 DREDGE AREA
- 2013 RESIDUAL DREDGE AREA
- 2013 DREDGE AREA
- DMU BOUNDARY
- DMU NUMBER

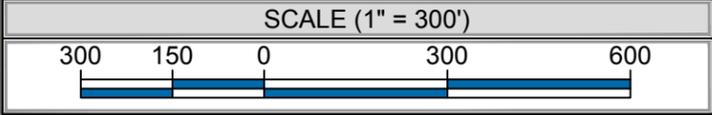

**SITE NOTES**

1. HORIZONTAL CONTROL IS REFERENCED TO THE NAD83 WISCONSIN STATE PLANE COORDINATE SYSTEM (WISCONSIN CENTRAL ZONE)
2. VERTICAL DATUM IS REFERENCED TO NAVD 88.
3. AREAS SHOWN REPRESENT THE DREDGE LIMITS DERIVED FROM THE DESIGN FILES FROM ANCHOR QEA.

THIS DOCUMENT IS THE PROPERTY OF LOWER FOX RIVER PPP GROUP PREPARED BY TETRA TECH EC, INC. (TTEC), AND IS PROVIDED UPON THE CONDITION THAT IT WILL NOT BE REPRODUCED, COPIED, OR ISSUED TO A THIRD PARTY. IT IS PROVIDED FOR THE ORIGINAL INTENDED PURPOSE, AND SOLELY FOR THE EXECUTION OR REVIEW OF THE ENGINEERING AND CONSTRUCTION OF THE SUBJECT PROJECT.

**TETRA TECH EC, INC.**  
 1611 STATE STREET  
 GREEN BAY, WI 54304  
 TEL: (920) 445-0720 FAX: (920) 445-0719

CAD FILE: 2013 RA Summary.dwg  
 DRAWN BY: WALTER.BOWLES  
 DATE: January 9, 2014  
 LAST REVISED: January 23, 2014  
 CHECKED BY: RG









SC35Q North TSCA

SC35A TSCA


SC34 TSCA

**OU4  
2013 SAND COVER AND  
RESIDUAL SAND COVER AREAS 3 OF 3**

**LEGEND**

- 2013 SAND COVER AREAS
- 2013 RESIDUAL SAND COVER AREAS

**SCALE (1" = 300')**

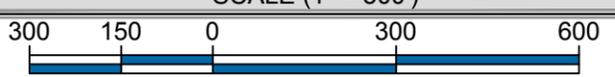

**SITE NOTES**

1. HORIZONTAL CONTROL IS REFERENCED TO THE NAD83 WISCONSIN STATE PLANE COORDINATE SYSTEM (WISCONSIN CENTRAL ZONE)
2. VERTICAL DATUM IS REFERENCED TO NAVD 88.
3. AREAS SHOWN REPRESENT THE AS-BUILT LIMITS OF THE SPREADER LANES AND SAND COVER PLACEMENT.

THIS DOCUMENT IS THE PROPERTY OF LOWER FOX RIVER PRP GROUP PREPARED BY TETRA TECH EC, INC. (TTEC), AND IS PROVIDED UPON THE CONDITION THAT IT WILL NOT BE REPRODUCED, COPIED, OR ISSUED TO A THIRD PARTY. IT IS PROVIDED TO BE USED SOLELY FOR THE ORIGINAL INTENDED PURPOSE, AND SOLELY FOR THE EXECUTION OR REVIEW OF THE ENGINEERING AND CONSTRUCTION OF THE SUBJECT PROJECT.




**TETRA TECH EC, INC.**  
1611 STATE STREET  
GREEN BAY, WI 54304  
TEL: (920) 445 - 0720 FAX: (920) 445 - 0719

CAD FILE: 2013 RA Summary.dwg  
DRAWN BY: WALTER.BOWLES  
DATE: January 9, 2014  
LAST REVISED: January 23, 2014  
CHECKED BY: RG

**FIGURE 10-3**

P:\LLC\CAD\Field Engineering\Dredge Files\2013\2013 RA Summary.dwg



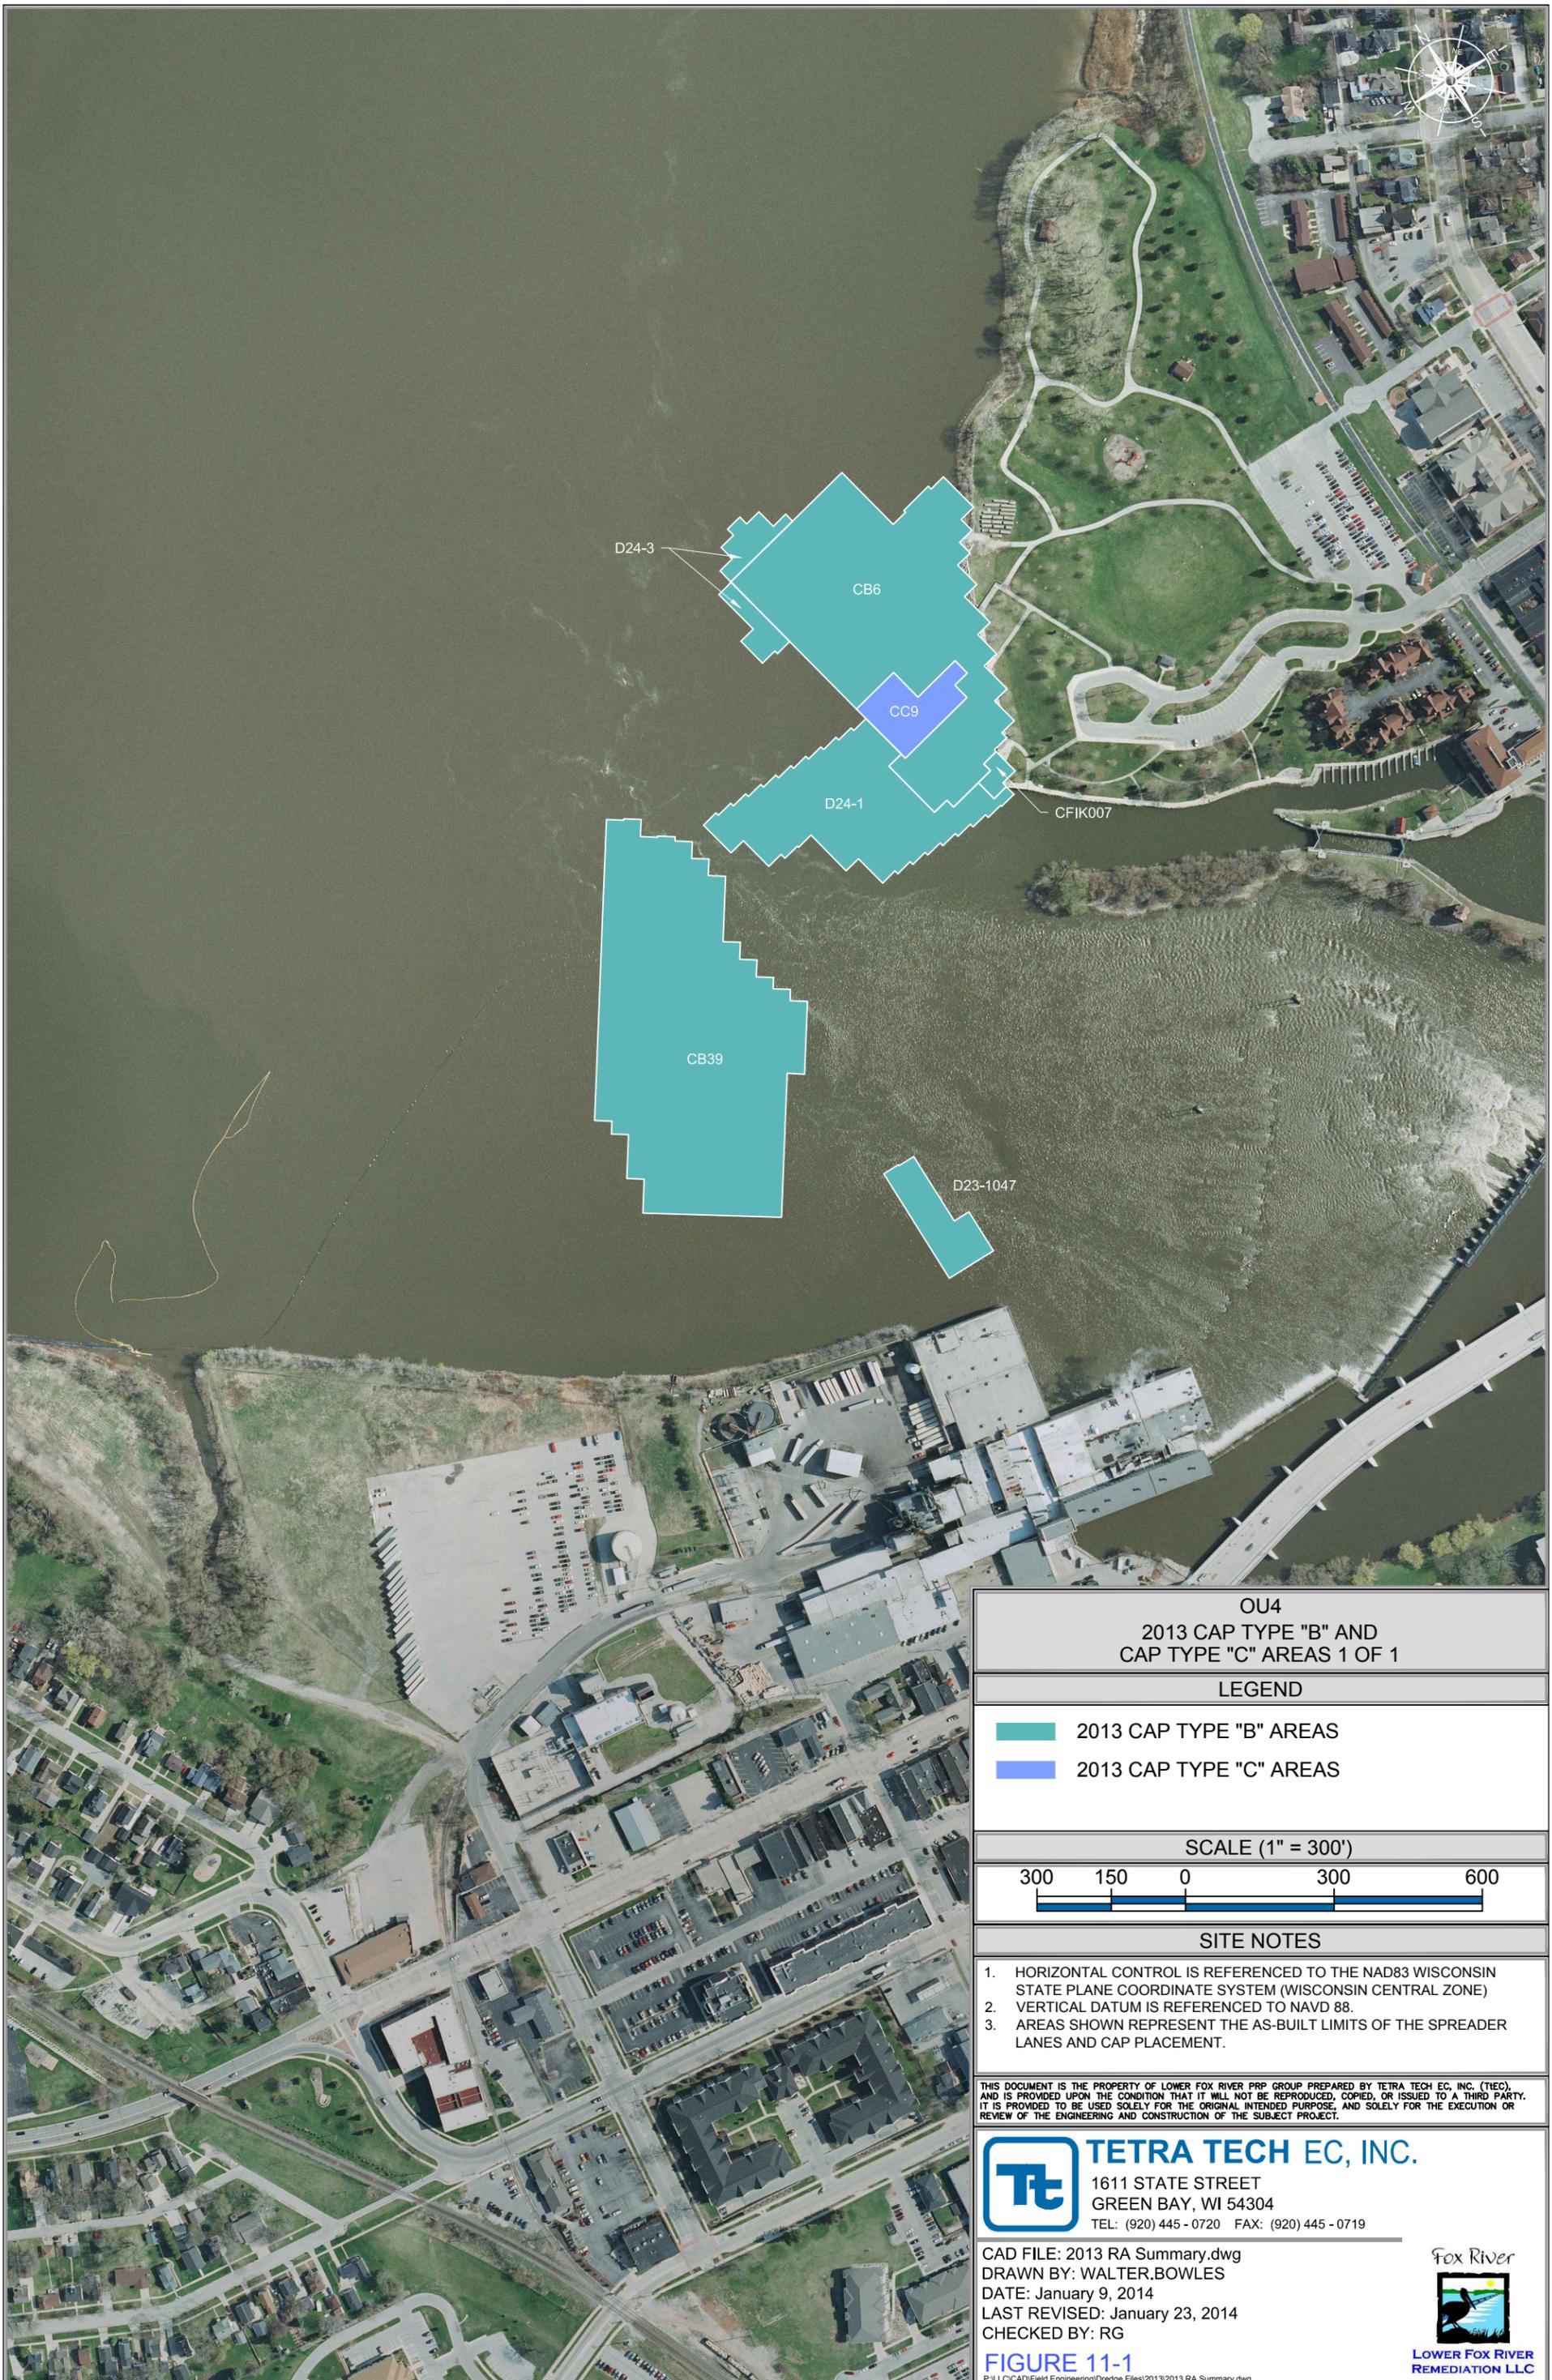

**OU4  
2013 CAP TYPE "B" AND  
CAP TYPE "C" AREAS 1 OF 1**

**LEGEND**

- 2013 CAP TYPE "B" AREAS
- 2013 CAP TYPE "C" AREAS

**SCALE (1" = 300')**



**SITE NOTES**

1. HORIZONTAL CONTROL IS REFERENCED TO THE NAD83 WISCONSIN STATE PLANE COORDINATE SYSTEM (WISCONSIN CENTRAL ZONE)
2. VERTICAL DATUM IS REFERENCED TO NAVD 88.
3. AREAS SHOWN REPRESENT THE AS-BUILT LIMITS OF THE SPREADER LANES AND CAP PLACEMENT.

THIS DOCUMENT IS THE PROPERTY OF LOWER FOX RIVER PRP GROUP PREPARED BY TETRA TECH EC, INC. (TTEC), AND IS PROVIDED UPON THE CONDITION THAT IT WILL NOT BE REPRODUCED, COPIED, OR ISSUED TO A THIRD PARTY. IT IS PROVIDED TO BE USED SOLELY FOR THE ORIGINAL INTENDED PURPOSE, AND SOLELY FOR THE EXECUTION OR REVIEW OF THE ENGINEERING AND CONSTRUCTION OF THE SUBJECT PROJECT.



**TETRA TECH EC, INC.**  
1611 STATE STREET  
GREEN BAY, WI 54304  
TEL: (920) 445 - 0720 FAX: (920) 445 - 0719

CAD FILE: 2013 RA Summary.dwg  
DRAWN BY: WALTER.BOWLES  
DATE: January 9, 2014  
LAST REVISED: January 23, 2014  
CHECKED BY: RG

**FIGURE 11-1**

P:\LLCCAD\Field Engineering\Dredge Files\2013\2013 RA Summary.dwg

